

"Helleland"

Ex.

Burford Bridge

Lon Rpt No 84664

Pumping



© 2019

W295-0216

Lloyd's Register
Foundation

23/9/21

— PUMPING PLAN —

3/8 BURFORD BRIDGE.


RENNIE, RITCHIE & NEWPORT
SHIPBUILDING COMPANY LTD.,

REF N^o 10012

DATE

SHIPBUILDING DEPARTMENT.

G-9-21

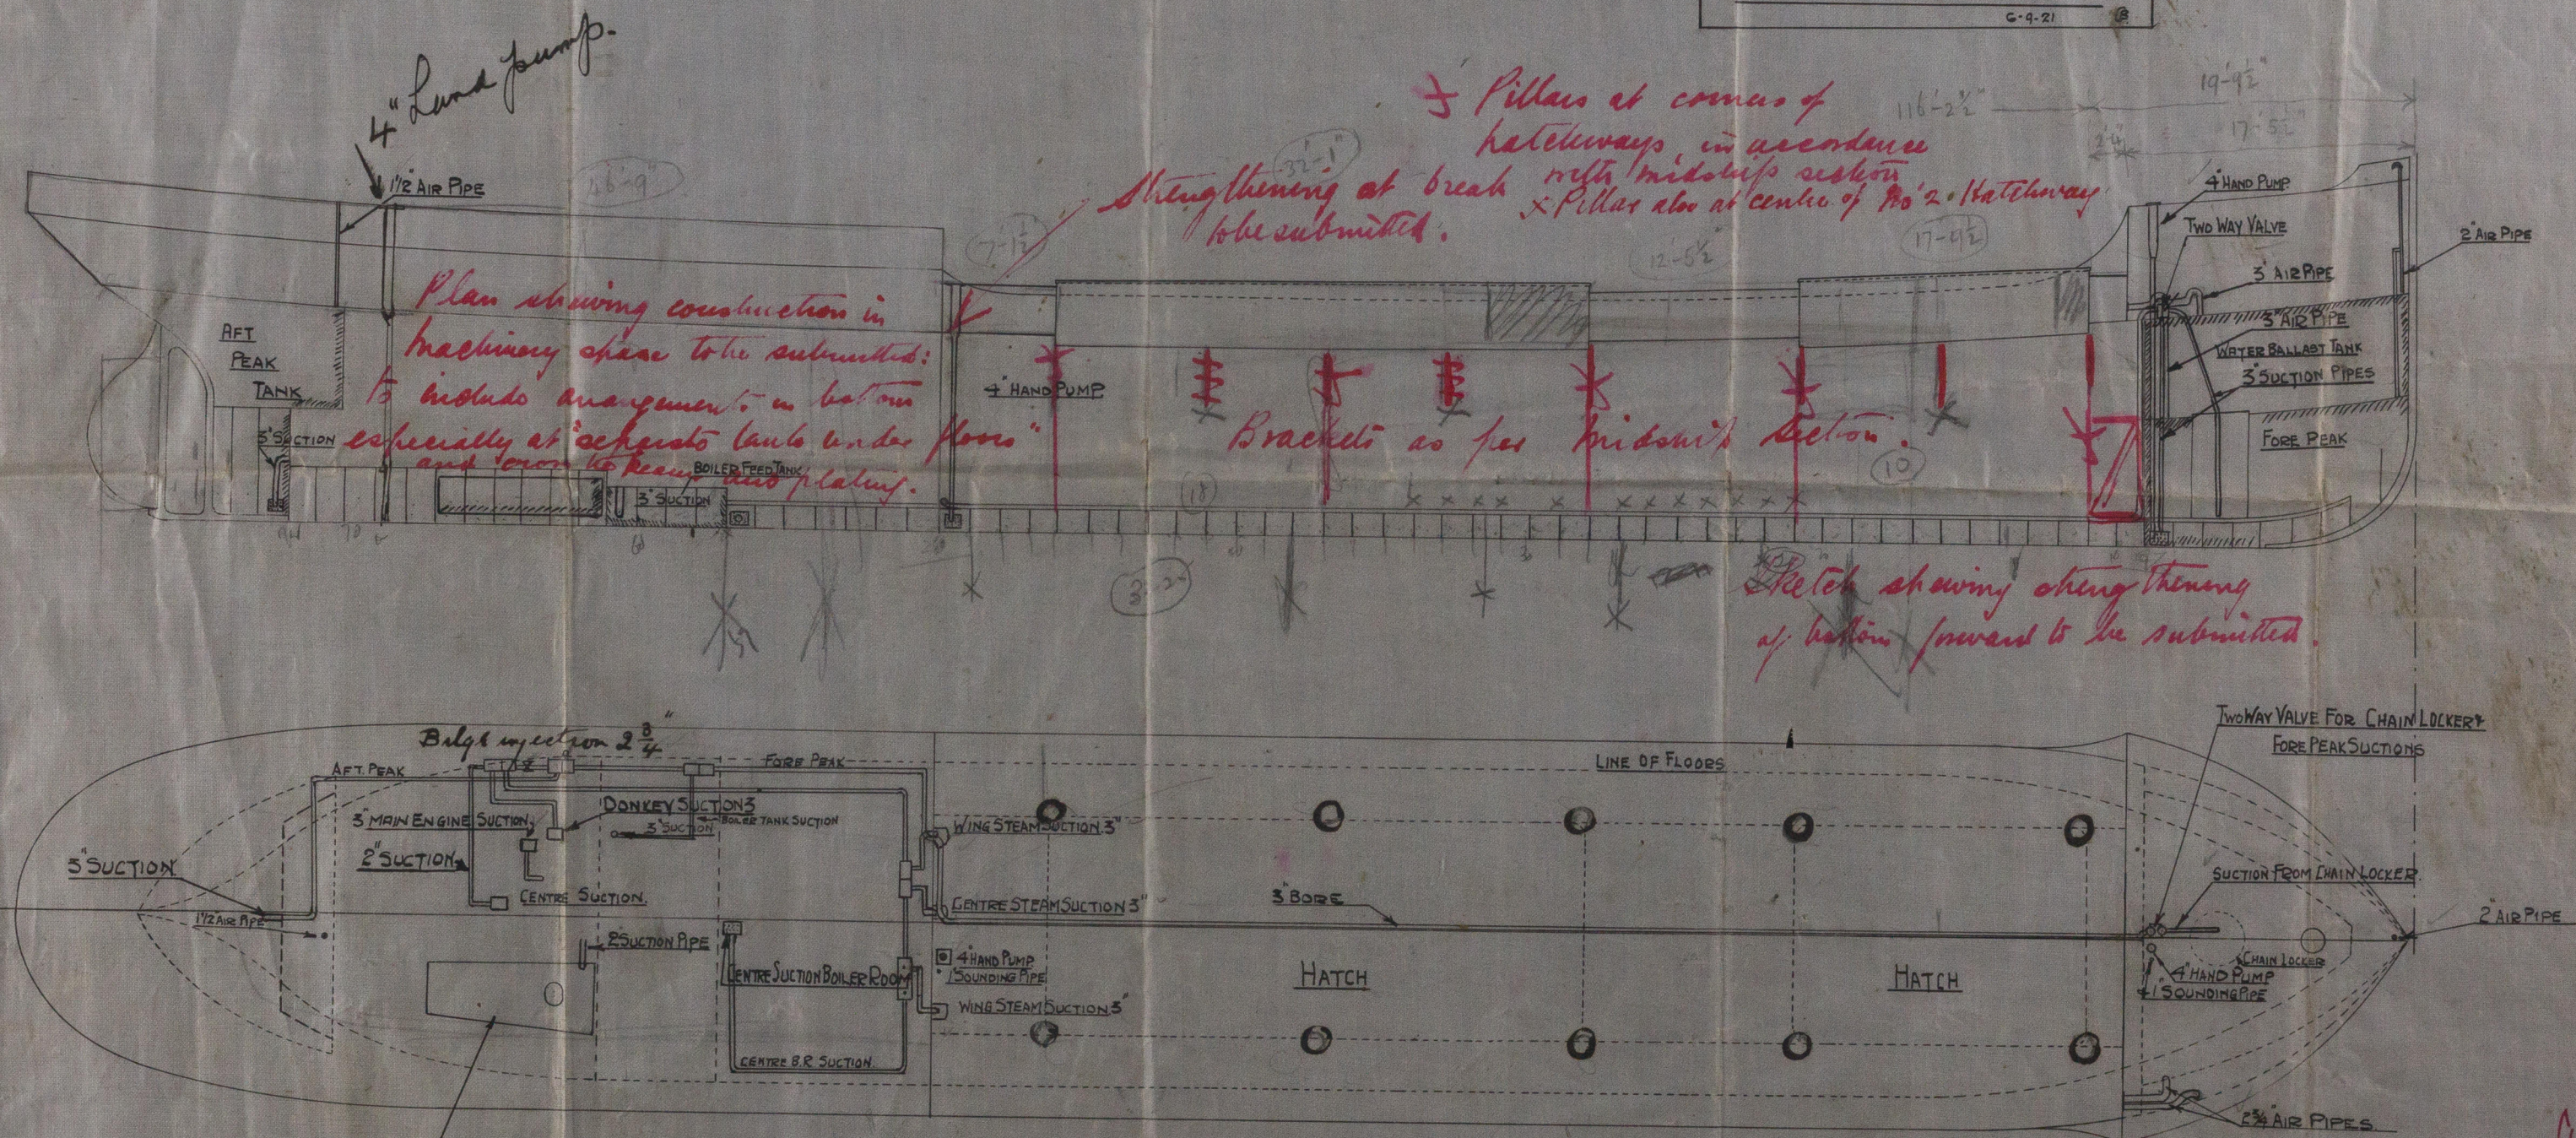

SEPARATE TANK UNDER FLOORS

This tank is an exhaust tank laid on floors

A.B.F.

Stanchions
A.B.F.

A.B.F.
29.9.21

A.B.F.
22.9.21



© 2019

Lloyd's Register
Foundation

W295-0216