


PLATES 11\"/>



The Flash Point of the Oil Fuel
 to be carried should be not lower
 than 150° F. and the requirements
 of Sections 20 and 35 of the Rules
 should be complied with.

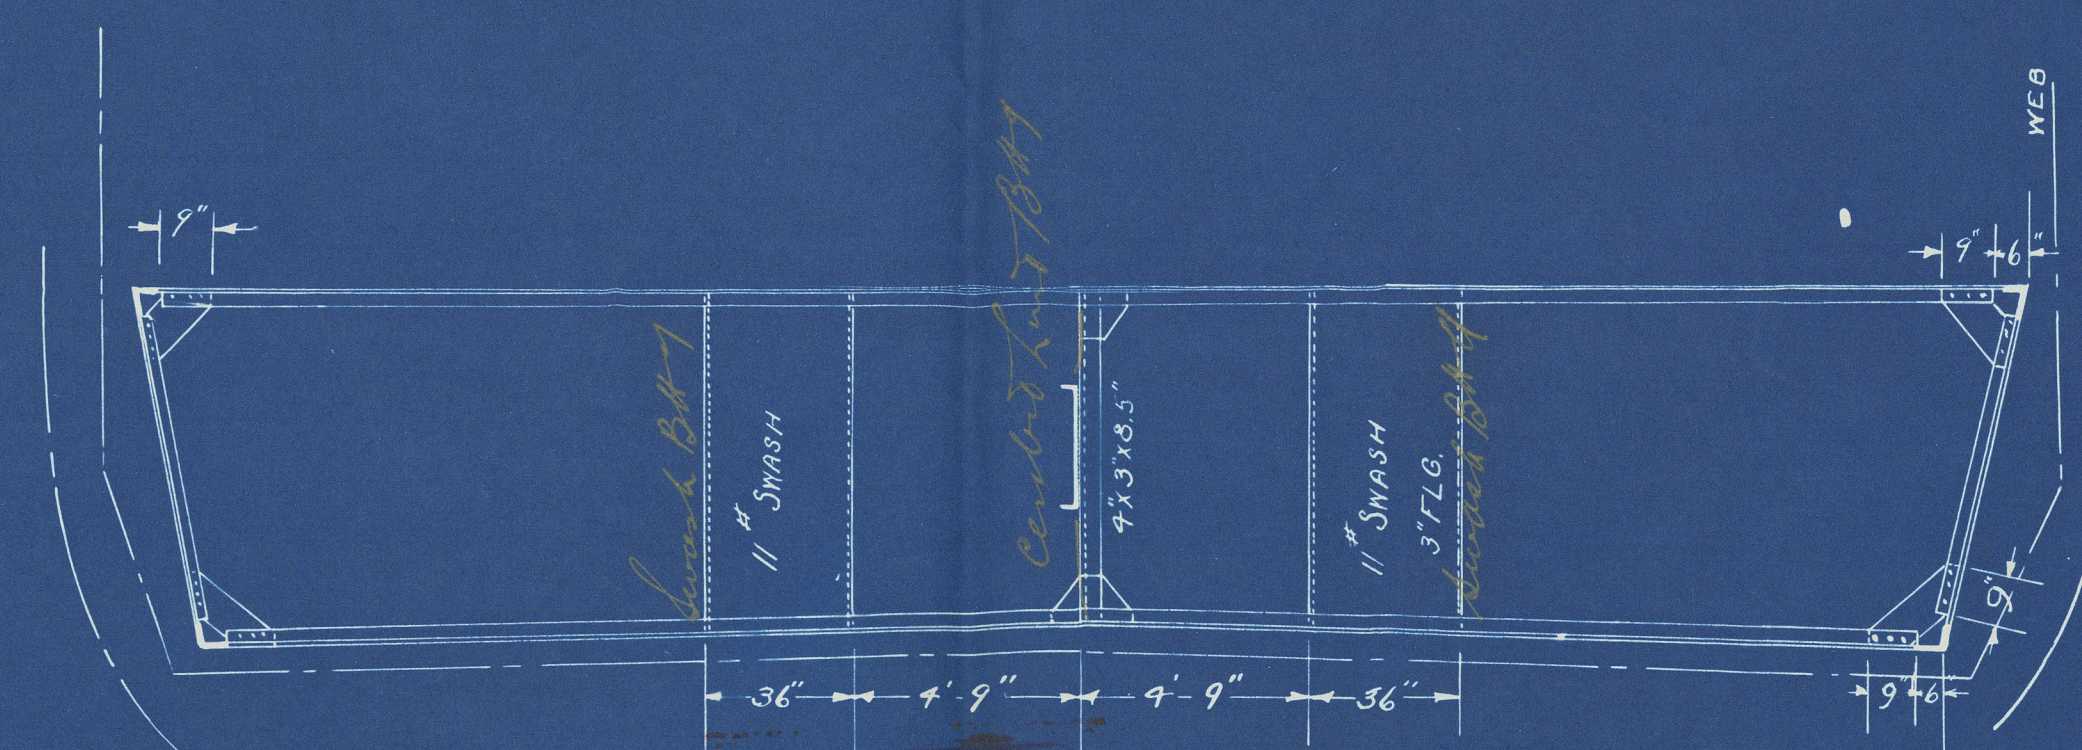

Johnich

Londan Copy

RECONSTRUCTION STR "GEORGIAN"
 OIL FUEL TANK
 SCALE 1/4" = 1 FOOT

ST LAWRENCE MARINE REPAIR DOCK CORP.
 OGDENSBURG N.Y. 8-5-33

EDW. N. SMITH

BUFFALO N.Y.

S.S. Bagu State
(ex Fordounian, ex Georgian
ex Yukondoc)

Msl. rept. No. 3886.

Alteration plan.

Oil fuel tank

W297-0281



© 2019

Lloyd's Register
Foundation