

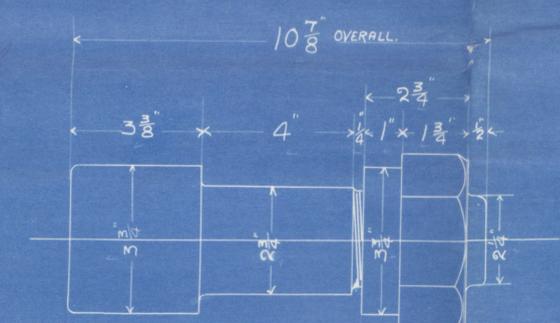
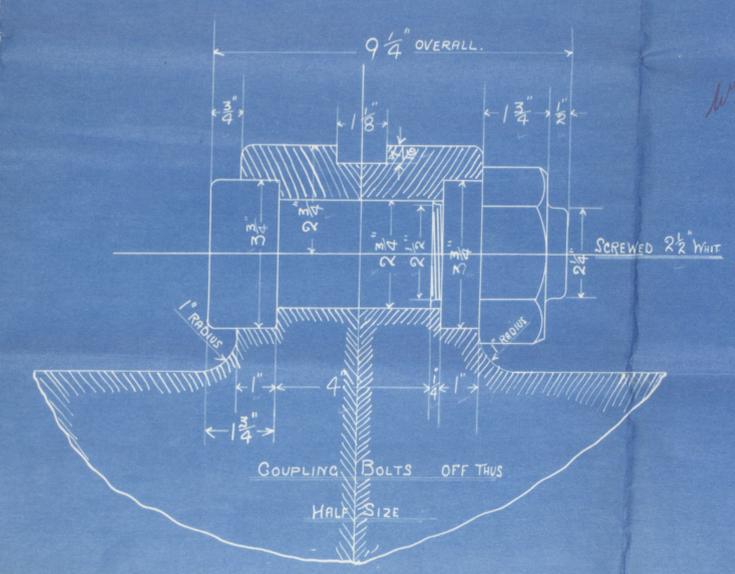
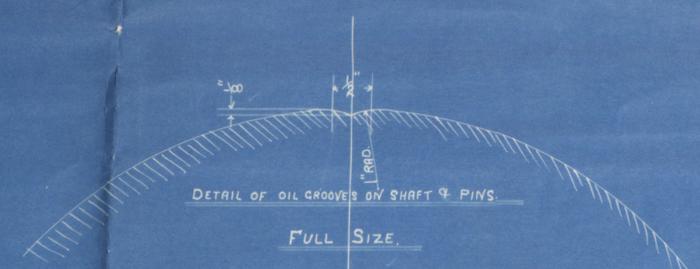


14/11/11

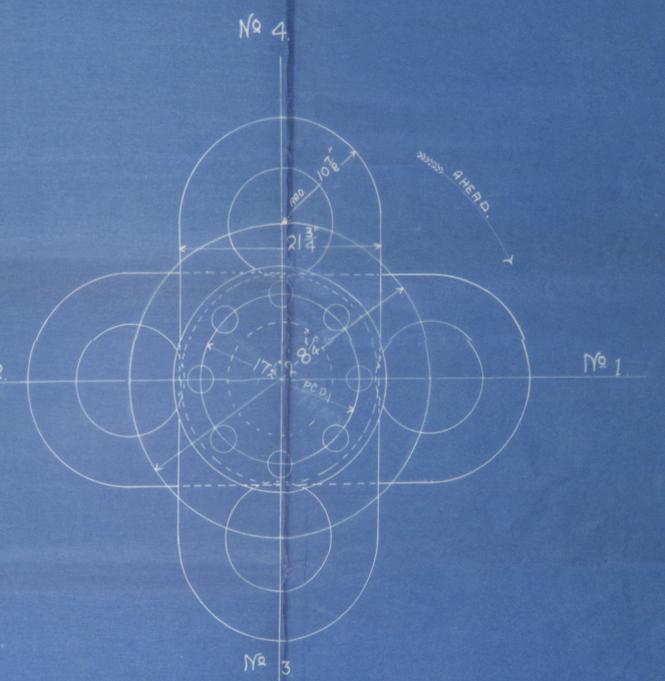

A.P.R.  
13/11/11

D.  
8-11-11.  
W.W. 8/11/11

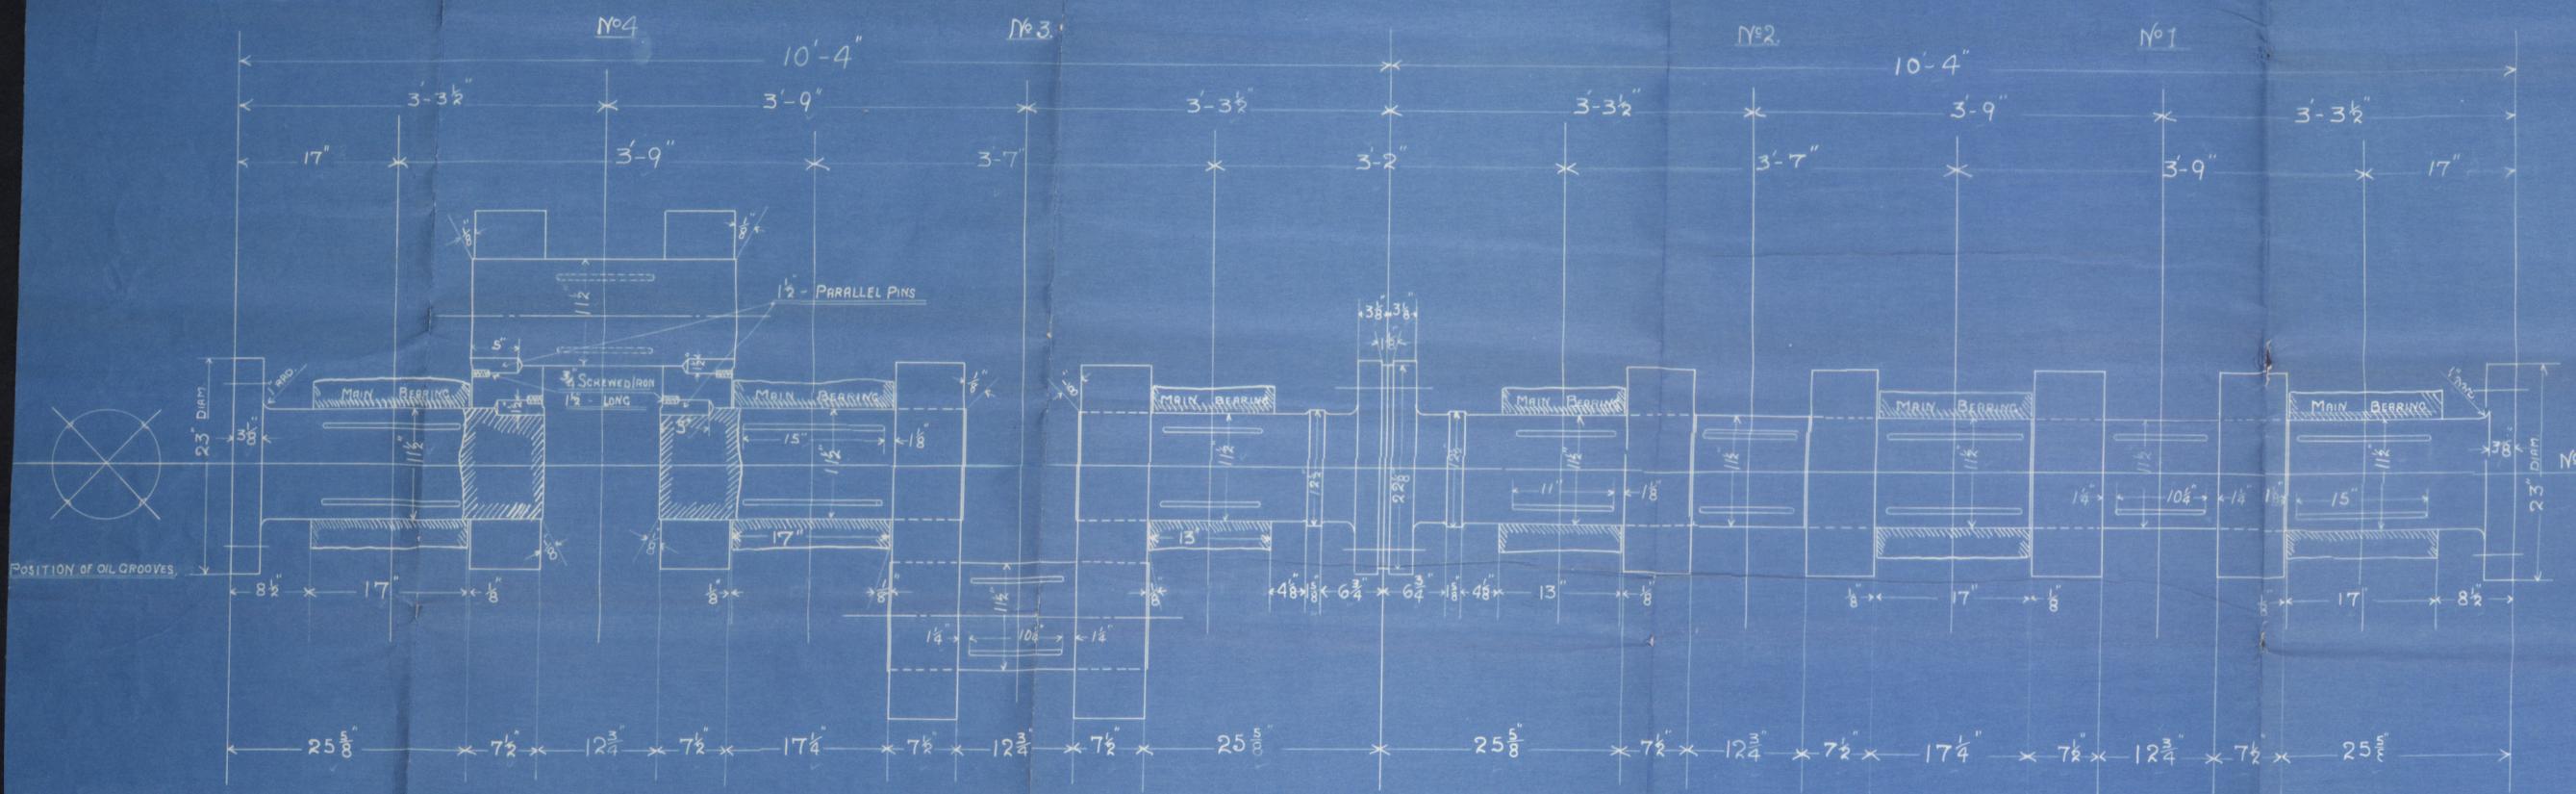

# CRANK SHAFT ENC NO 418

SCALES - 1 1/2" = 1 FOOT  
HALF SIZE & FULL SIZE.

5513

W297-0297 2/2

From

The CLYDE SHIPBUILDING AND ENGINEERING CO., Ltd.,

FOR ENCLOSURE to

Messrs Lloyds Registry  
Greenock

Badger State  
Plan of Crank Shaft  
for

Nessee Engines n<sup>o</sup> ~~418~~ <sup>419</sup>  
for

Clyde Works Coy. n<sup>o</sup> 29841



Oil  
Meters. 8/5 "Londonian"

Greenock Report N<sup>o</sup> 16329

n. n. "Badger State"



© 2019

Lloyd's Register  
Foundation

W2917-02917 42