

SS. EMPIRE MOAT.
E. 4350 DWT COLLIER

ALL ANGLES ARE N.B.S.


PROFILE & DECKS

SCALE 1/8" = 1 FOOT

CLASS LLOYDS & 100 A.1.

DIMS:- LENGTH LWL 312'0" BREADTH MLD 44'3" DEPTH MLD 22'1" U.D.K.
5'0" RQ.D.K.

MASTS WINCHES WINDLASS STEERING GEAR & DECKHOUSES
SUPPORTED TO SURVEYORS SATISFACTION

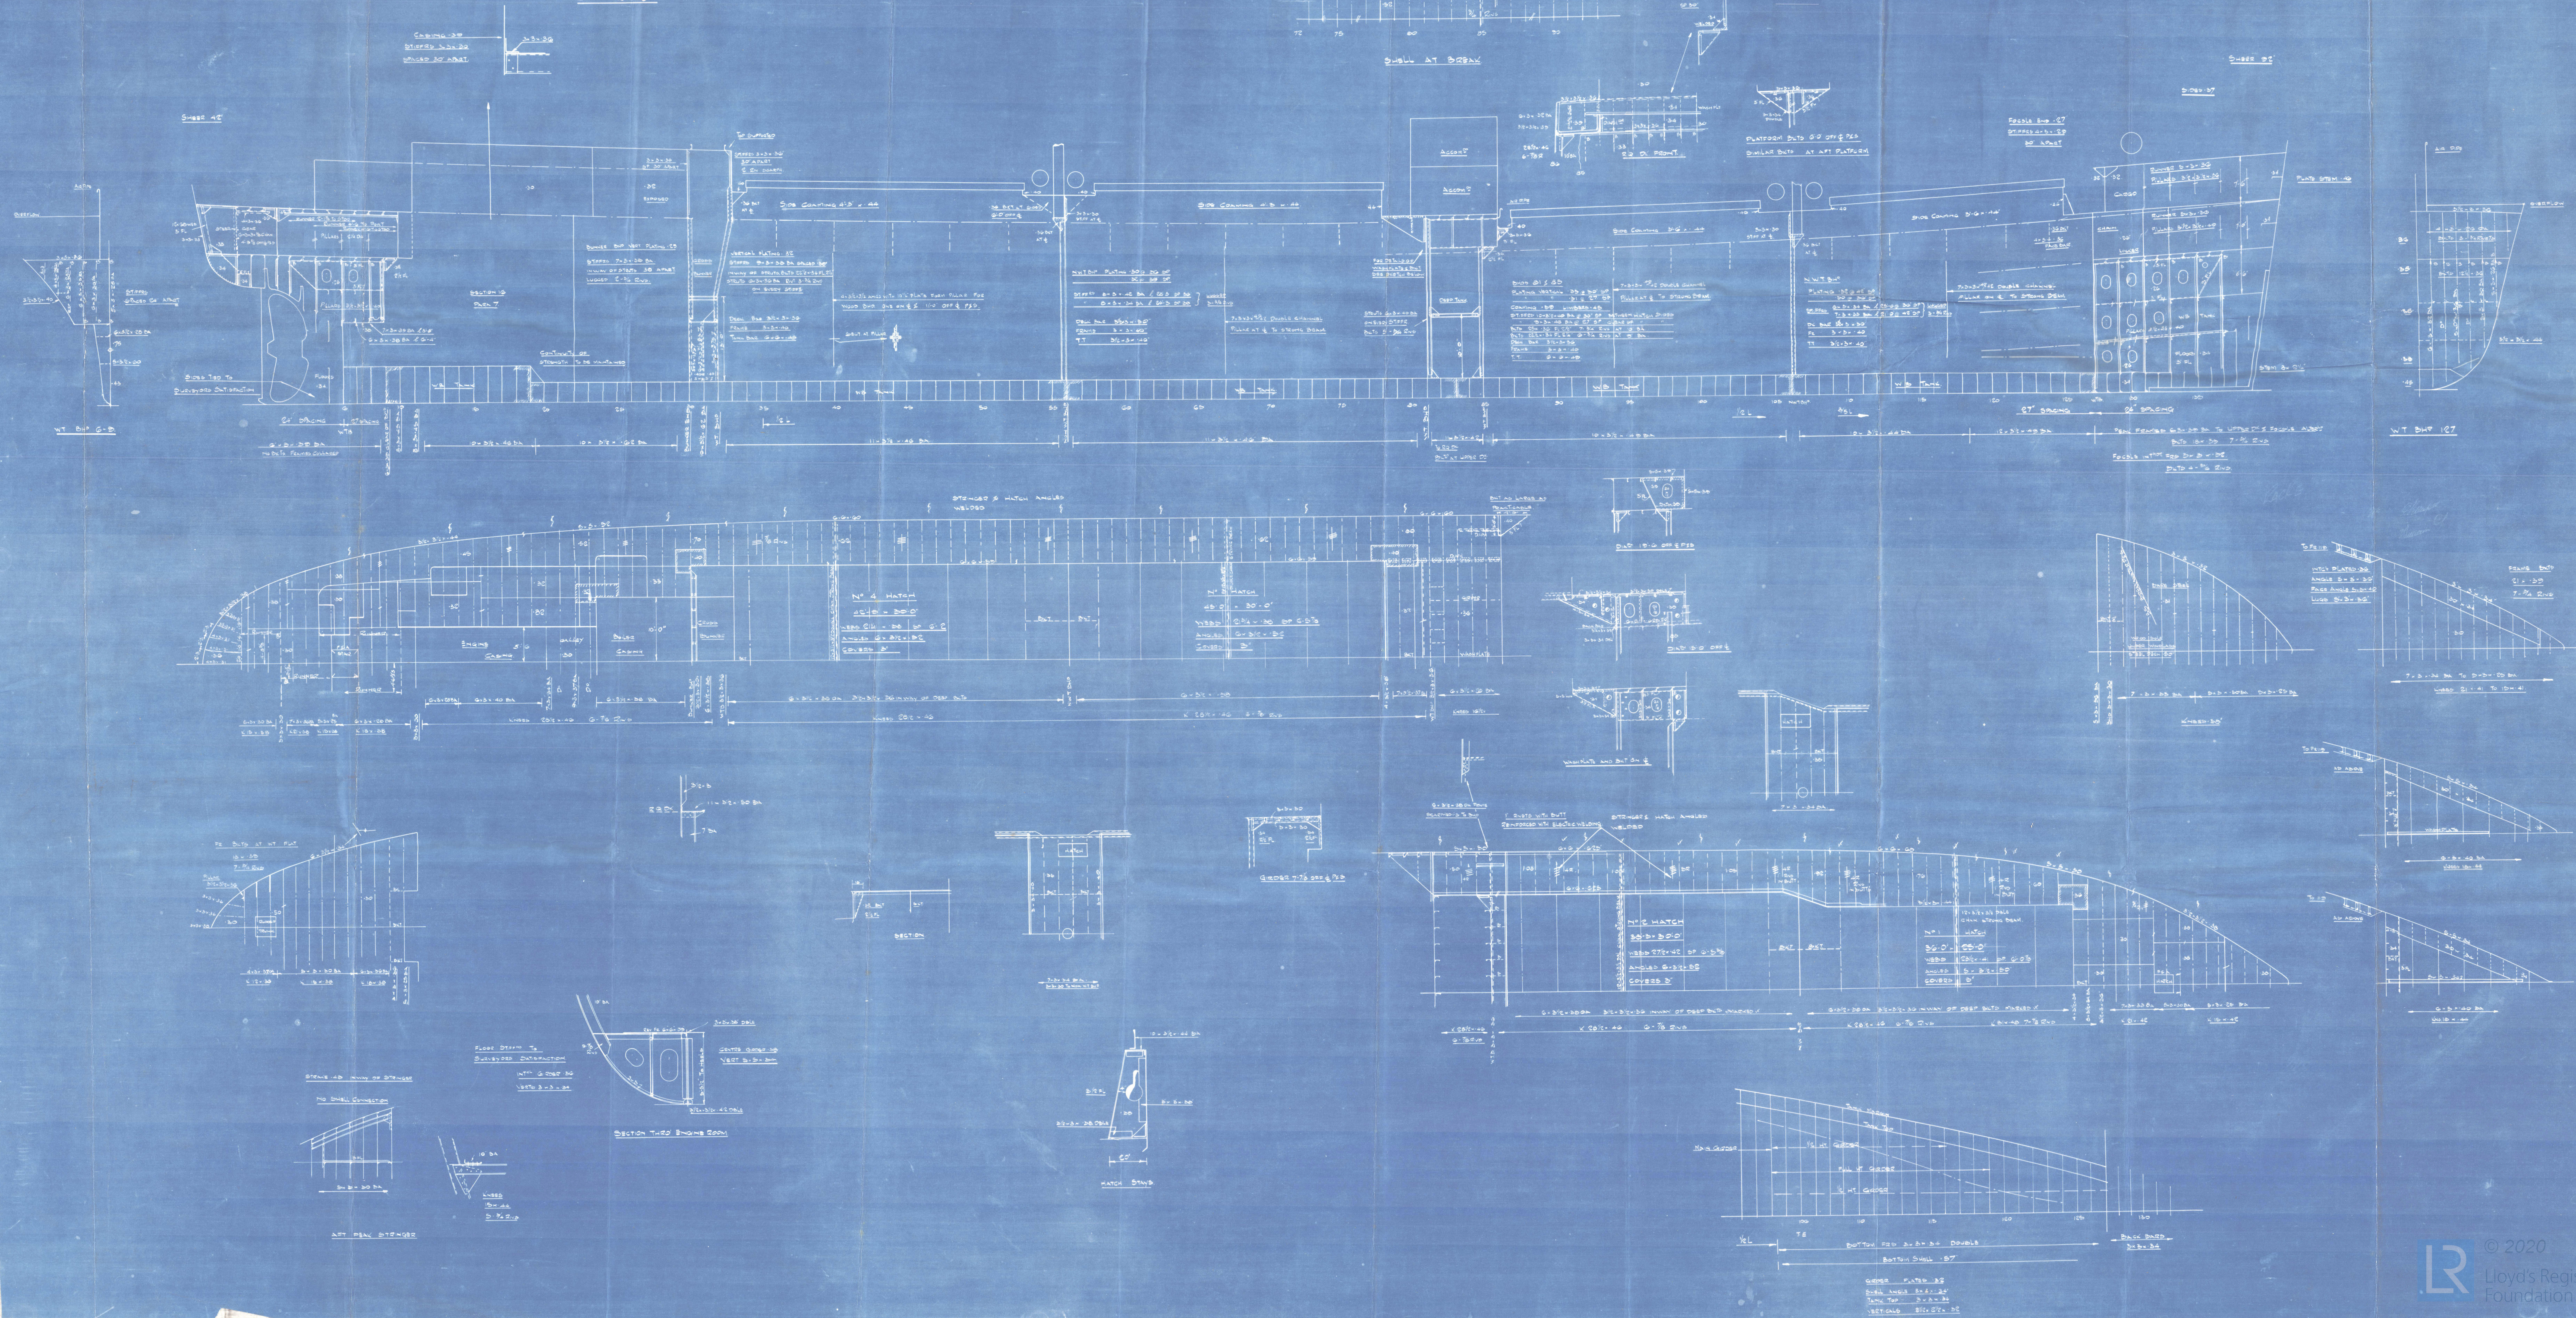

PROFILE & DECKS. (AS BUILT)

LITHGOWS LIMITED

YARD N° 951.

"EMPIRE MOAT"

GREENOCK 1ST ENTRY REPORT N° 21444

W30-0093



© 2020

Lloyd's Register
Foundation