

3.4.14
9.4.14
25.7.14
10.8.14
6.8.15

No 590 55
PROFILE & DECK PLANS

420 x 53-3 x 30-9




TO CLASS 100 AT LLOYDS

SCALE 1/4" = 1 FT

VESSEL IS OF FINE FORM.

Sketch showing head - wheel connections of large pillars to be submitted
PILARS NOT EXCEEDING 4" x 4" RIVETS IN HEAD - 1/2"
OVER 4" AND NOT EXCEEDING 1" x 1" RIVETS IN HEAD - 1/2"
OVER 1" AND NOT EXCEEDING 1 1/2" x 1 1/2" RIVETS IN HEAD - 1/2"
OVER 1 1/2" AND NOT EXCEEDING 2" x 2" RIVETS IN HEAD - 1/2"
LOCAL STIFFENING UNDER WINGET VIBES, ETC TO SUFFICIENT STIFFENING

Note -
Note looking by to sides to be fitted at
alternating beams with intermediate angle
beams in.
All to improve perfection.

  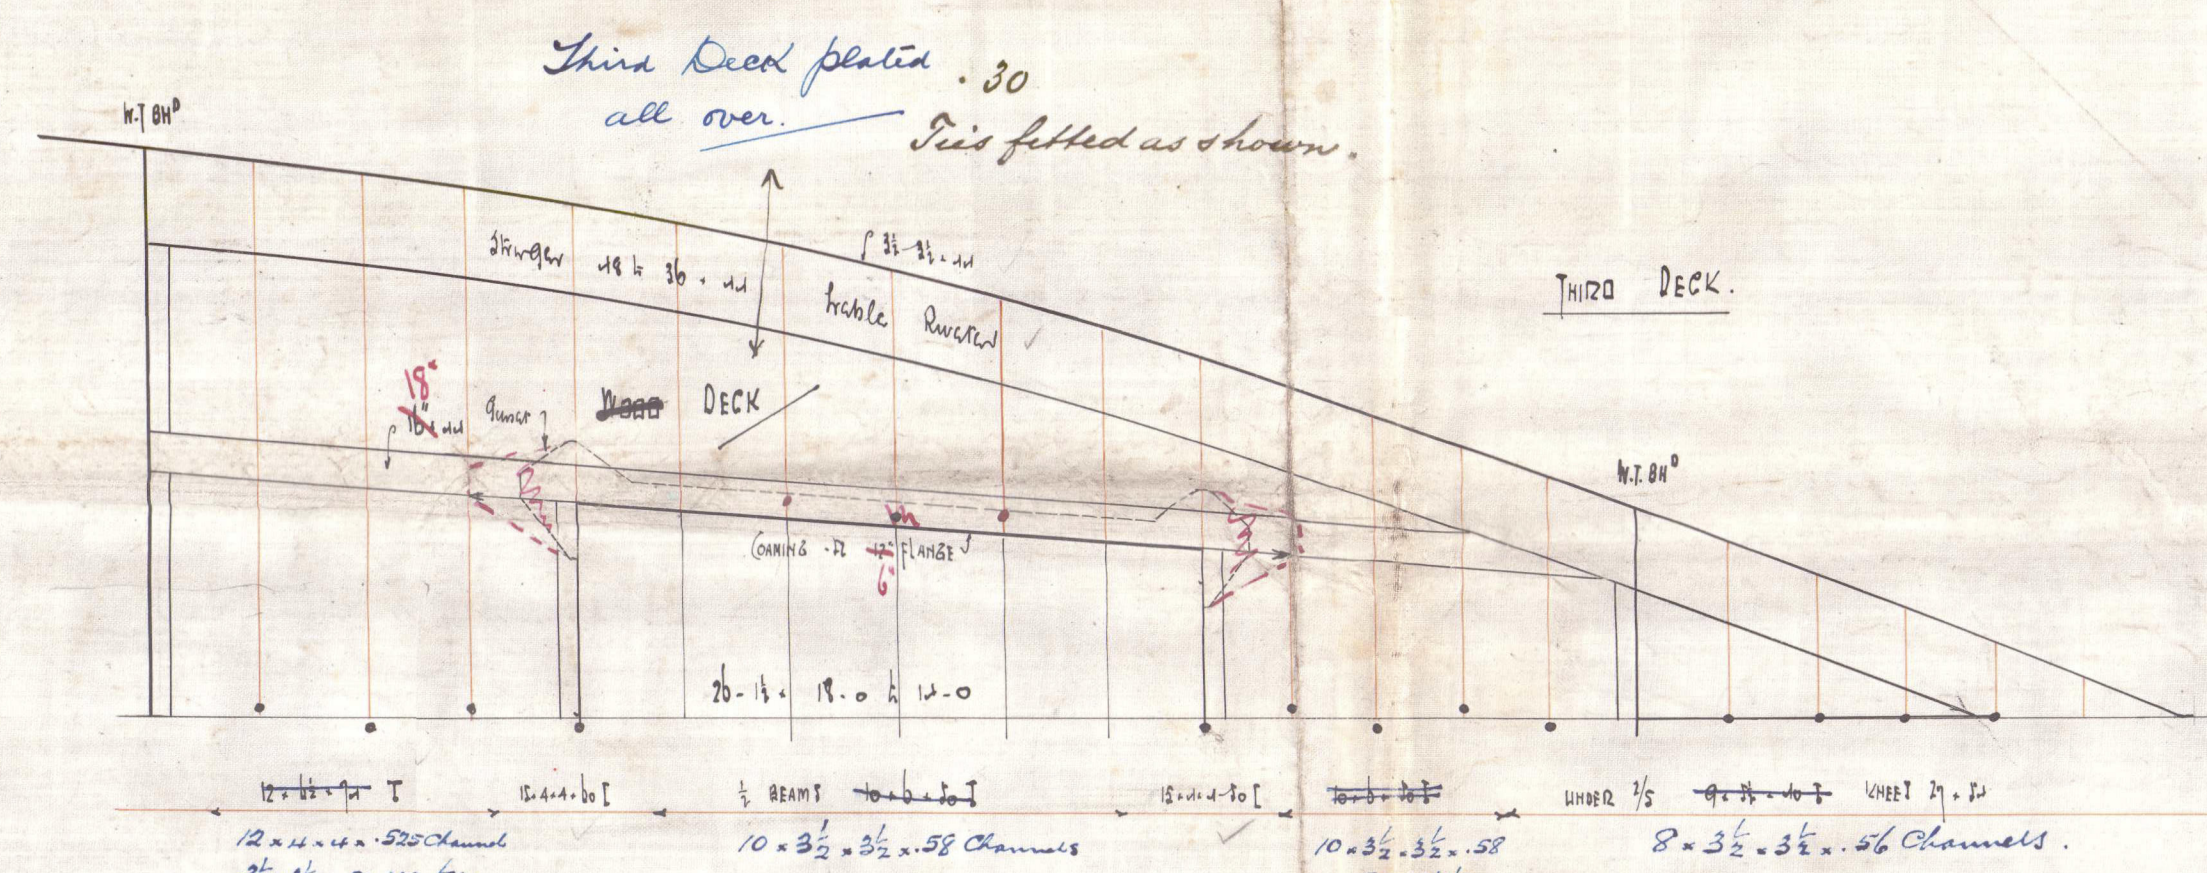

No 90
Prop. & Co.
Amended

Sp. Abadesa.
Mdd Rpt 9274

Elstree Grange

W30-0120



© 2020

Lloyd's Register
Foundation