

 


S.S. N^o 240
469'-4" x 56'-3" x 34'-9"
PROFILE AND DECK PLANS
Scale 1/4" = 1 FOOT

26.11.97
 26.12.97
 27.1.98

 

deck plating 10" thick in way of hatchways
 where half beams are to alternate frames.

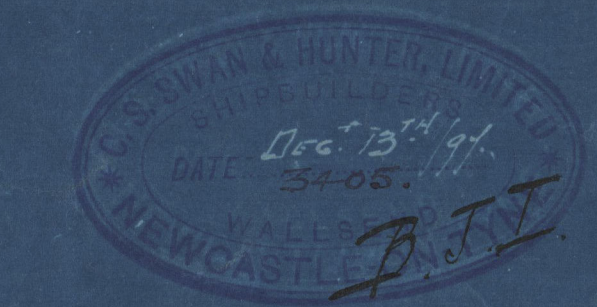


Swan & Hunters

S.S. No 240




Profile & DKS.

Proc. No 35875
- - - 37679

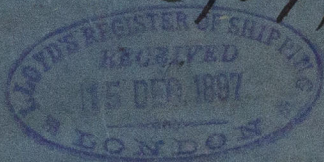

of Politician
Proc. No 37815

Coronda

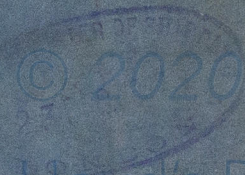 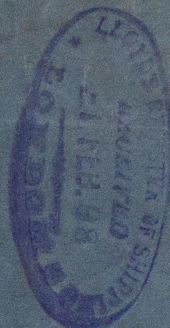

W300-0133

Lloyd's Register
Foundation