


SS. POLITICIAN
 PLAN OF TYPICAL BULKHEAD
 SCALE 1/4" = 1 FOOT

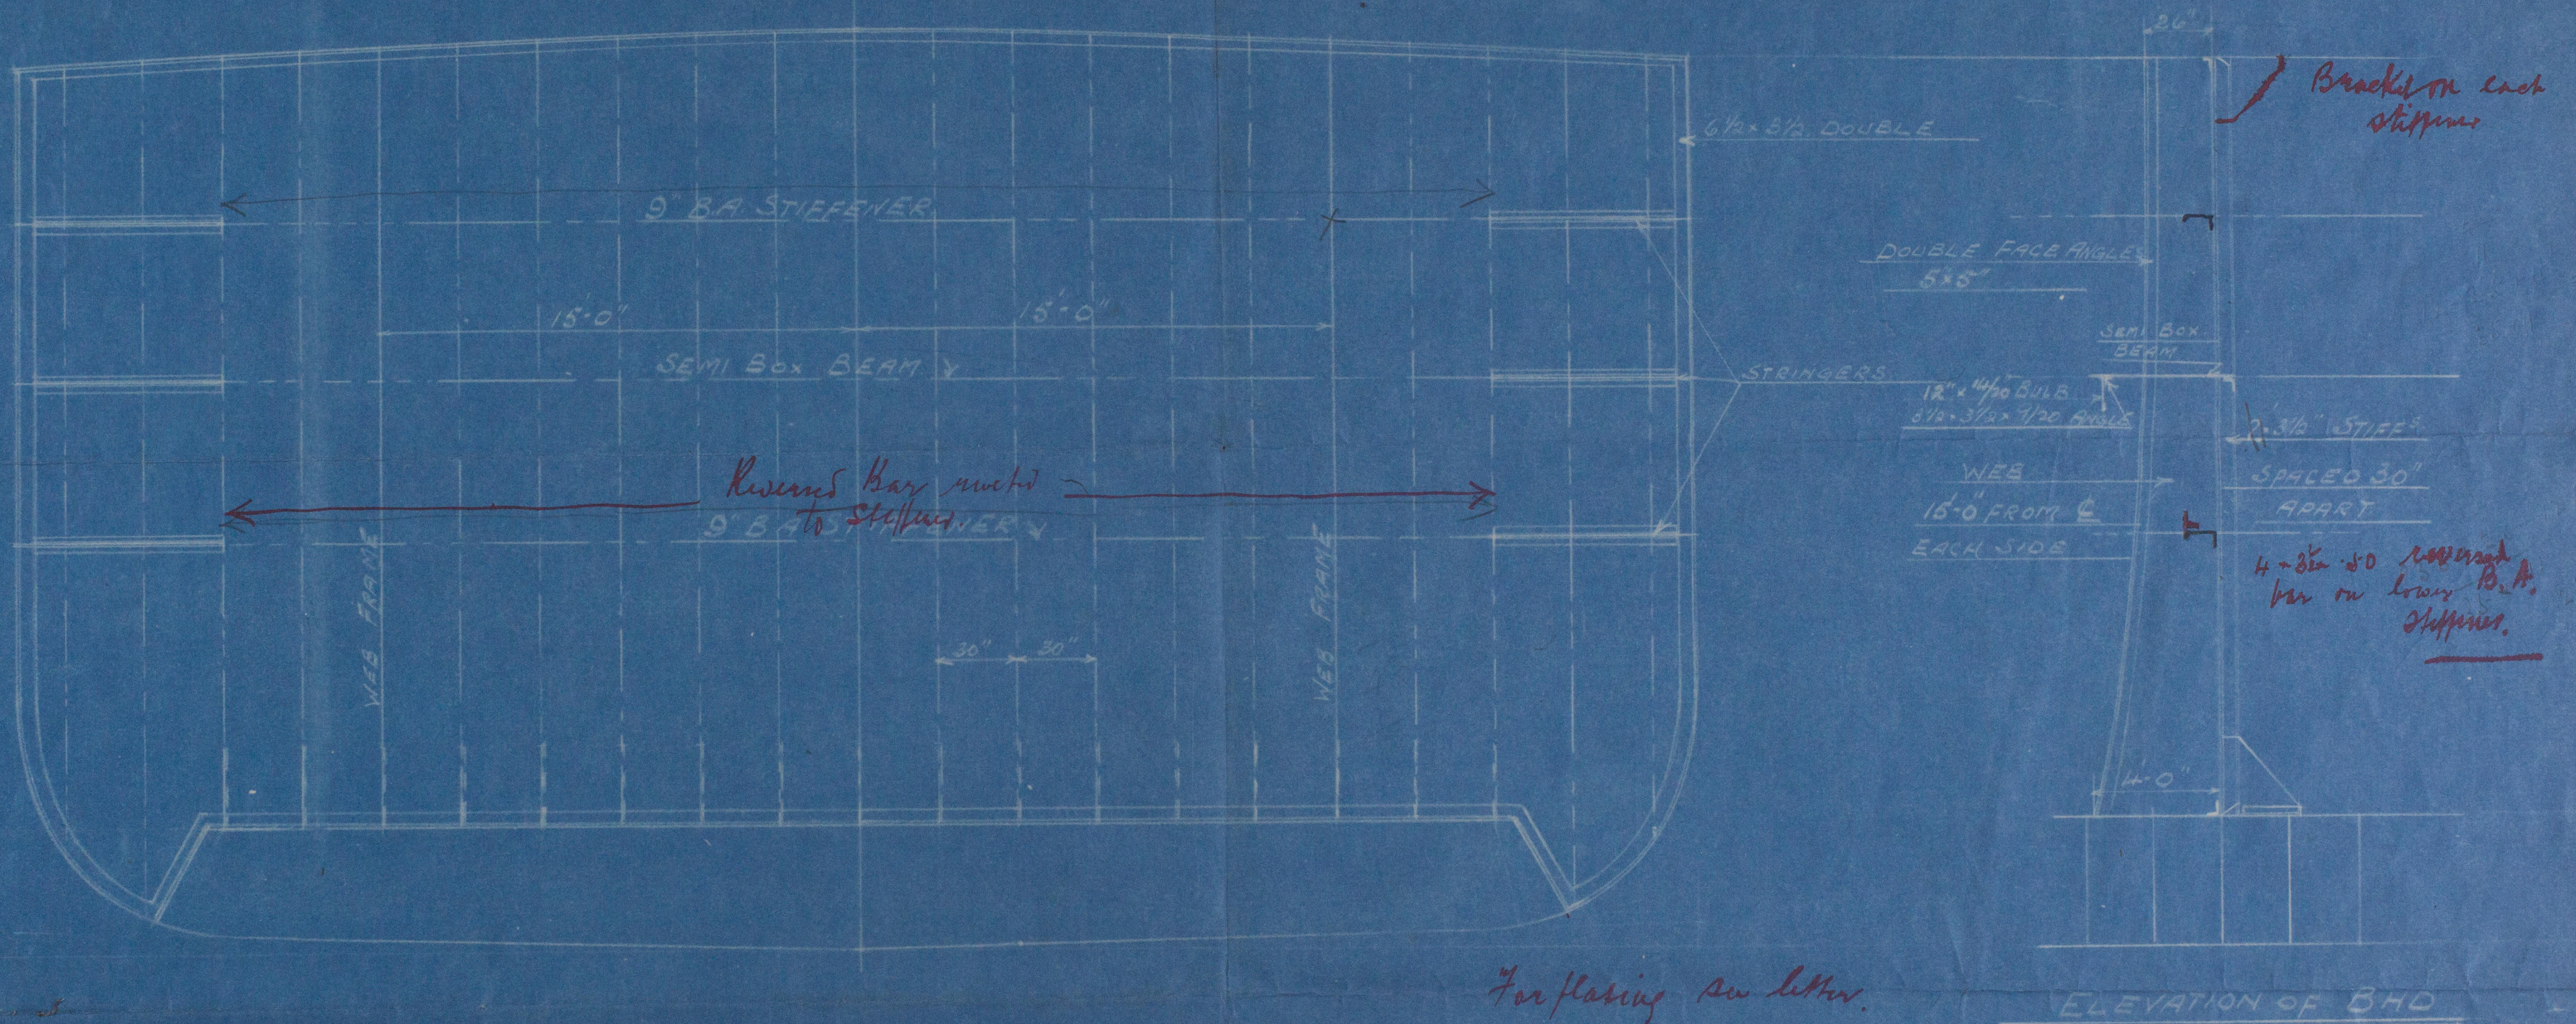

BULKHEAD LOOKING FORWARD

APPROVED
 LLOYD'S REGISTER OF SHIPPING
Montgomery
 DATE 8/9/22

ELEVATION OF BHD

SS "Corona".

Ex. Politician

Typical Dhd.

S.S. "Politician"

Lth rept W 1640



© 2020

Lloyd's Register
Foundation

W300-0165