


"S.S. POLITICIAN"



SKETCH SHEWING CONNECTION OF CENTRE LINE STIFFENERS.
TO MAIN DECK.

SCALE $1\frac{1}{2}'' = 1 \text{ FOOT.}$

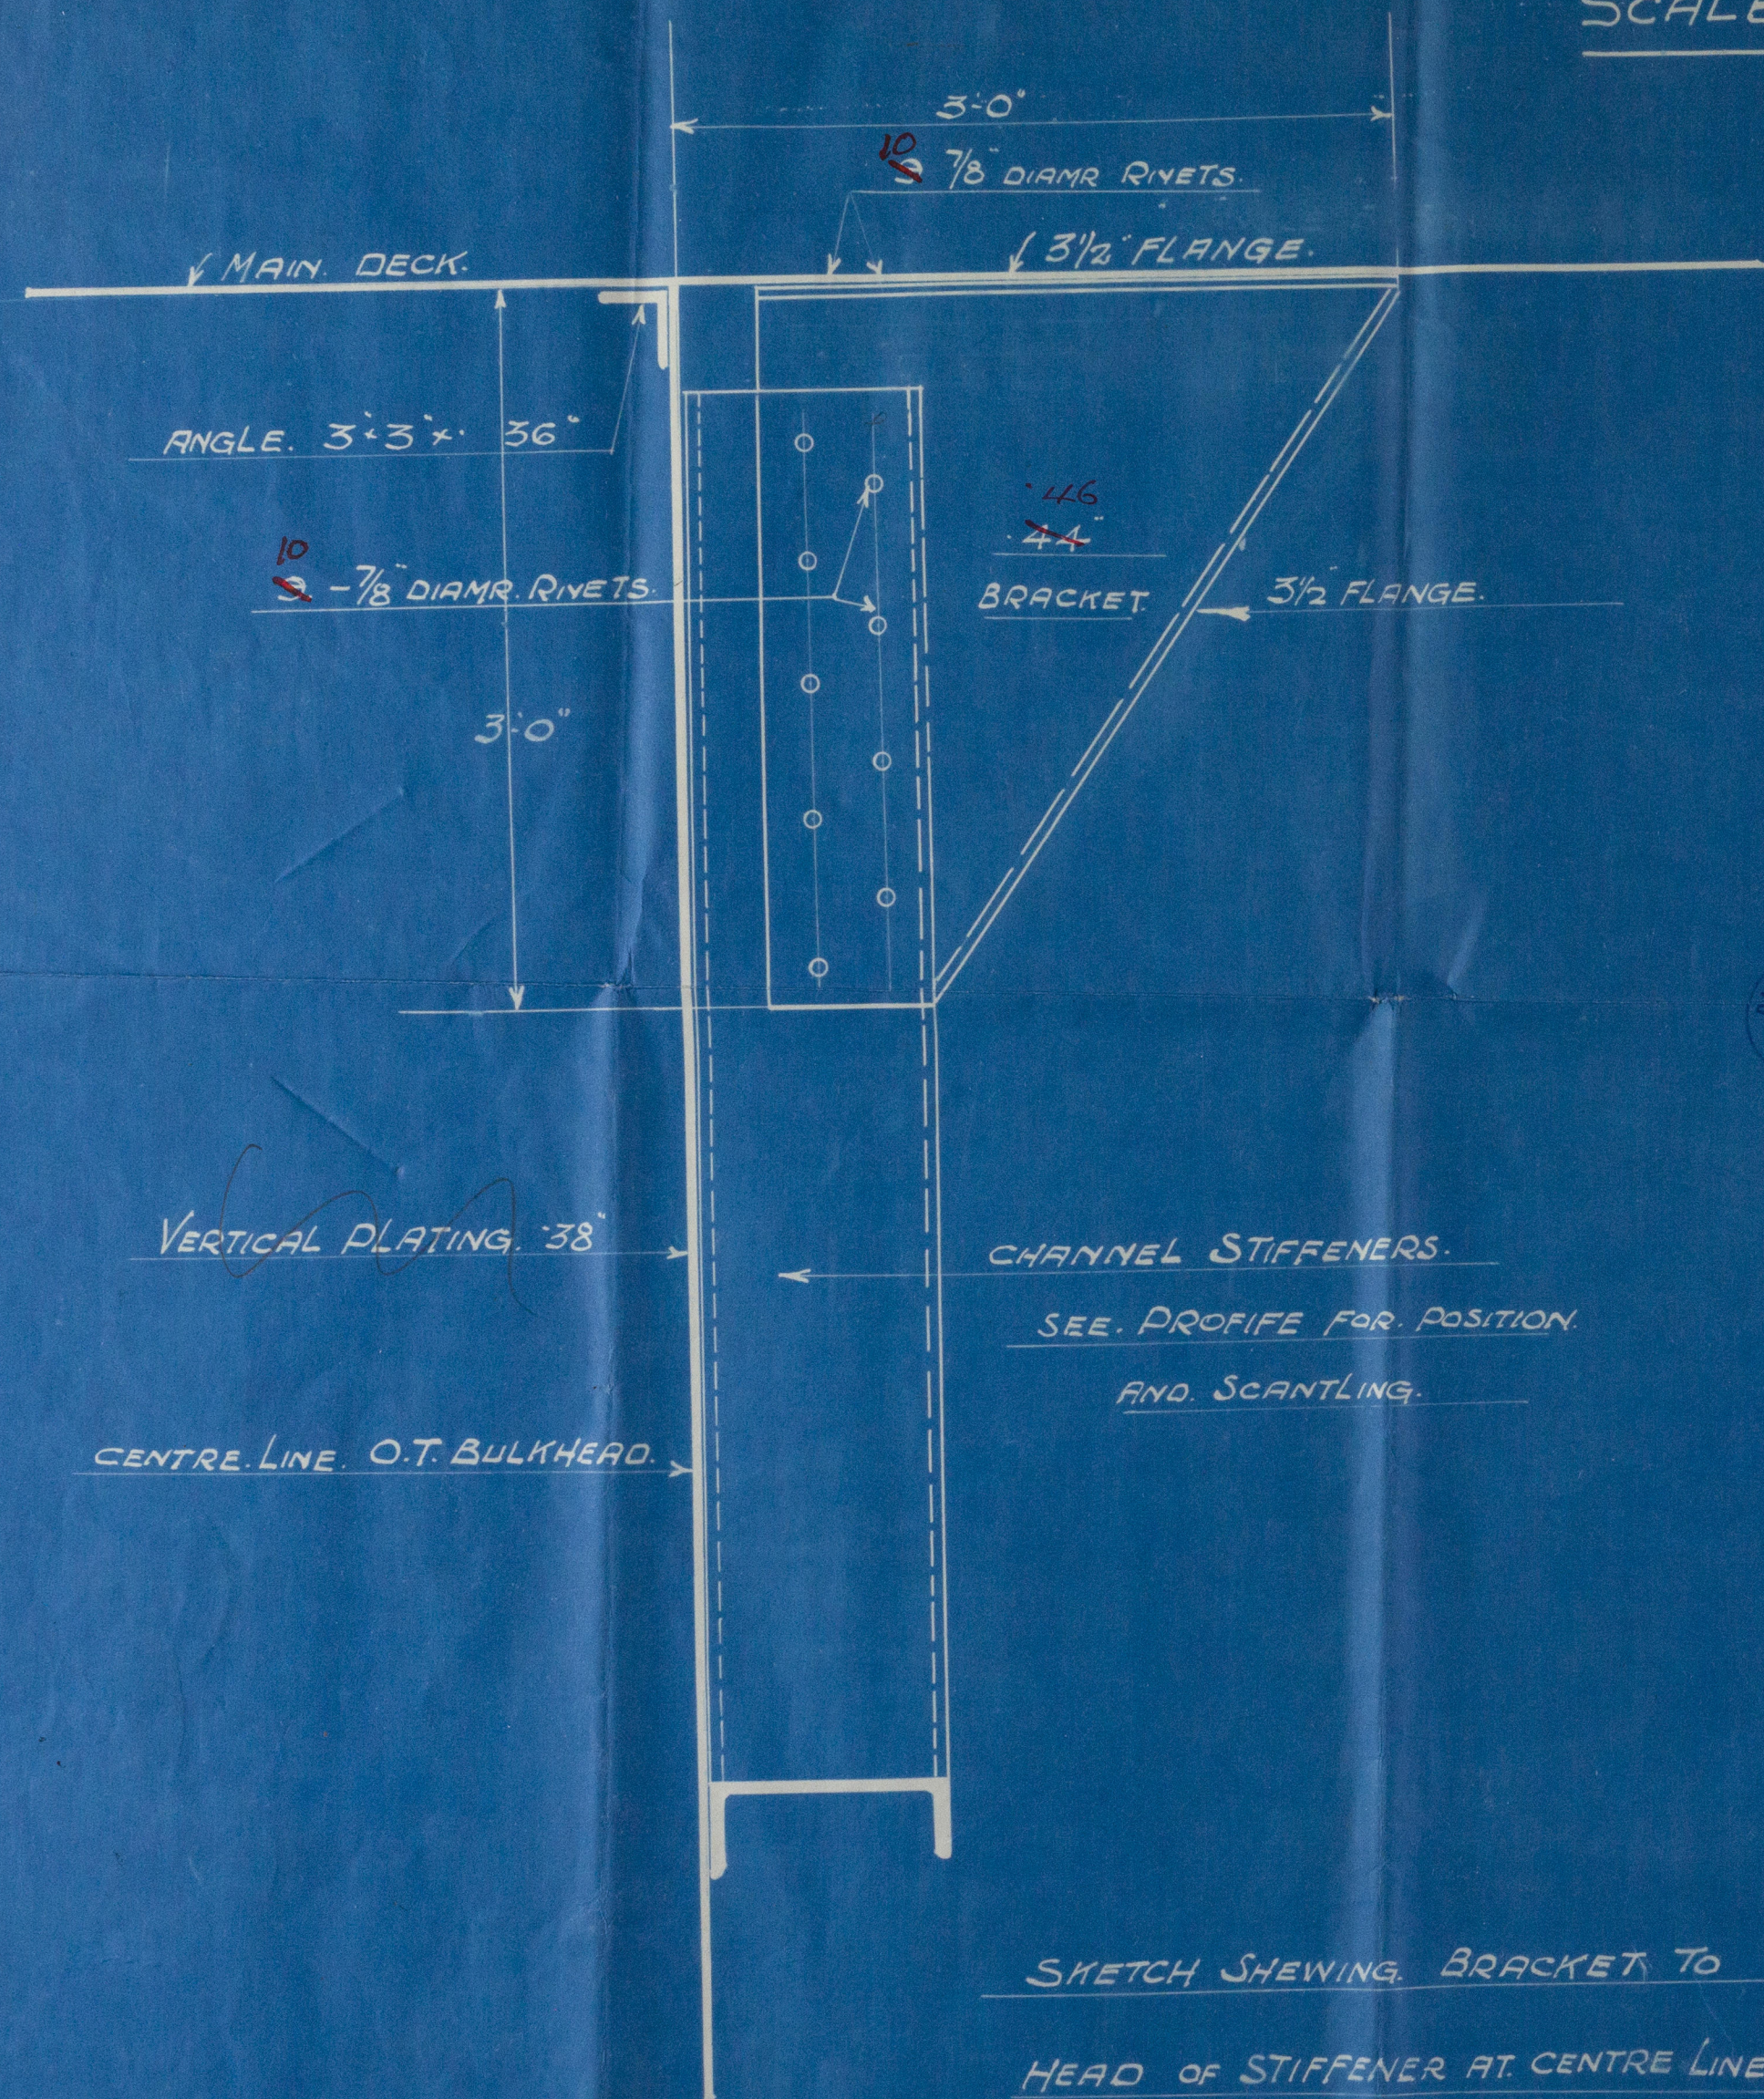

SKETCH SHEWING BRACKET TO
HEAD OF STIFFENER AT CENTRE LINE BULKHEAD.
WHERE NO BEAM IS FITTED.

SCALE $1\frac{1}{2}'' = 1 \text{ FOOT.}$

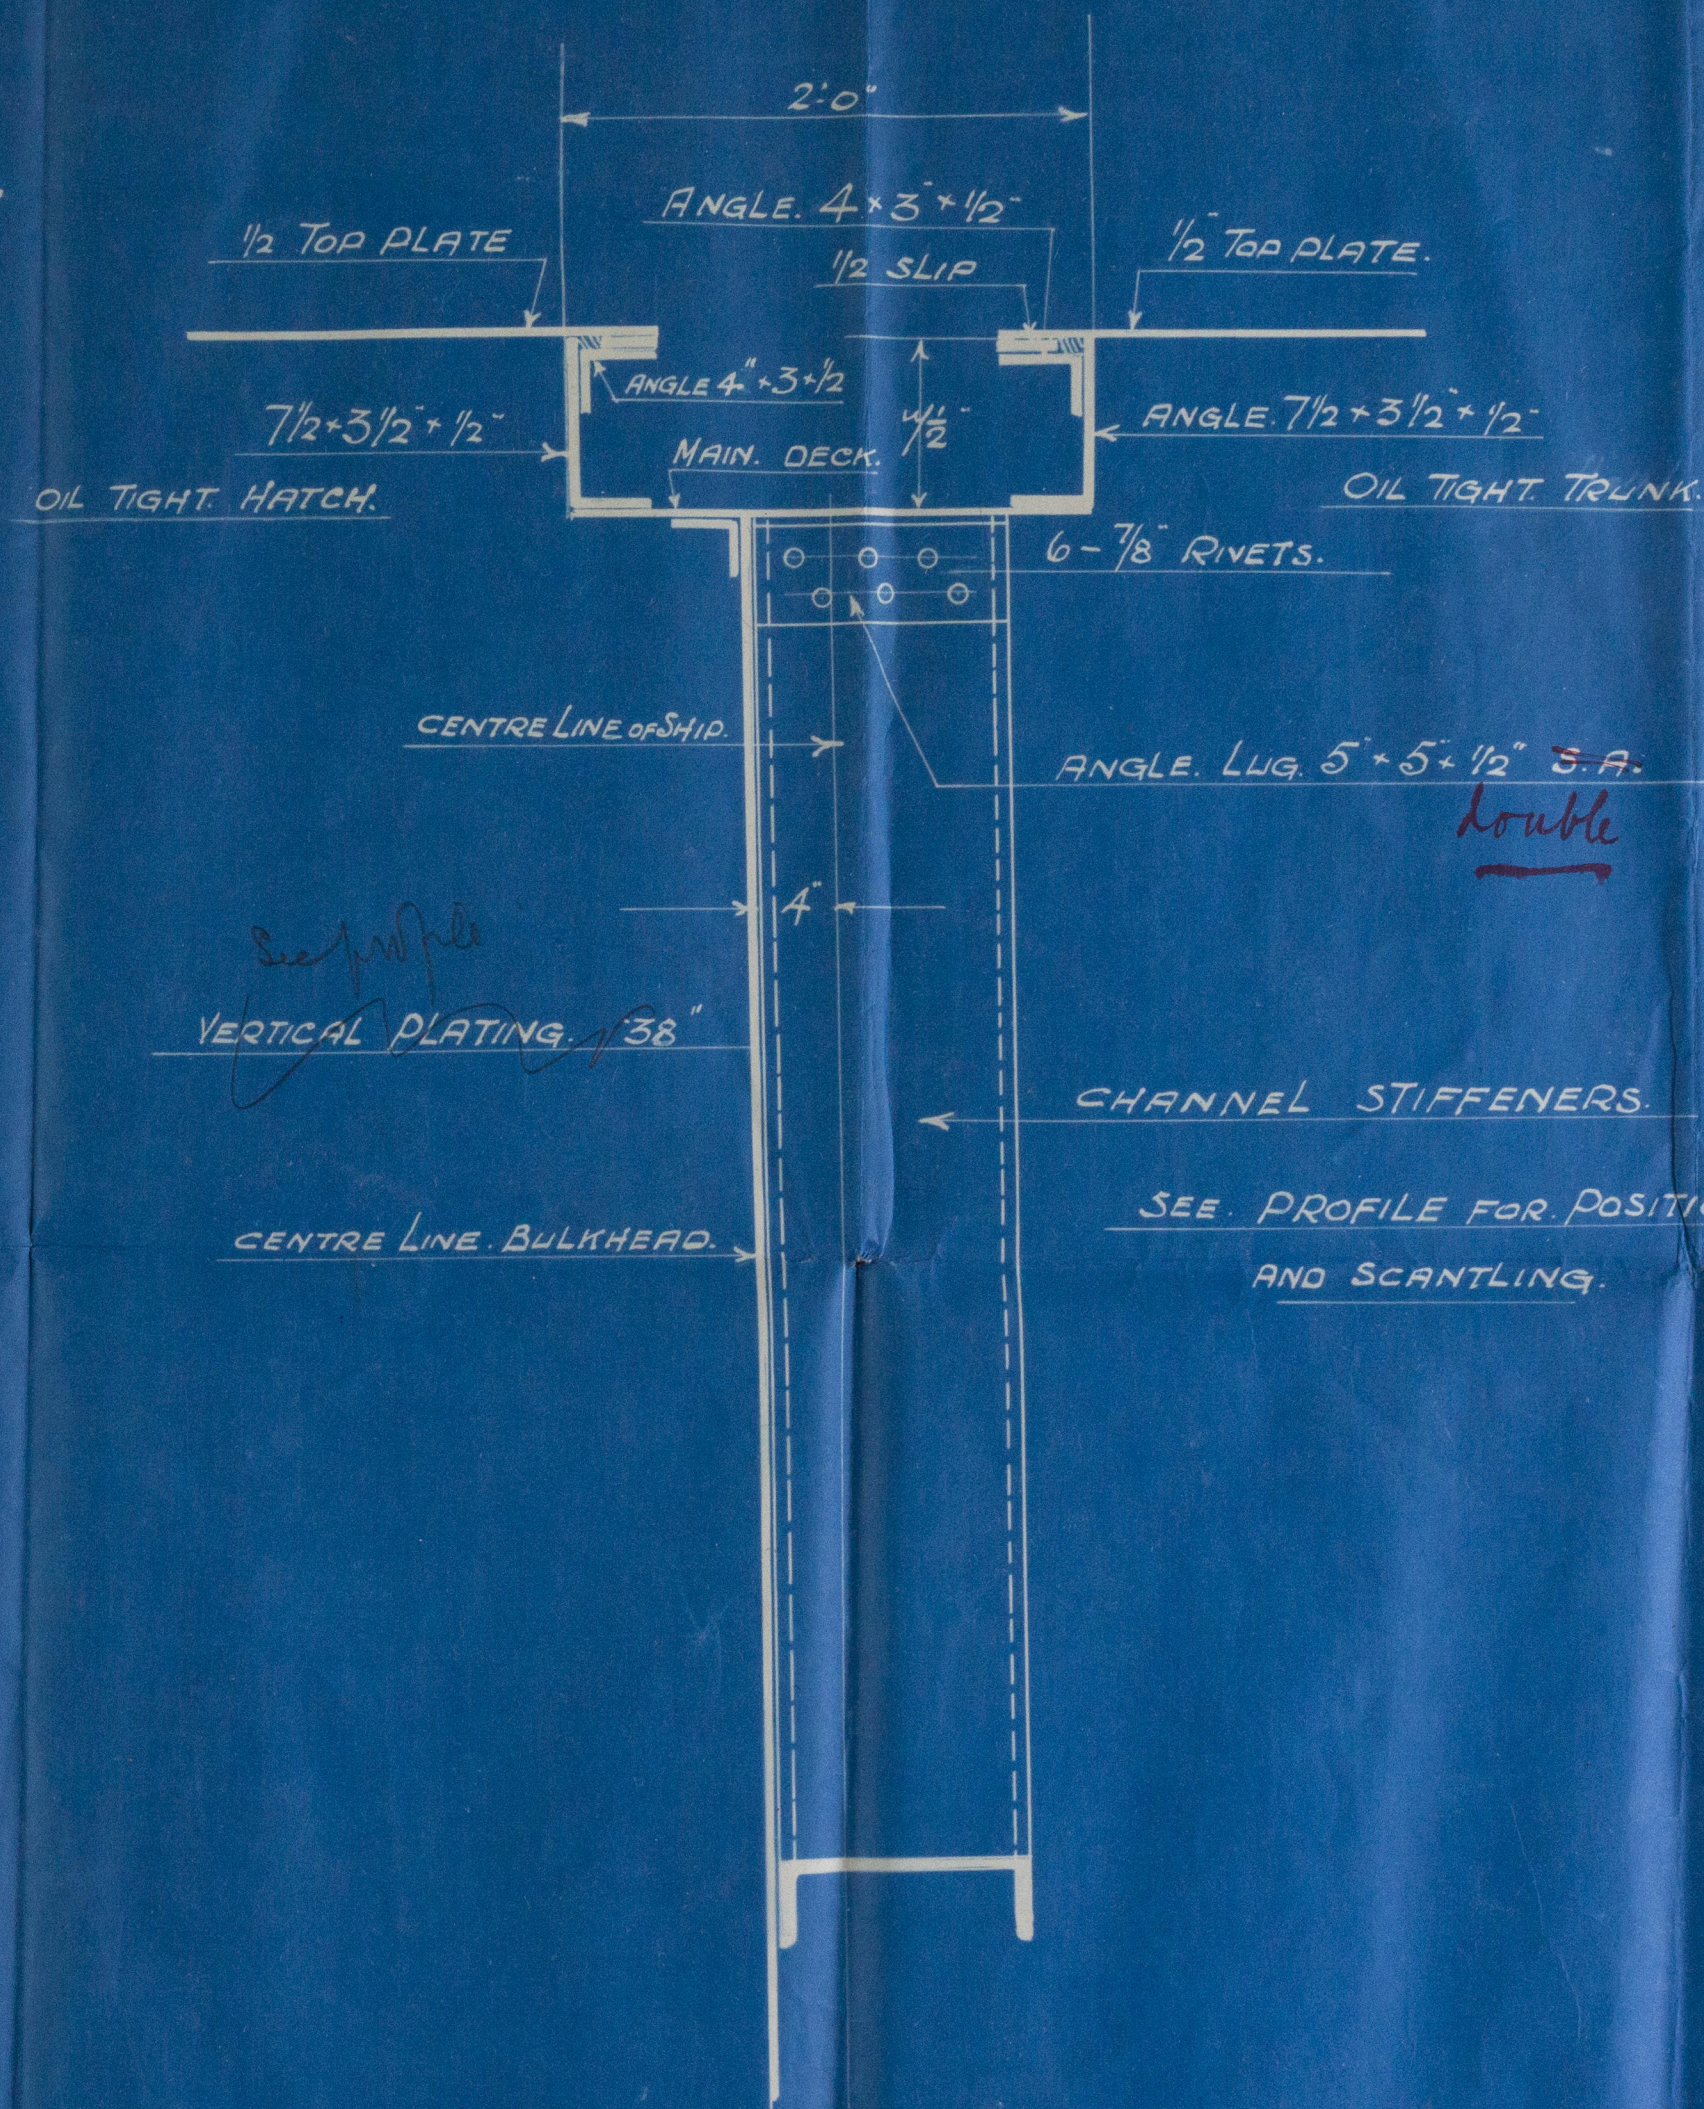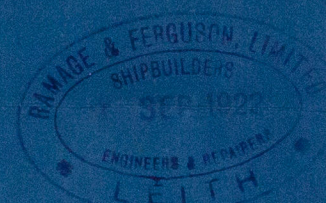

SKETCH SHEWING LUG CONNECTION TO MAIN

DECK AND STIFFENERS ON CENTRE LINE BULKHEAD

IN WAY OF OIL TIGHT HATCH

SCALE $1\frac{1}{2}'' = 1 \text{ FOOT.}$

APPROVED
BY REGISTER OF SHIPPING
J. MONTGOMERY 8/9/22


"Coronda"

Ex. "Politician"

Cr. Line John Skiff. Skiff.

dth rft No. 16240

S. S. "Politician"

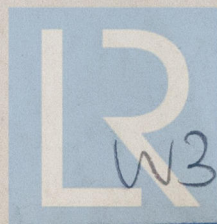

© 2020

W300-0167
Lloyd's Register
Foundation