
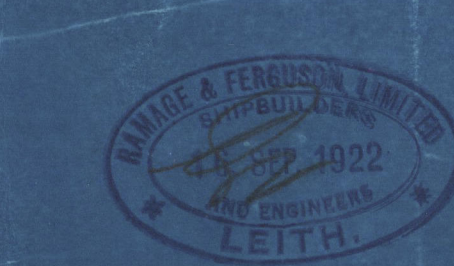


21.9.22

S.S. Politician  
469-4 x 56-5 3'-9 1/2"  
Date 16-1-22  
Frames spaced 24"

CS2  
9  
17

 

LR  
W500-0168



"Coronda".  
Ex. S. S. "Politician"

Alteration to arrangement of suction  
discharge pipes owing to vessel  
being converted for carrying whale oil.

Lth. Regt. No. 16240