


1/12/19

N^o 5 249

Circum Seams $15\frac{1}{16}$ " H. 3" P. Double riveting to be continuous below furnace line.

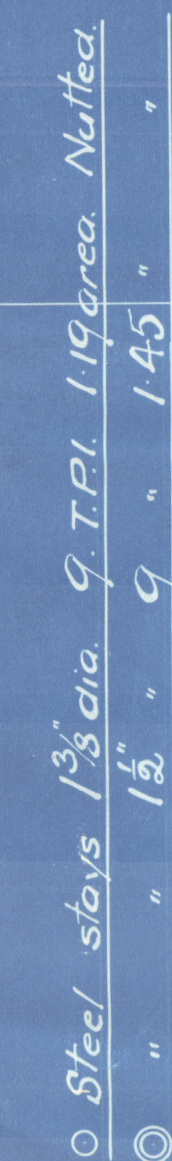

Misses Riley Bros Ltd.

No. 5249.

5250

5251

5252

for

Misses Refner S.B. Repairing to Lini

S.S. No. 535 ✓

536 ✓

537 ✓

538

Working Press 100 lbs

5249

No. 6122
LLOYD'S TEST
200
W.P. - 100
14.5.20 - T.M.

MIDDLESBRO

10697

S.S. Alu. Mendi

Monte Isabela

MIDDLESBRO

S.S. Atxeri - Mendi

10711

5250

No. 6131
LLOYD'S TEST
200
W.P. - 100
2.6.20 - W.M.

5251

No. 6175
LLOYD'S TEST
200
W.P. - 100
18.11.20 - W.M.

S.S. ARinda-Mendi

MIDDLESBRO

Rh. 10871.

5252

No. 6219
LLOYD'S TEST
200
W.P. - 100
11.4.21 - W.M.

S.S. Axpe Mendi

Middlesbrough

Opt. 11000



© 2020

W304-0178

Lloyd's Register
Foundation