


- Scala 1:2 -

LONDON COPY.

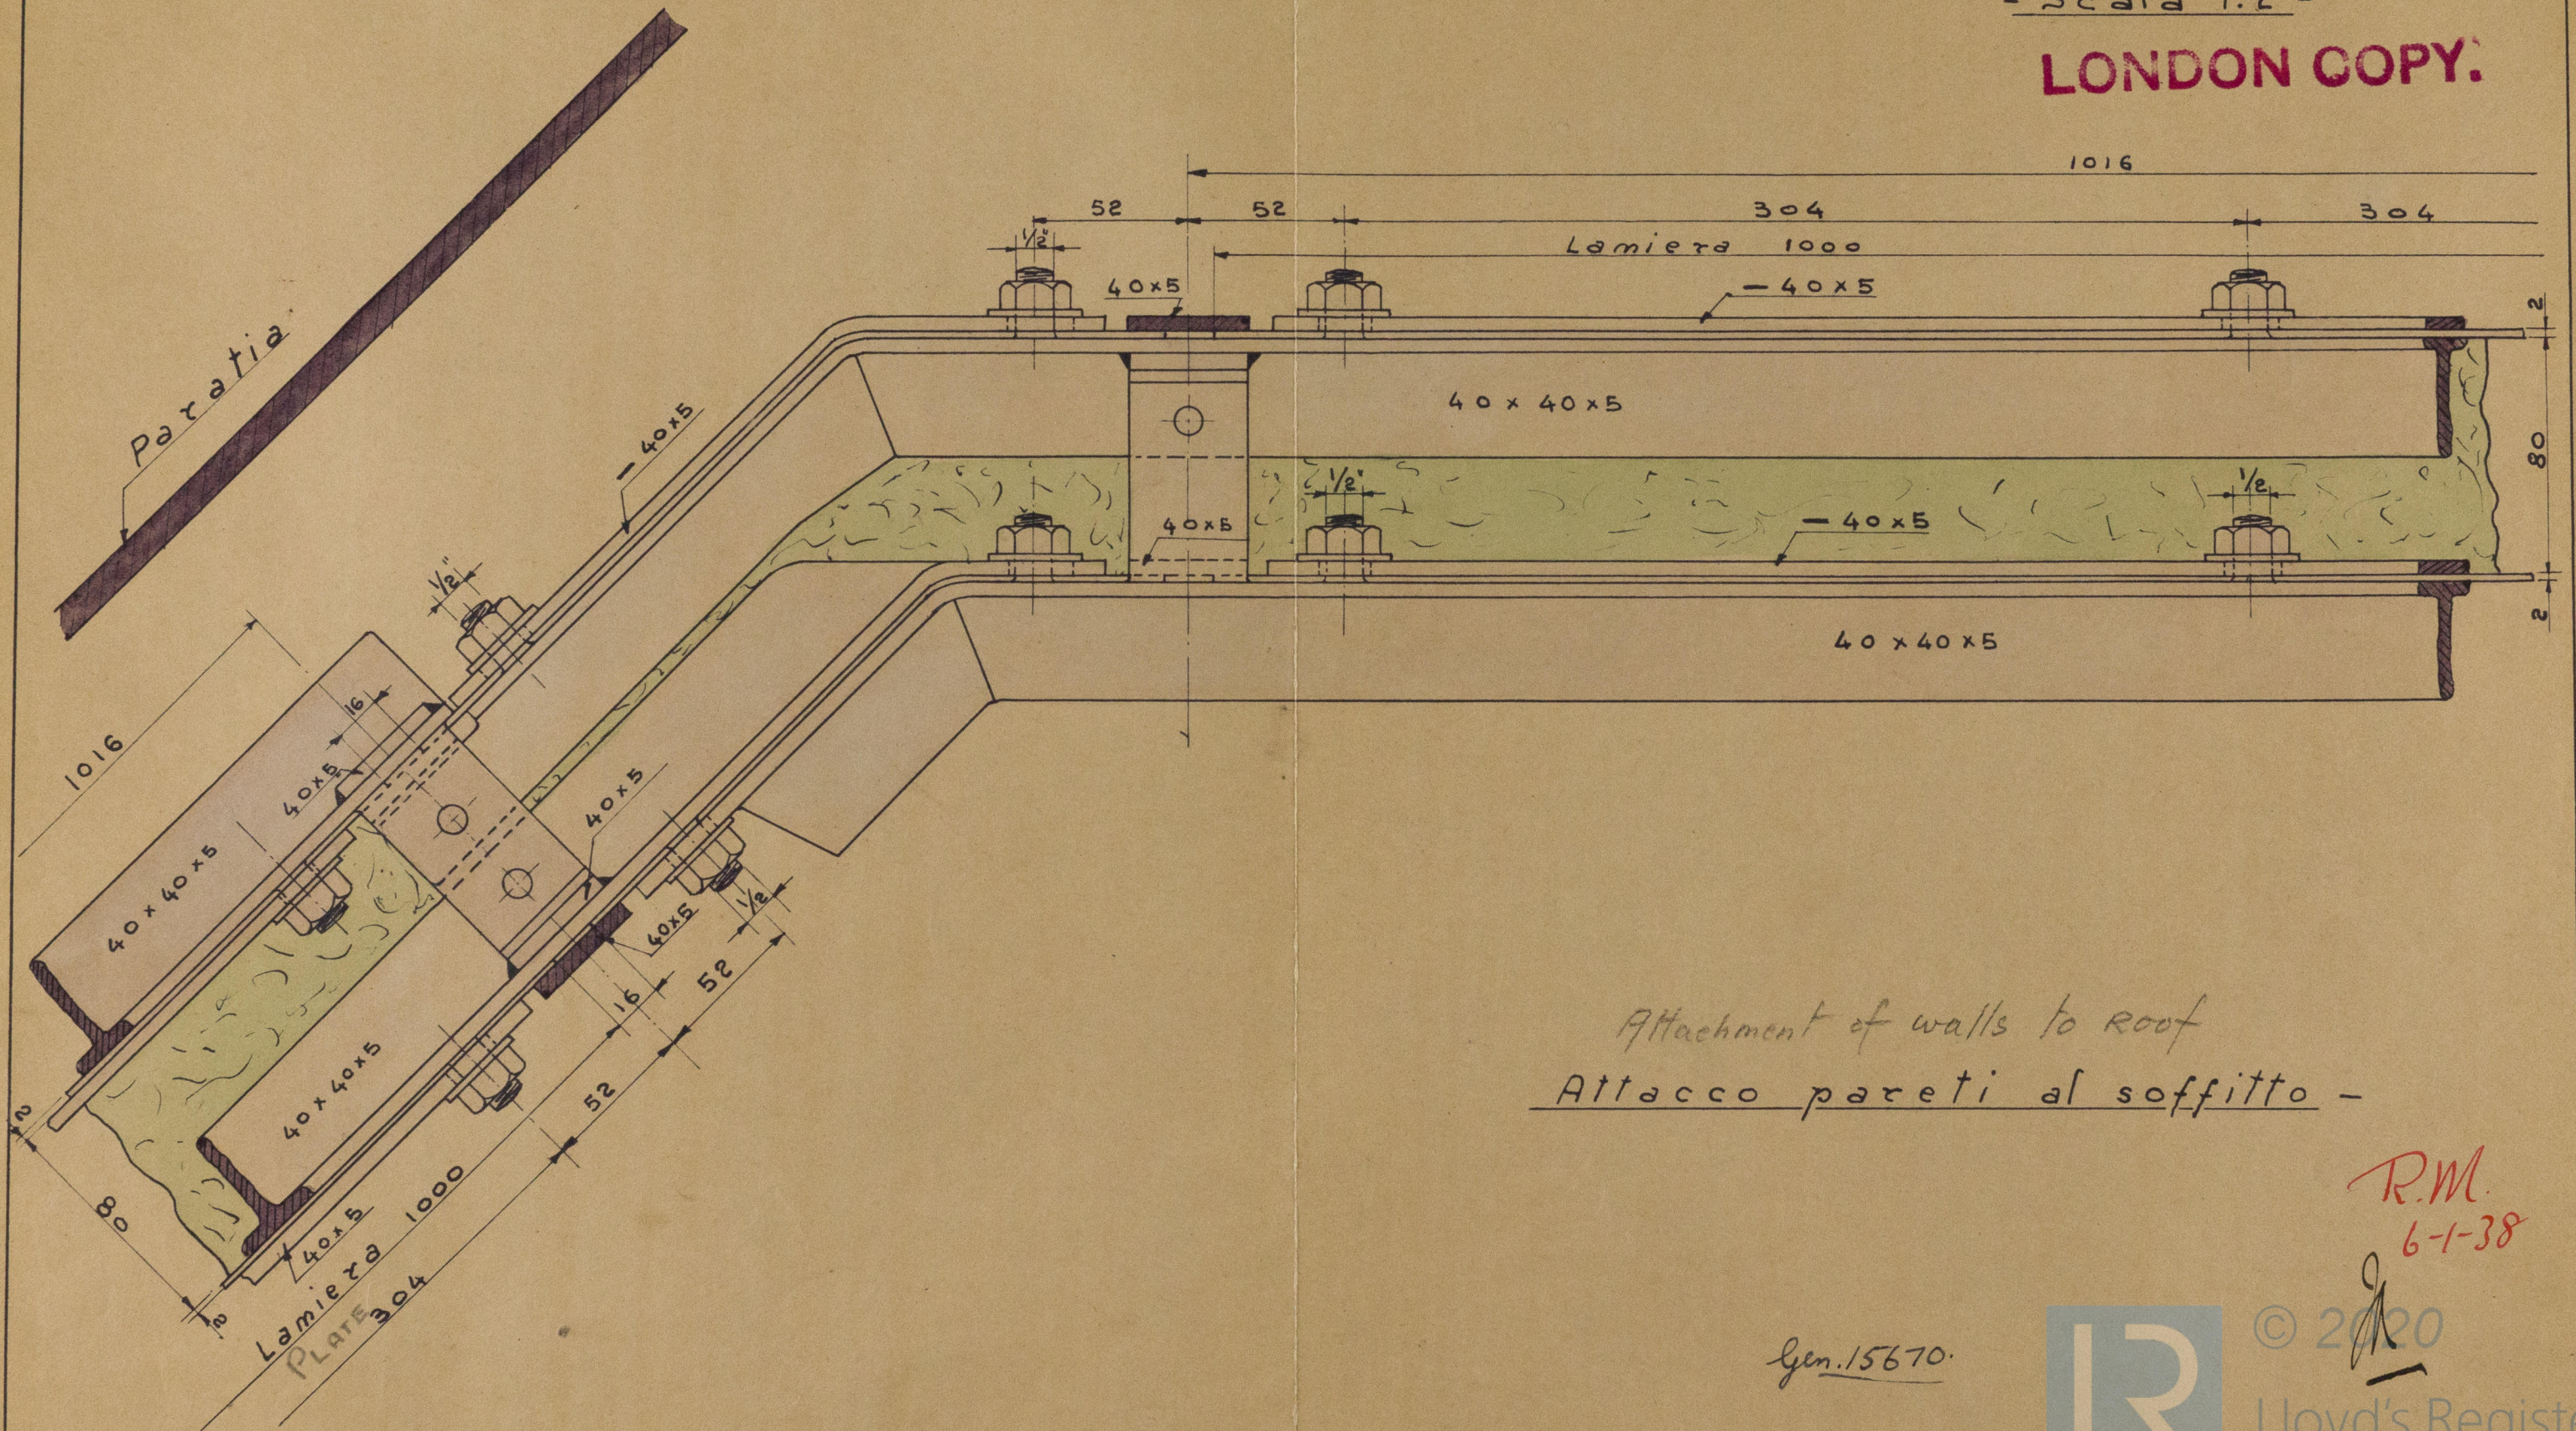

Attachment of walls to roof
Attacco pareti al soffitto -

R.M.
6-1-38

Gen. 15670.



© 2020

Lloyd's Register Foundation

Dis. N. 7158

86. 11 Dic. 1937-XVI

W305-0318