


LONDON COPY.

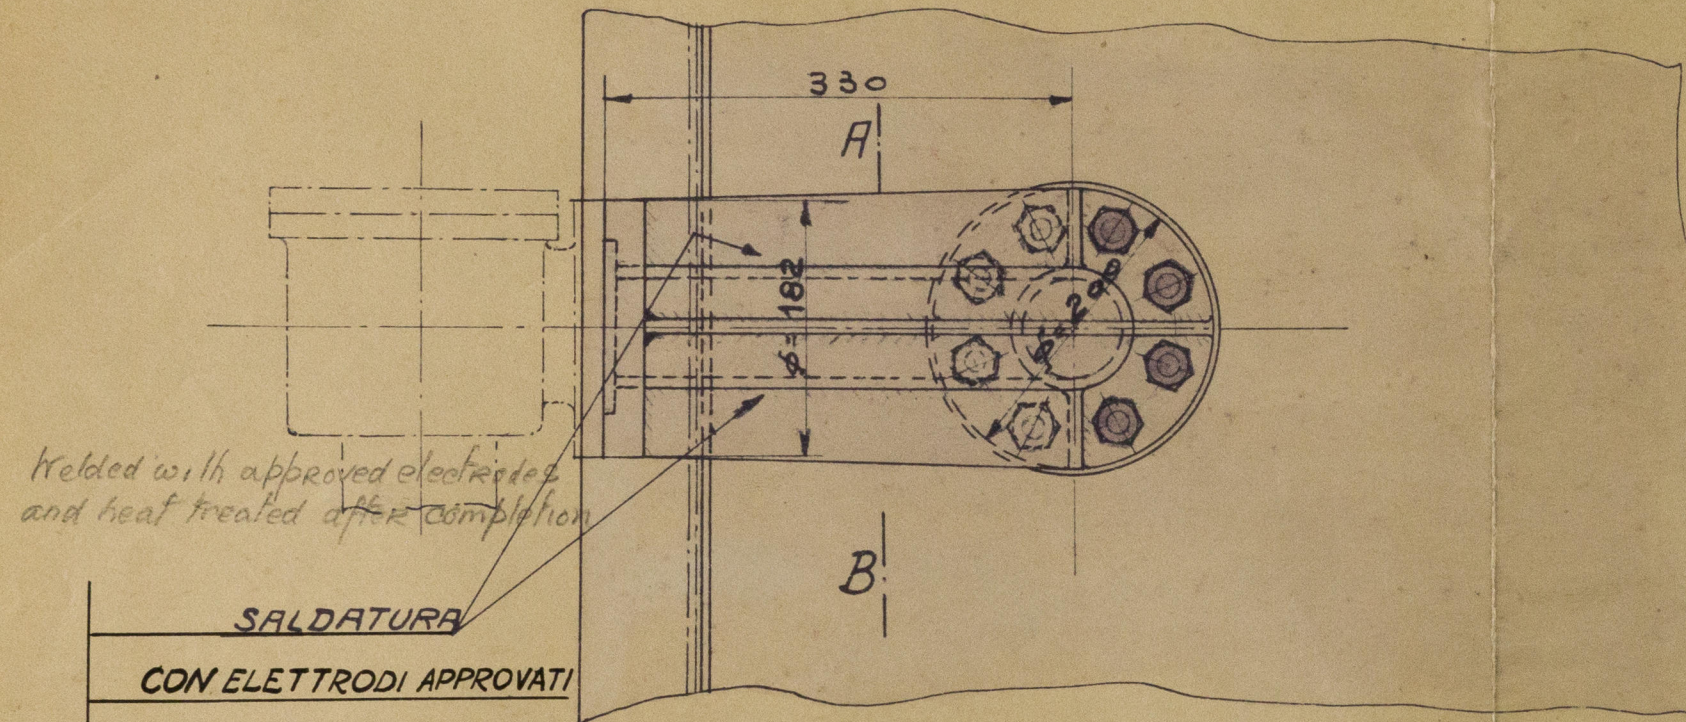


Welded with approved electrodes
and heat treated after completion

SALDATURA


CON ELETTRODI APPROVATI

TRATTAMENTO TERMICO A

PEZZO ULTIMATO

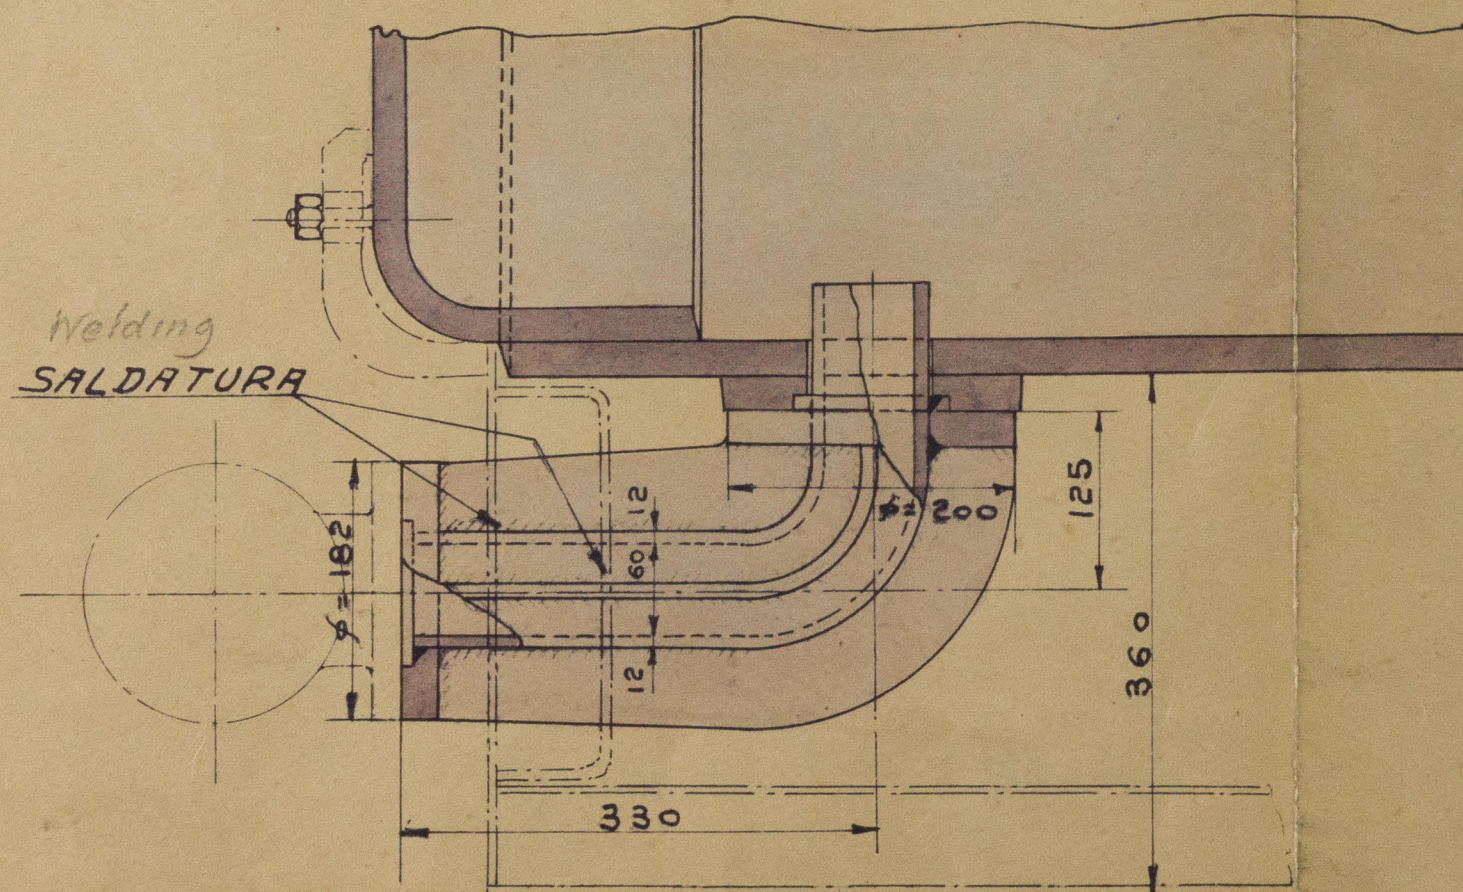

Welding
SALDATURA

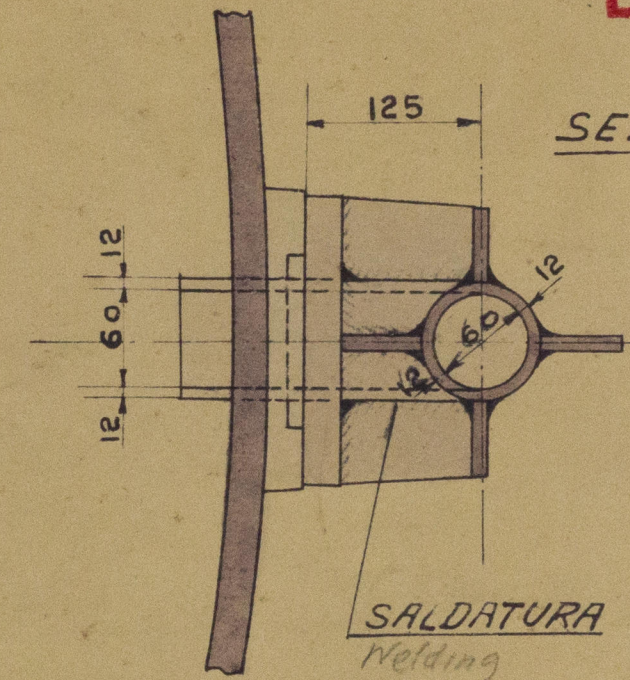


SEZIONE A-B

Material
MATERIALE :

ACCIAIO

SALDATO


Welded steel

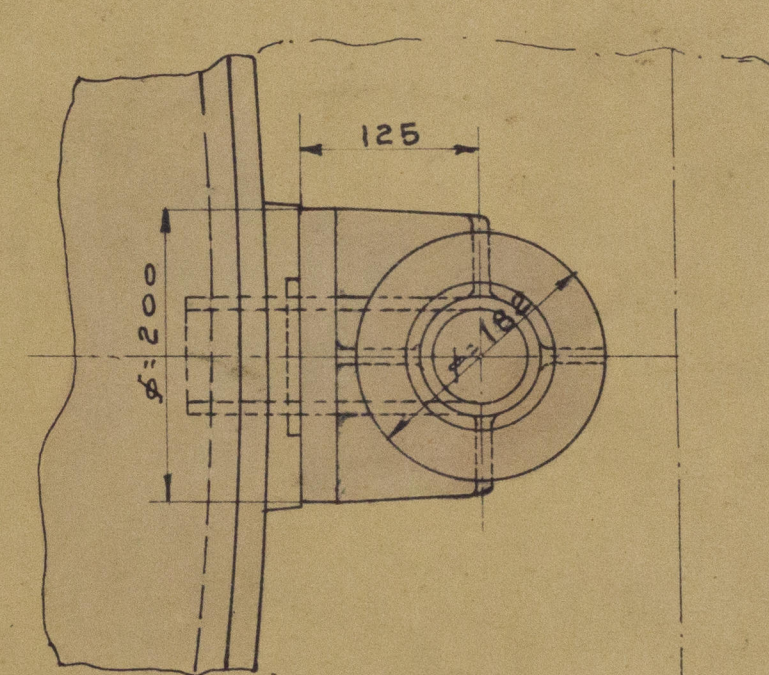

Stand. pipe for 60^{mm} diam. valve
PROLUNGA PER VALVOLE $\phi=60$

SCALA 1:5

Gen 15670.

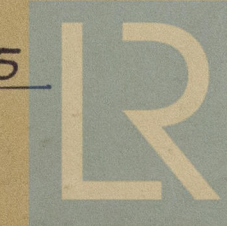

J. M. 4
2020/13/4/31

Lloyd's Register
Dis. No. 7171
20 Dic. 1937-XVI

W305-0328