



Revised  
13/3/08

T.S. MOTOR YACHT No 361.  
STEEL PROFILE & DECK PLANS.  
SCALE 1/4" = 1 FOOT.

PILLARING TO BE SEPARATELY SUBMITTED.

 

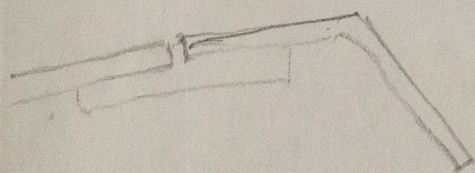

© 2020

Lloyd's Register  
Foundation

Crusader Rpt NO 16995.

T. S. M. Y.

Nº 361.

Camper & Nicholson  
Ld.

Soton.

STEEL PROFILE &

DECK PLANS.

Verified Copy.

C.S.M.  
16/3/28.

GEN. EXH NO 139



© 2020

Lloyd's Register  
Foundation

W306-0005