

SUNDERLAND

J. DICKINSON & SONS L^{td}


(3) BOILERS N^o 861

W.P. = 200 LBS


J. L. THOMPSON & SONS L^{td}

S/S N^o 548

SUNDERLAND RPT. No. 28517

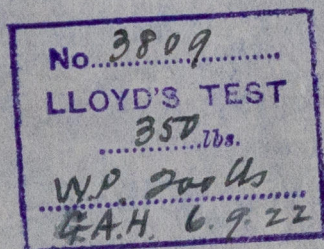

Back and bottom plates
have increased to $\frac{3.9}{39}$
instead of fitting doubling
plates

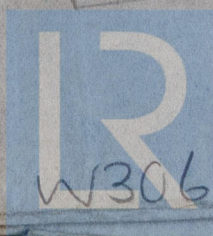

© 2020

Lloyd's Register
Foundation