

# S. S. "BRITISH LADY"






Nº 548

PROFILE AND DECK PLANS

PRINCIPAL DIMENSIONS. 411'6" LBP 54'6" BTH M-9 54'10" BTH EXT 33'0" DEPTH M-9

ISHERWOOD SYSTEM (PATENT)

SCALE 1/16" = 1'00"

 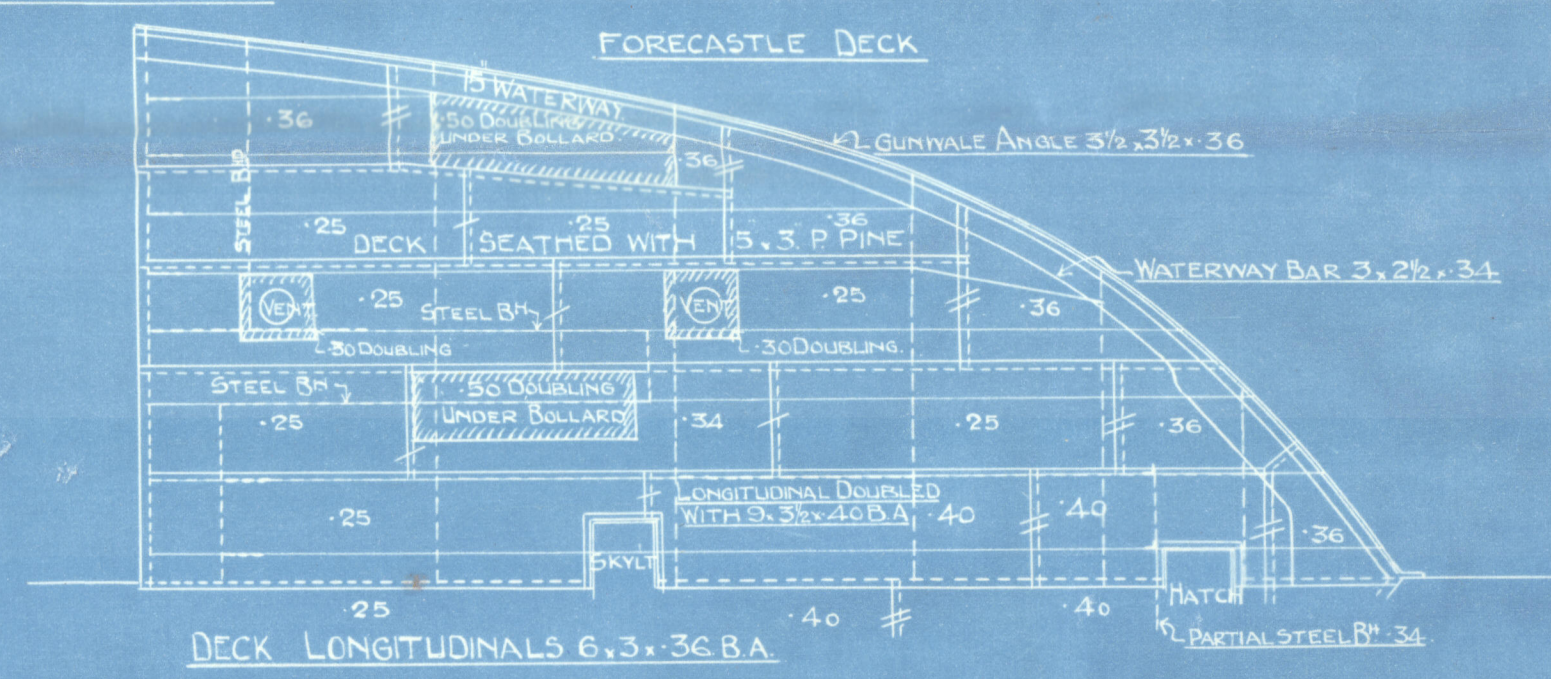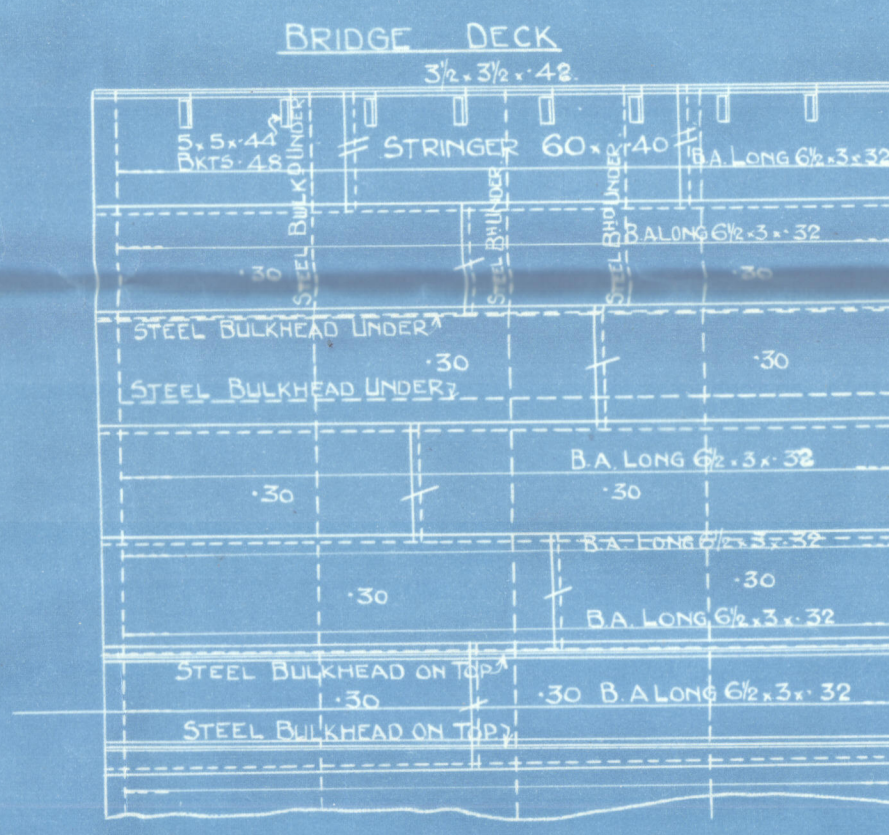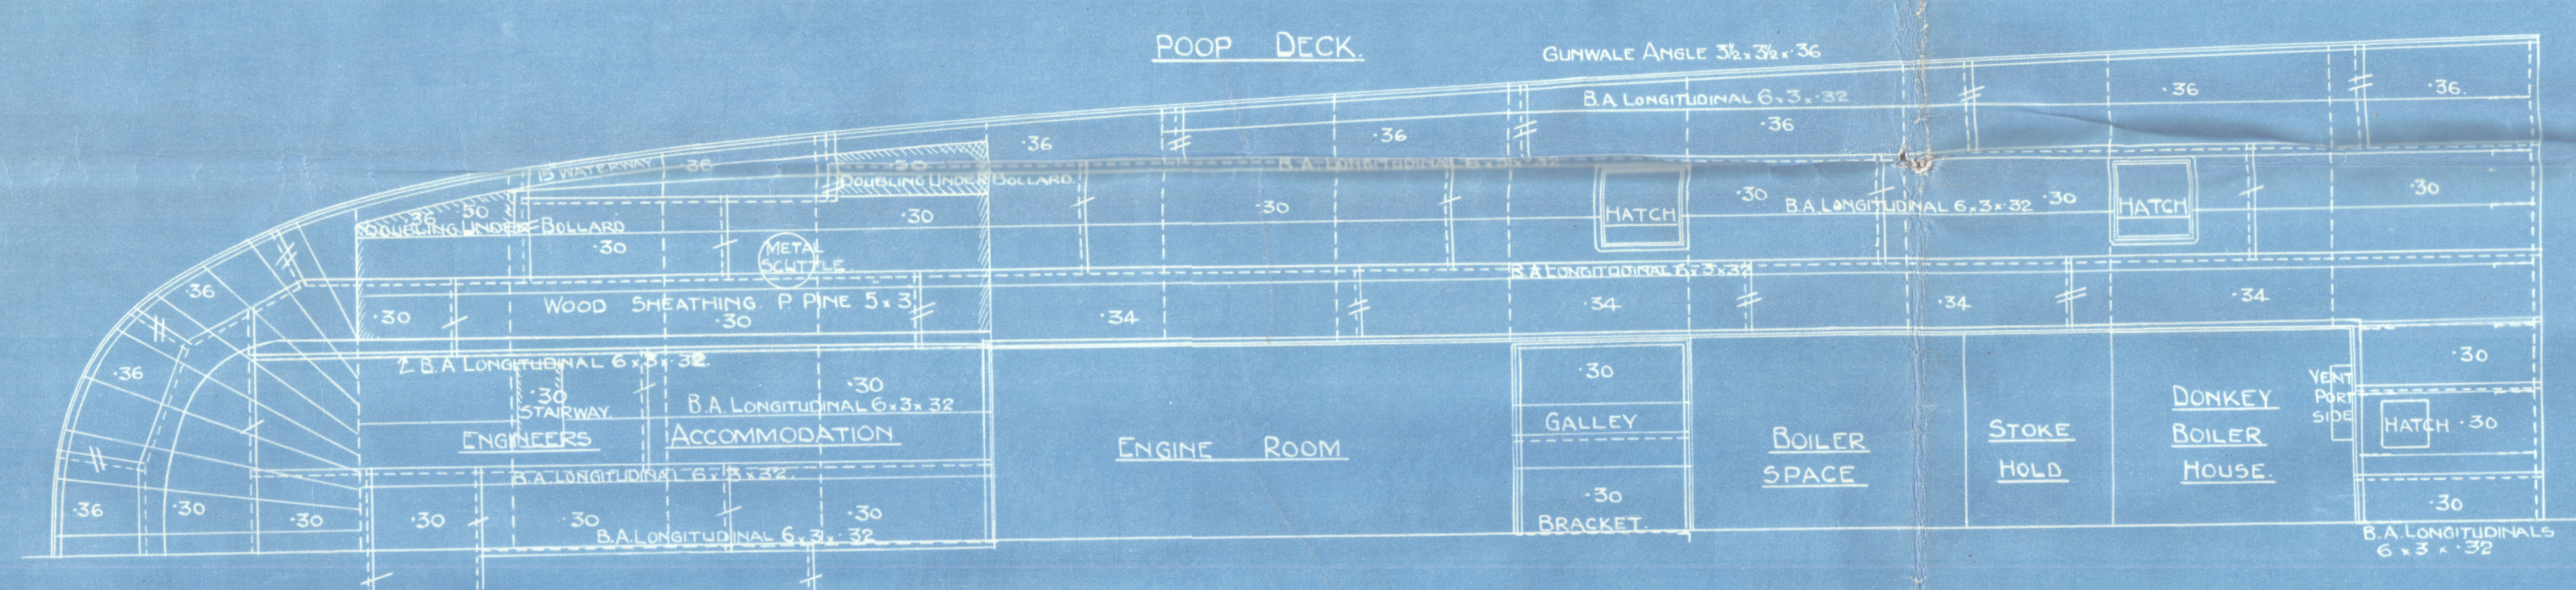 

8772  
548  
8225



SUNDERLAND

J. L. THOMPSON & SONS LTD

Nº 548

S.S. 'BRITISH LADY'

PROFILE AND DECKS  
as built

SUNDERLAND RPT. NO. 28514



© 2020

Lloyd's Register  
Foundation

W306-0154