

"ANNA-MARIE."

T.S.M.Y.

Nº 1099

Messrs John. I.

Thornycroft & Co. Ld.  
Soton.

MIDSHIP Section.

App'd. plan.  
14/10/29.

Rpt NO 17744



© 2019

Lloyd's Register  
Foundation

W307-0166




14/10/29

# T. S. MOTOR YACHT.

## SCANTLING SECTION.

### LLOYDS NUMERALS

138	83	139.04
11	5	11.91
13	25	13.08
TRANSVERSE NUMERAL	24	75
10	47	10.63
24-75 x 100	53	53.34
LONGITUDINAL NUMERAL =		
$L(\frac{1}{2} + D)$		3436.04 3470.

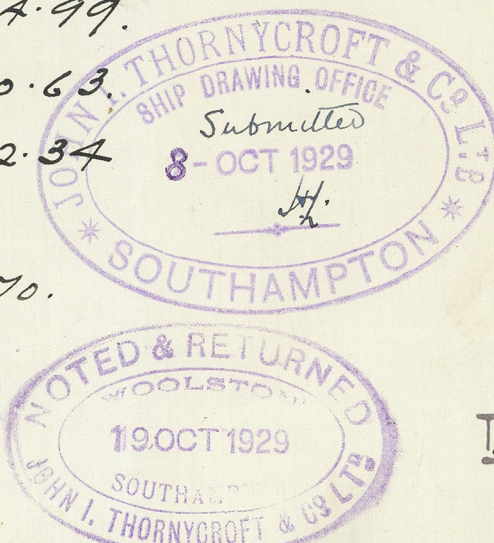

SCALE  $\frac{1}{2}$ " = 1 FOOT

### PRINCIPAL DIMENSIONS


LENGTH W.L.	136'-0"
BREADTH M <sup>LD</sup>	23'-0" 23'-10" as built.
DEPTH	13'-3" 13'-1" D <sub>0</sub> .

TO CLASS 100 + A1 AT LLOYDS.


EQUIPMENT N<sup>o</sup> 3950  
3911-54

LETTER 26

BOWER ANCHOR	STOCKLESS	6 1/8 CWTs
		6
STREAM	EX STOCK	1 7/8
150 FATHOMS	7/8	STUD LINK CHAIN CABLE
45	2 CIRC	S W ROPE
75	7 CIRC	HAWSER HEMP
75	4 1/2	WARP

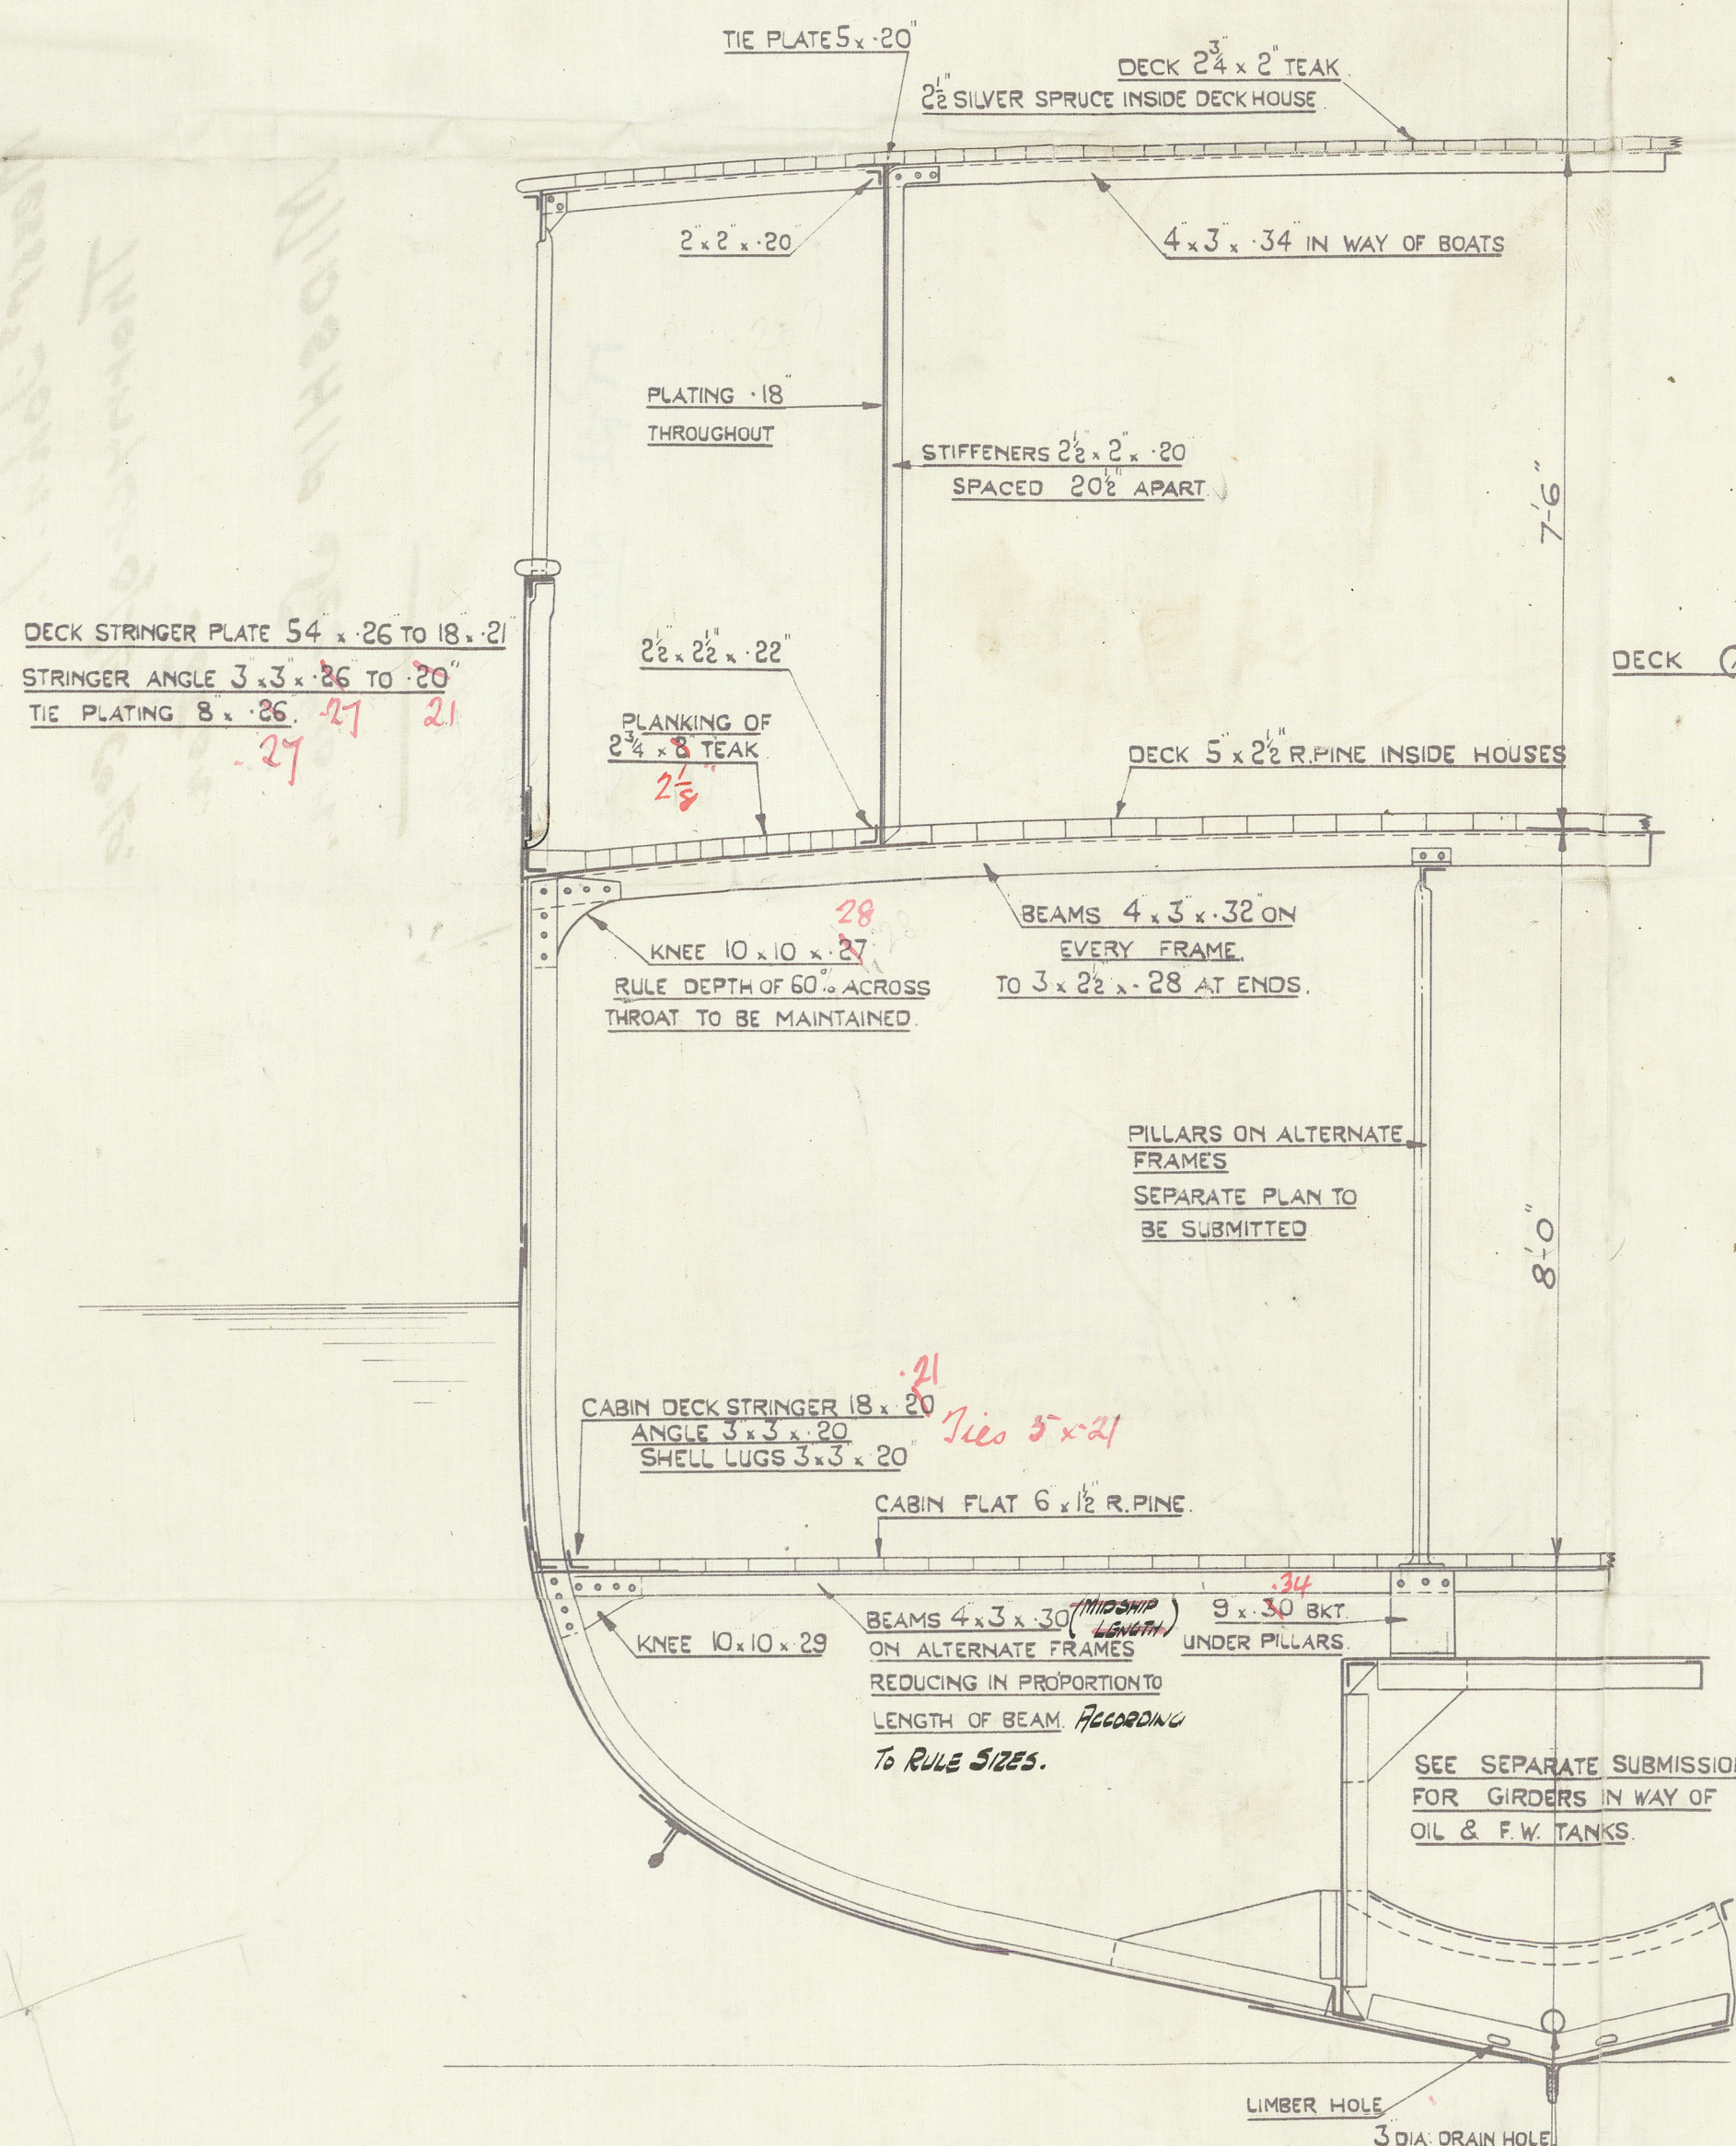

SECTION THRO CABINS & DECKHOUSE

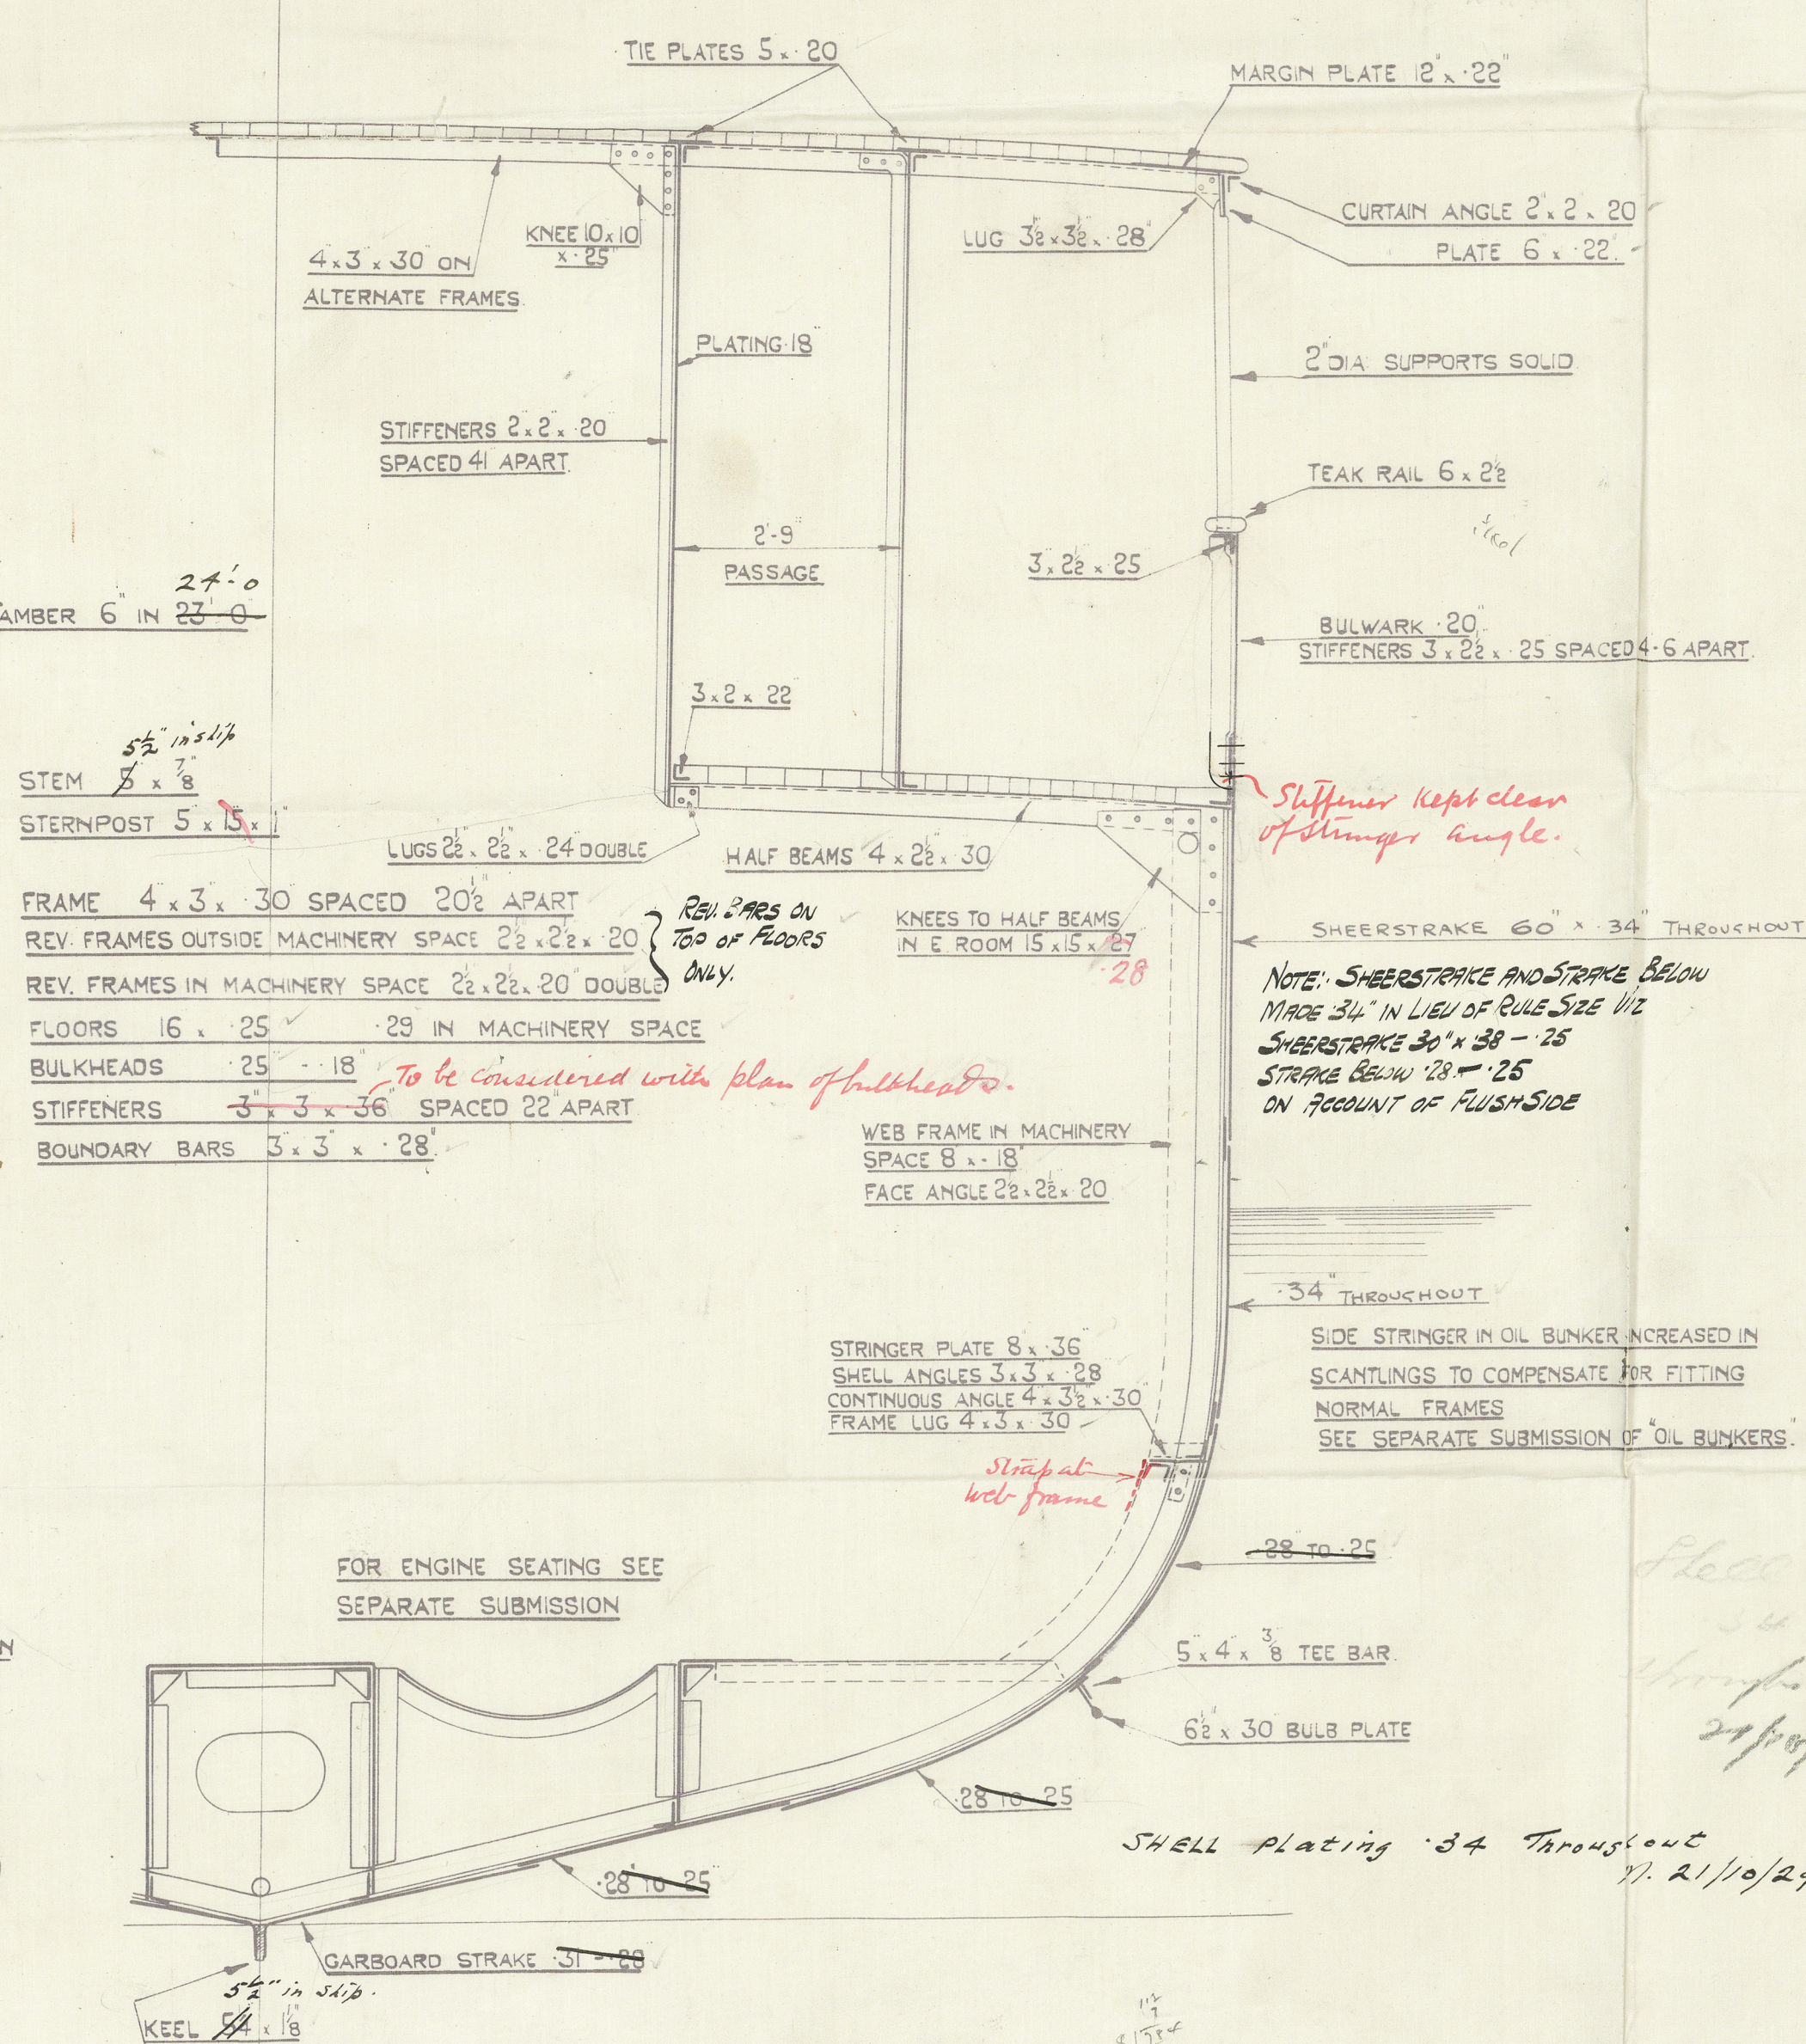

SECTION THRO ENGINE ROOM