

T. S. M. Y.

Nº 1099.

John I. Thornycroft & Co. Ltd.


Sutton

Profile & Decks.

Verified Cpr.
21/10/29.
asa

Rpt NO 17744

GEN. BOX NO 379

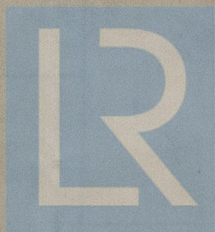

© 2019

Lloyd's Register
Foundation

W307-0167

14/10/29
LLOYD'S
STAMP


T. S. MOTOR YACHT PROFILE AND DECKS.

SCALE 1/4" = 1 FOOT


PRINCIPAL DIMENSIONS

LENGTH WL 34'-0"
BREADTH MD 23'-0" 23'-6"
DEPTH MD 3'-3" 2/10/29

TO CLASS 100 * A.1. AT LLOYDS.

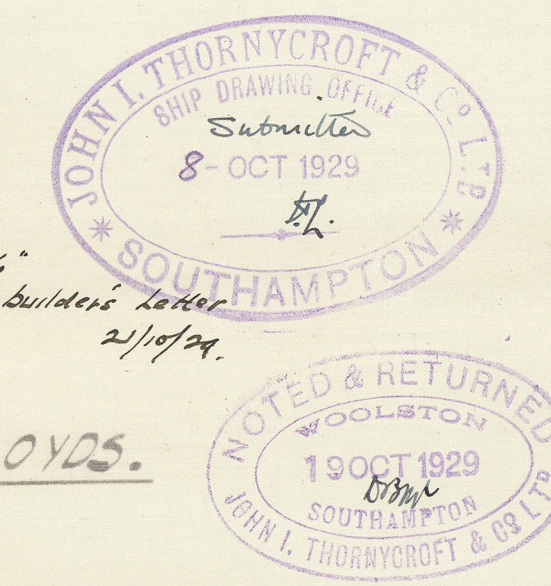

LLOYD'S MEASURES			
1	38.83		
2	1.5	11.75	
3	13.25		
4	24.75	25.00	
5	12.47		
6	53.63%	53%	
DISPLACEMENT = 2470.75			

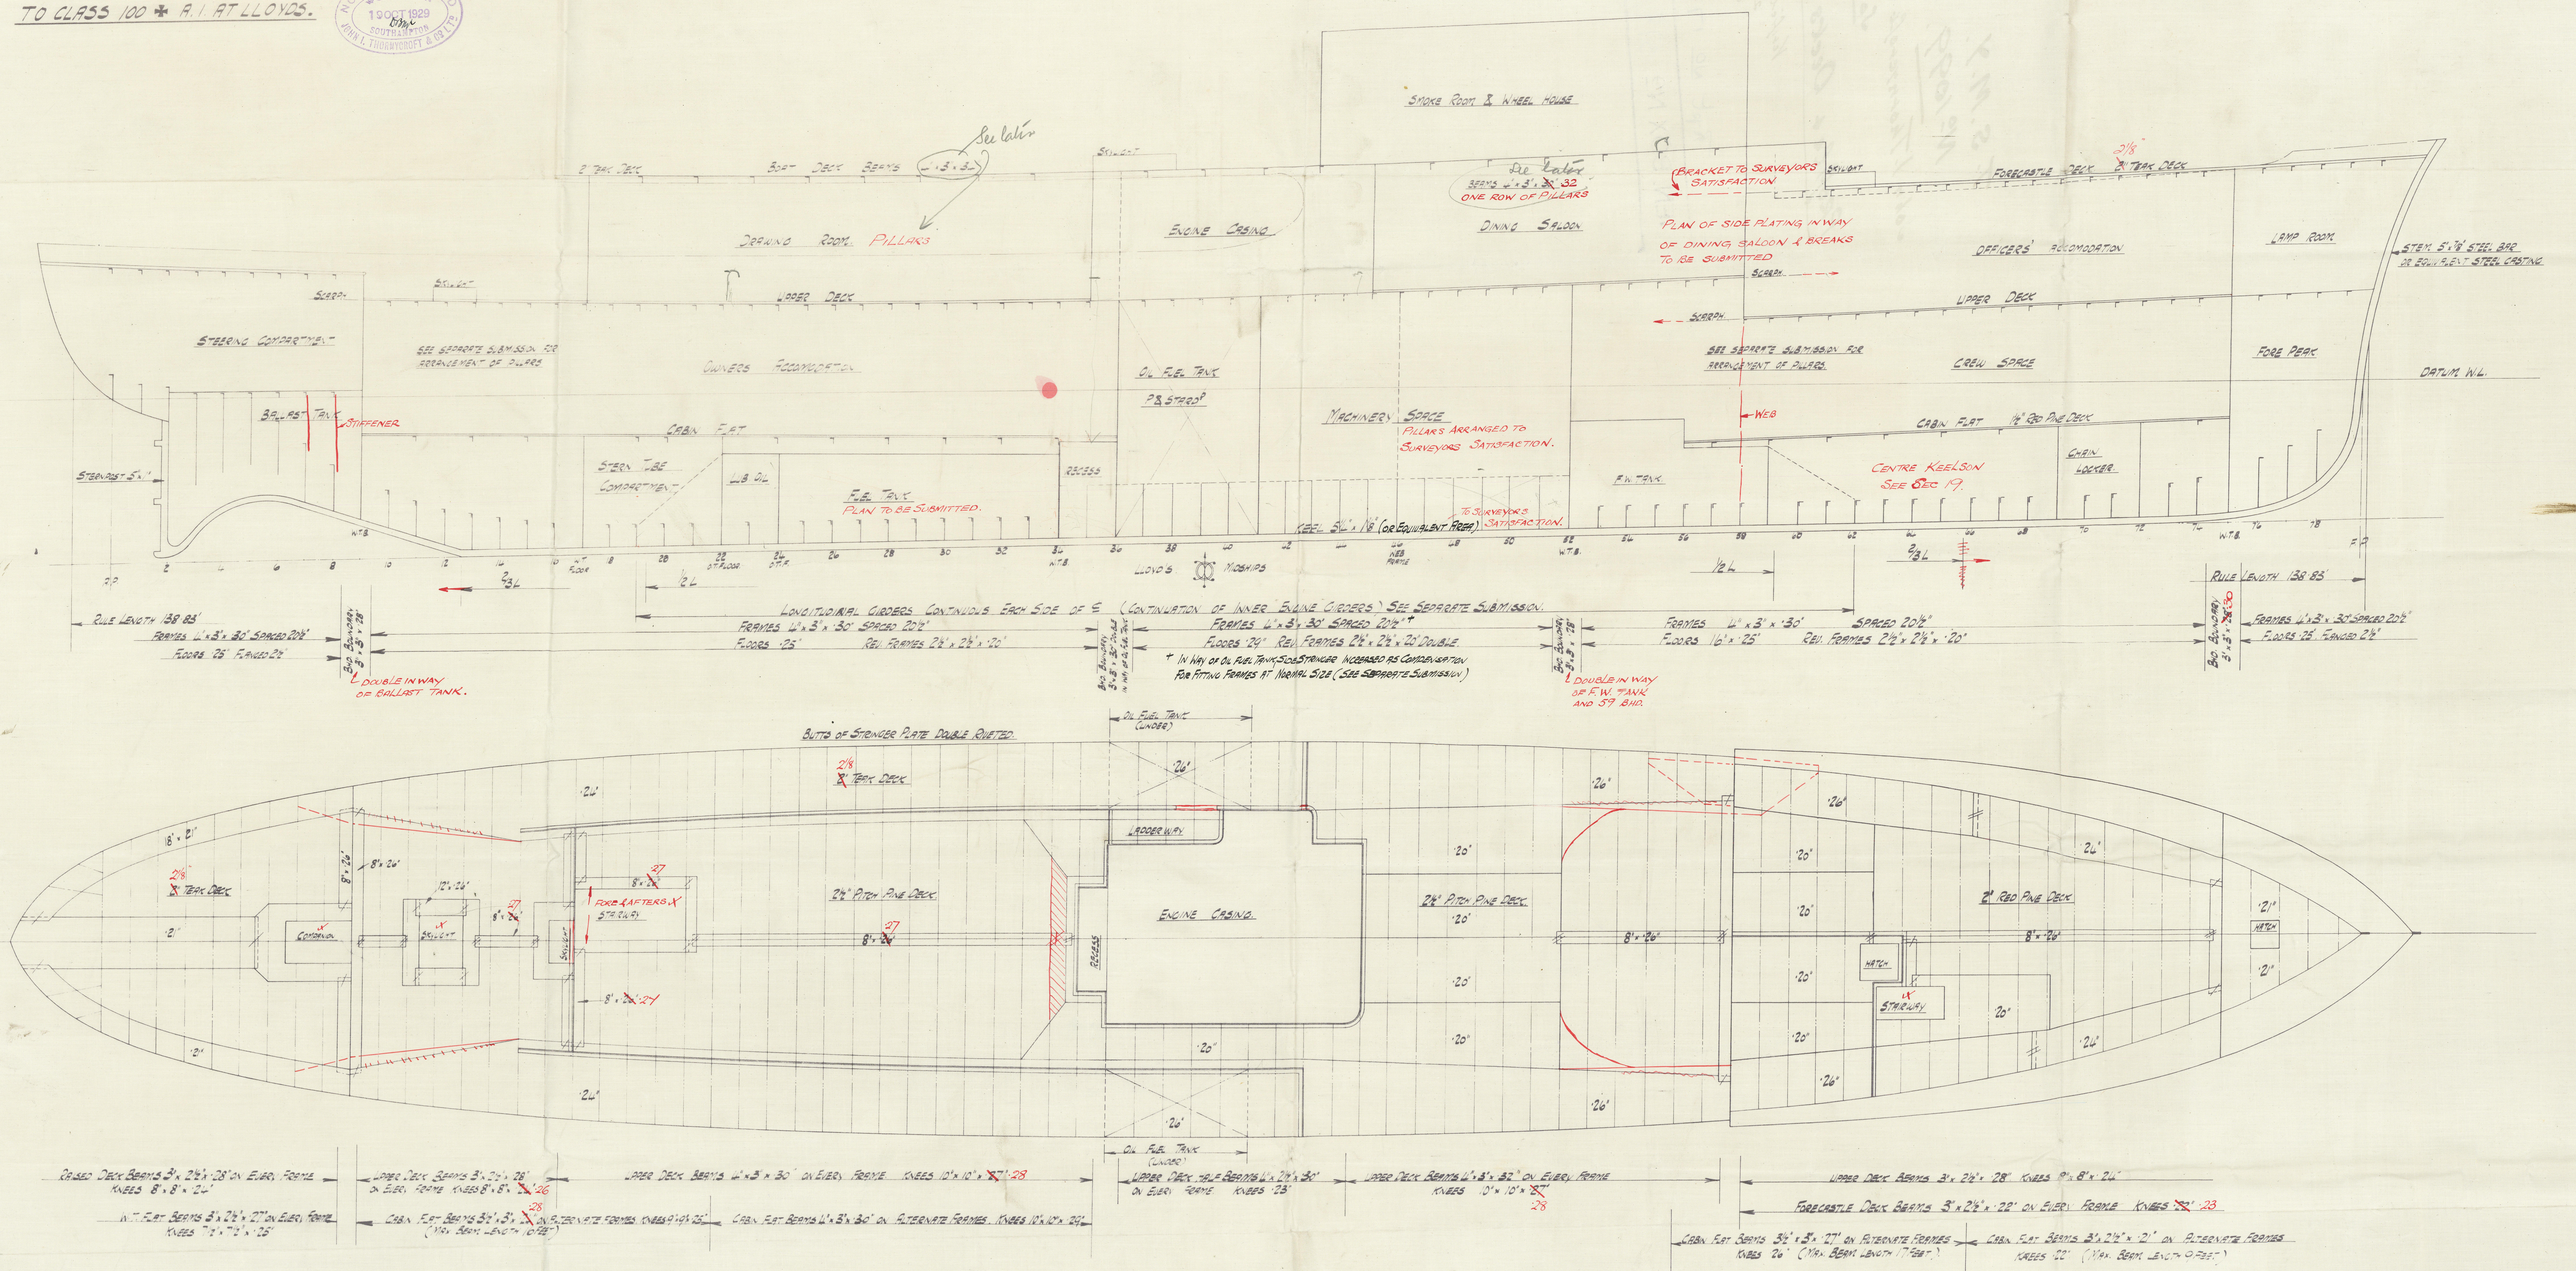

Ship No
1099.

1079/29.