

Anna Marie Rpt No
17744

L. Gaednee + Son

519 Engine
for

J. S. Schoeneycroft's

vessel No. 1099

Shaft




© 2019

Lloyd's Register
Foundation


W307-0169

24/10/29

8-1" B HOLES
TO DRILL JIG NO 3931.

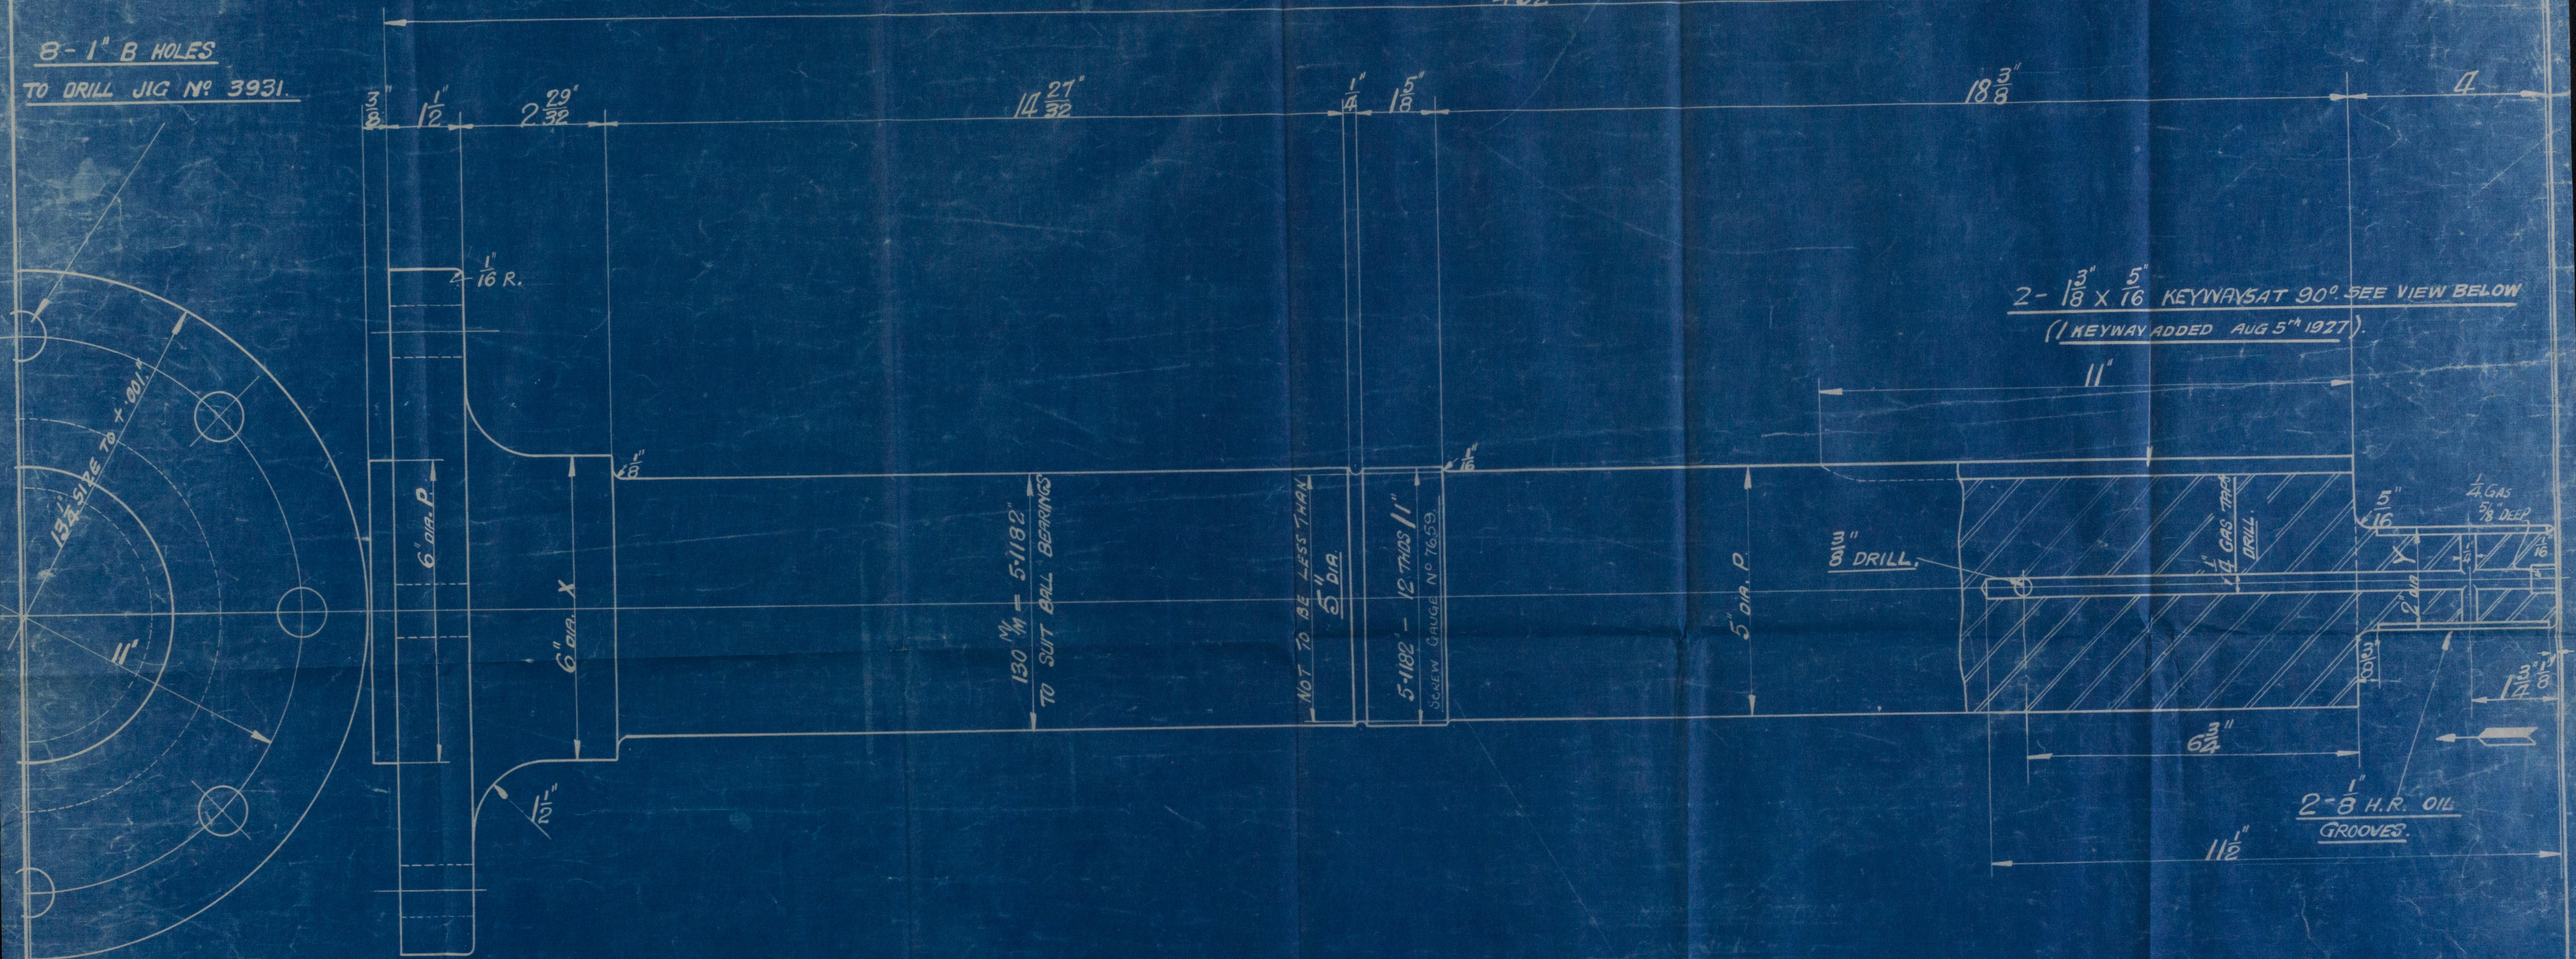

2-1 3/8 x 5/16 KEYWAYS AT 90°. SEE VIEW BELOW
(1 KEYWAY ADDED AUG 5th 1927).

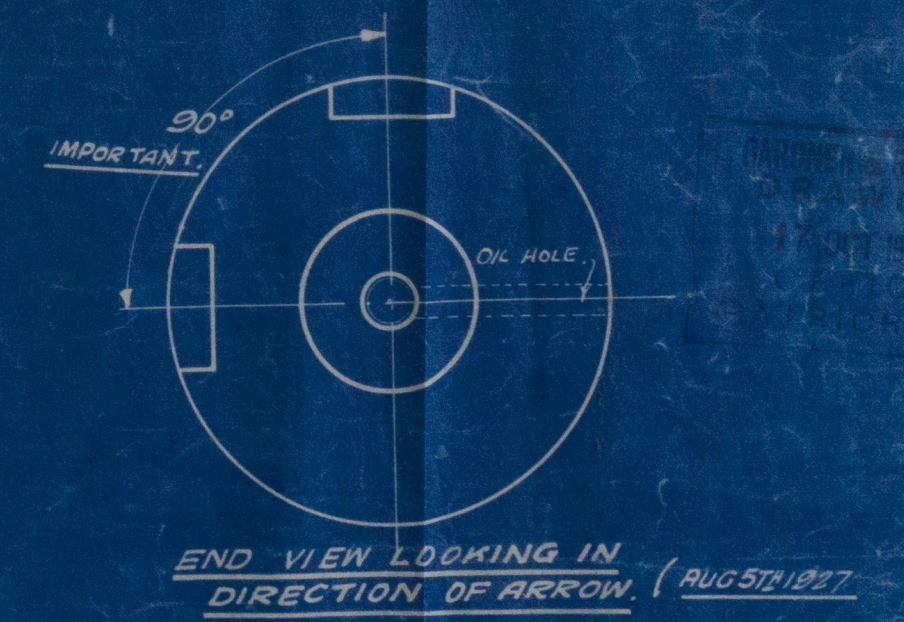

7012-5.6J9
FOR ASSEMBLY SEE DWG. 5867-6.T.9.

TYPE NO 9 CLUTCH (FOR 6T9 ENGINES) ALSO FOR 5&6J9 ENGINES.

DESCRIPTION THRUST SHAFT

L. GARDNER & SONS, LTD.
PATRICROFT

SCALE HALF FULL SIZE.

MATERIAL
28/32 TON. M. S.
DATE 25.6.26.

MACHINED
JIG NOS

SUPERSEDES
SUPERSEDED BY
DRAWN BY
TRACED BY
CHECKED BY

DWG. NO. 6277W