
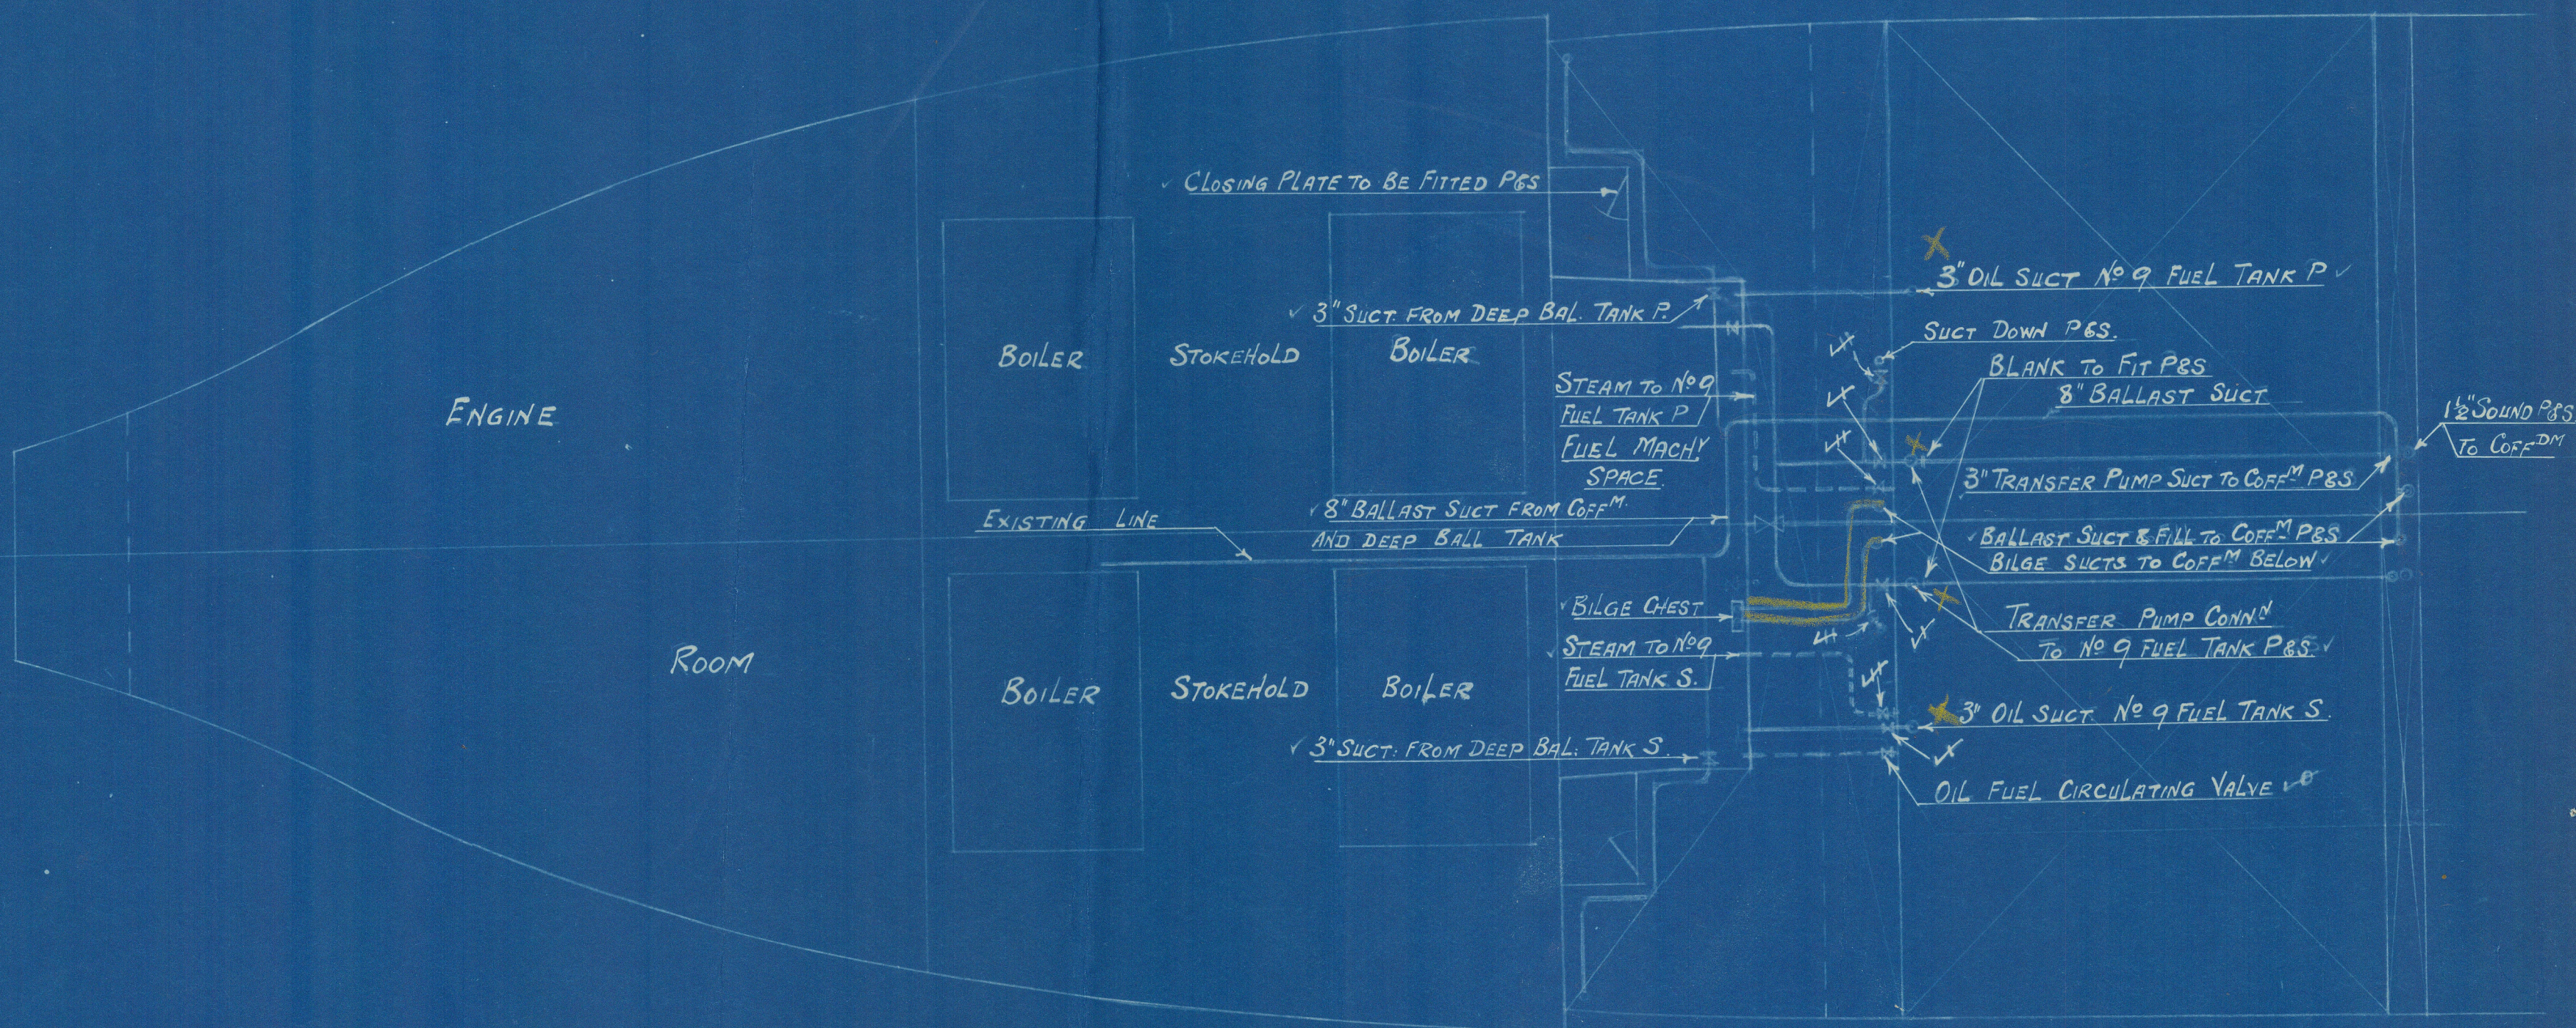


# S.S. "IROQUOIS"

DIAGRAMMATIC ARRANGEMENT OF PIPES IN WAY OF DEEP BALLAST TANK ETC.

SCALE 1/8" = 1 FOOT

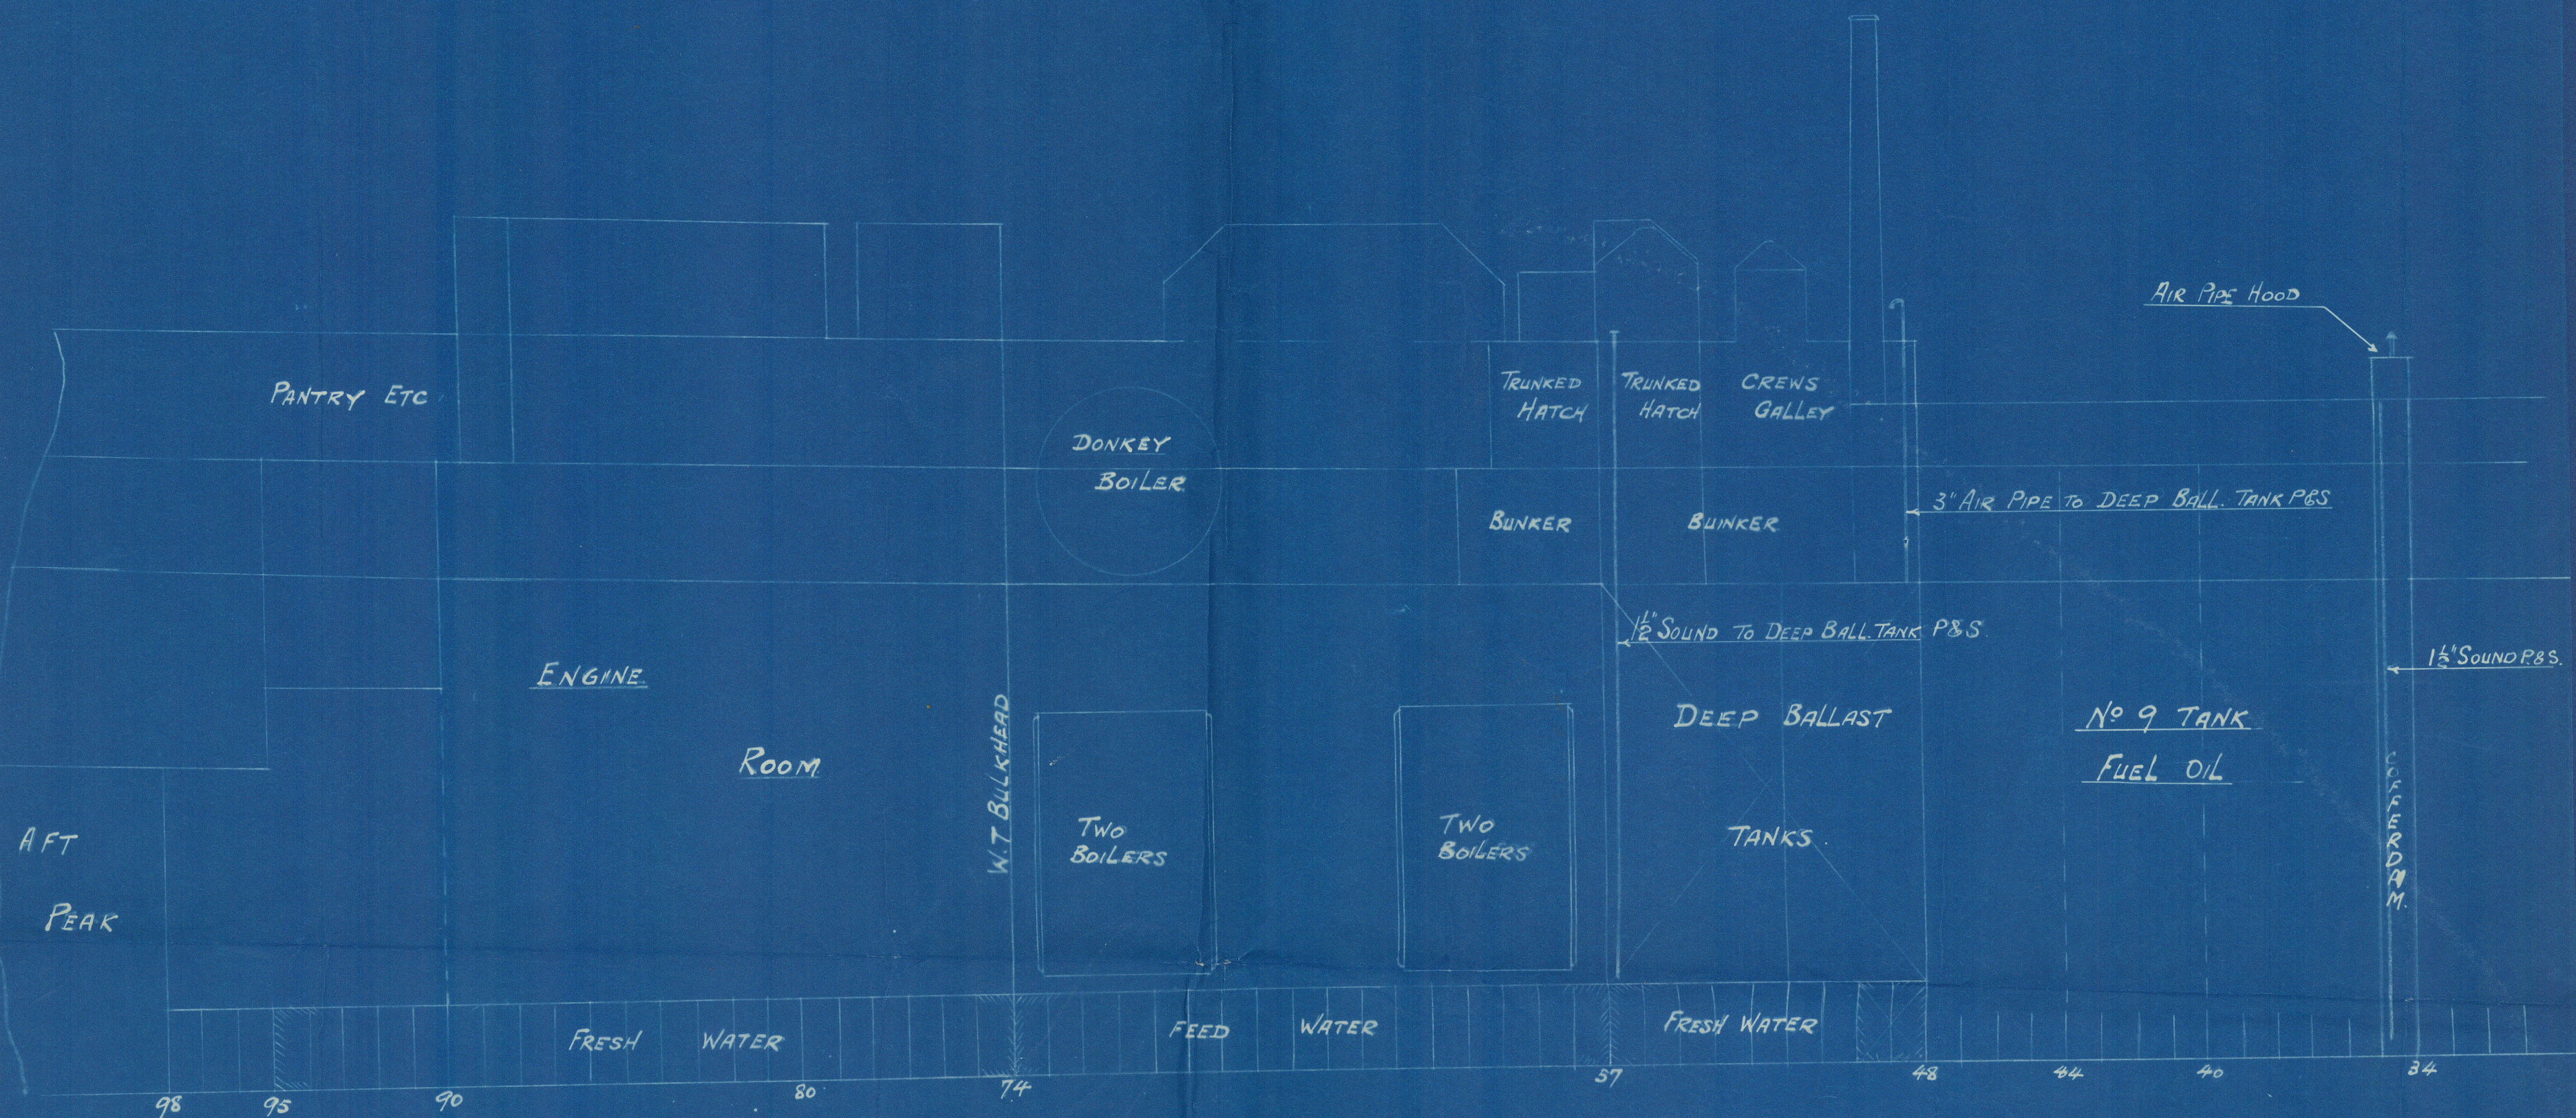

VALVES MARKED V<sup>o</sup> TO BE BLANKED OFF

" " TO BE REMOVED

" " TO BE FITTED IN FUEL MACHY SPACE.

The front part of the oil tank is to be above 100 ft. and the remaining requirements of section 22 of the rules (1934-35) to be carried out as far as they are applicable.

The remaining requirements of section 22 of the rules (1934-35) to be carried out.

See letter.

3108

5-10-34



Lloyd's Register Foundation

W 309-0061



London  
Copy

St. Reguoir.

Bel. Rept. No. 1140x.

Arrangement of pipes in way of  
deep ballast tank.

W309 - 0061



© 2021

Lloyd's Register  
Foundation