



LONDON COPY.

S.S. "IROQUOIS"

DIAGRAMMATIC ARRGT OF PIPES IN WAY OF DEEP BALLAST TANK ETC.

SCALE 1/8" = 1 FOOT

FOR VESSEL CARRYING CARGO OIL. (NOT PETROLEUM) [?] See letter

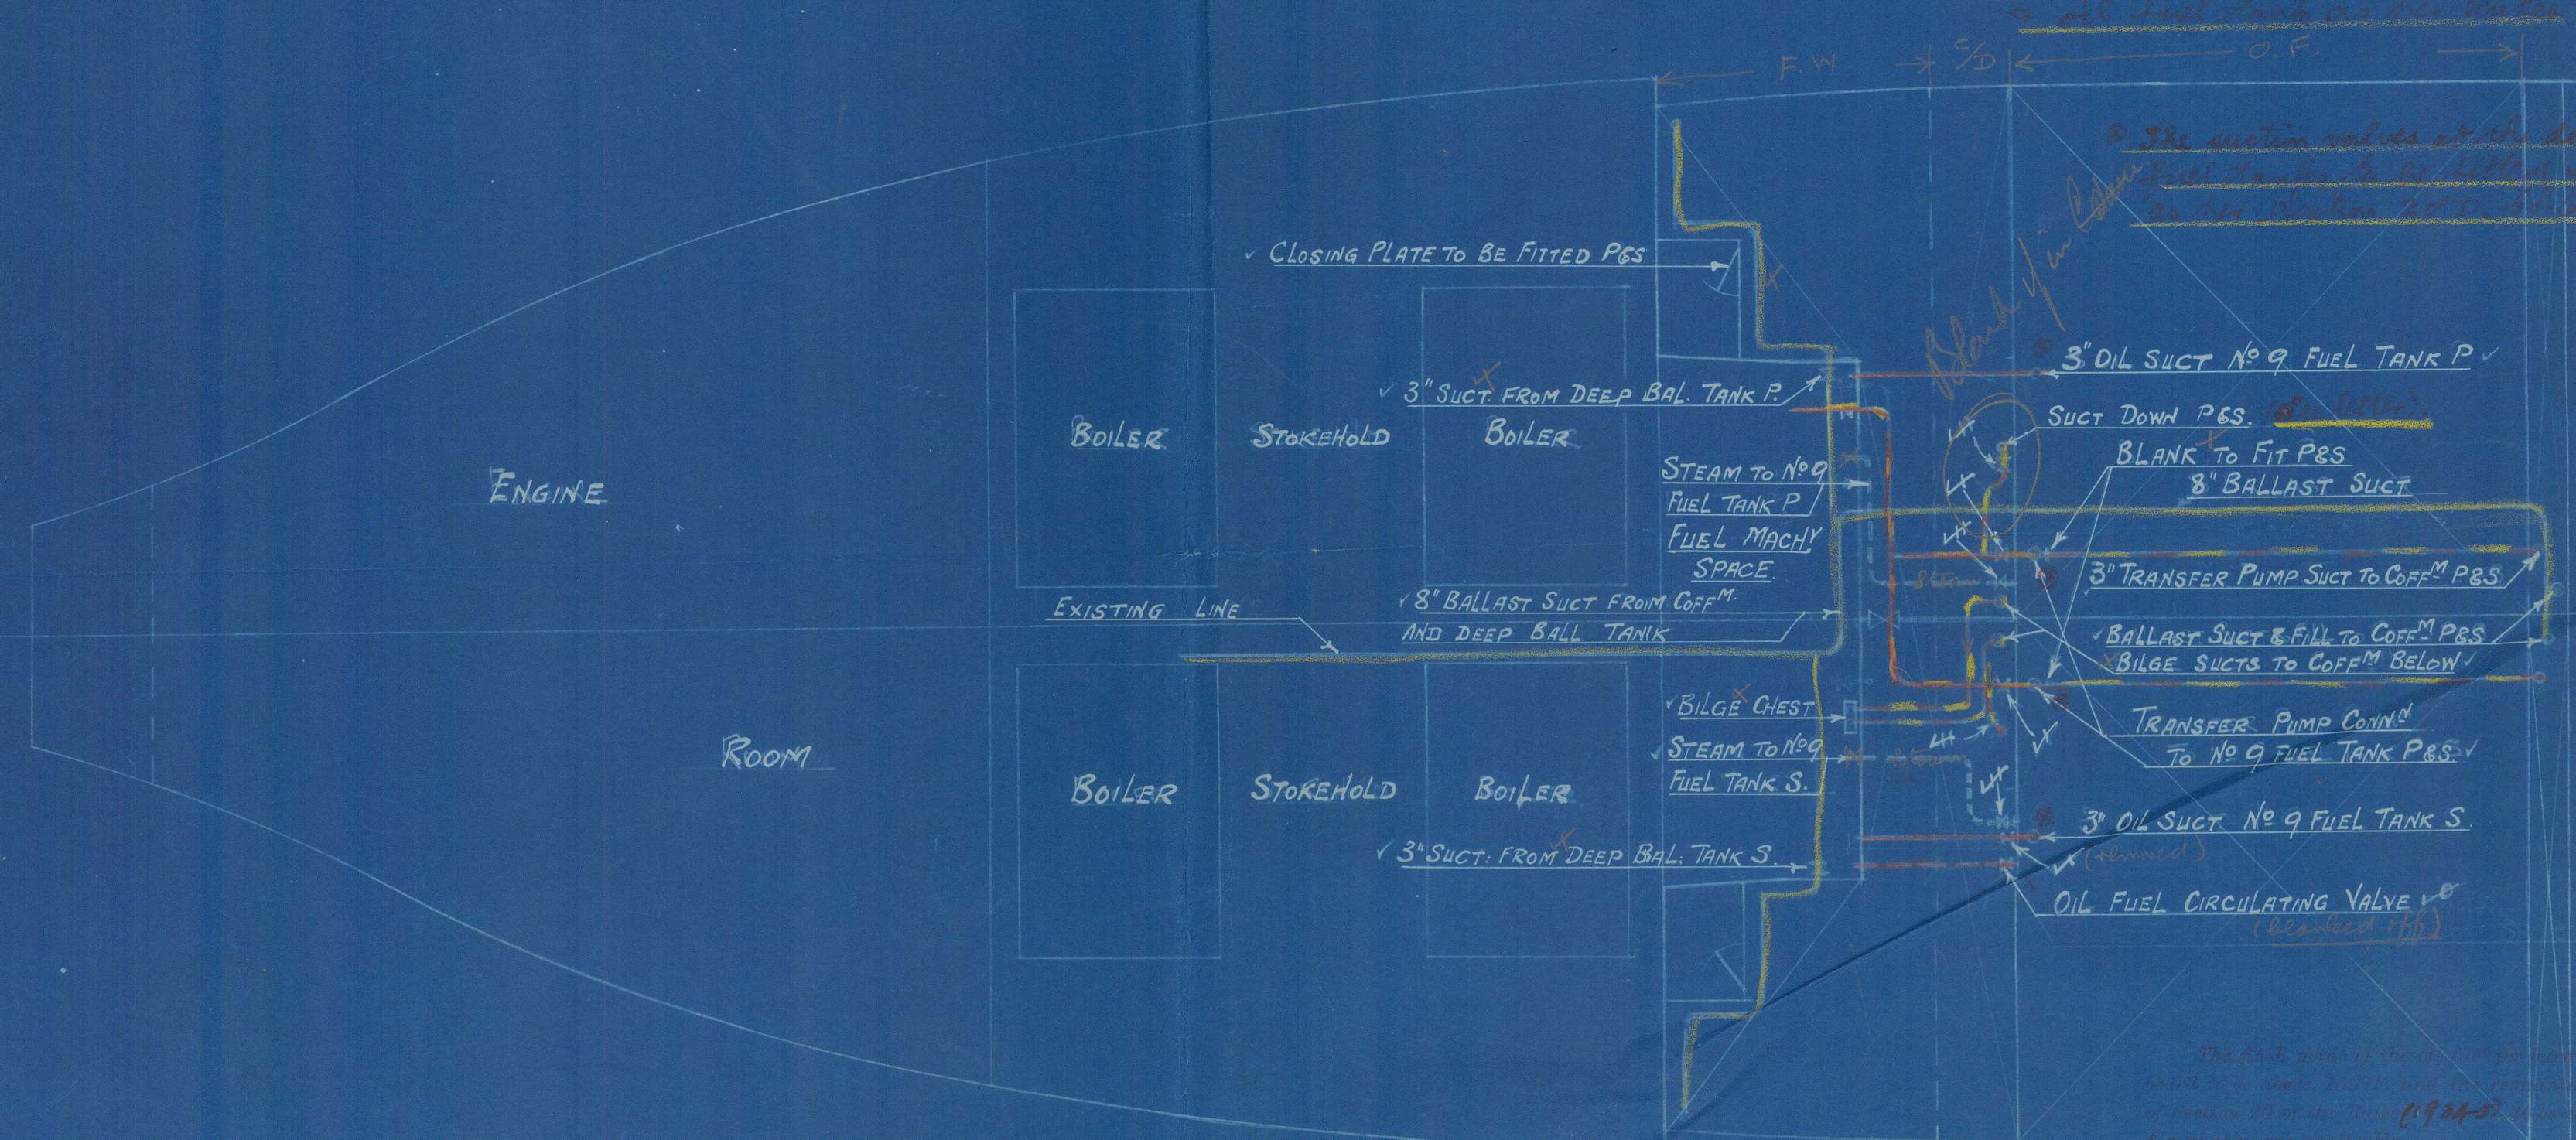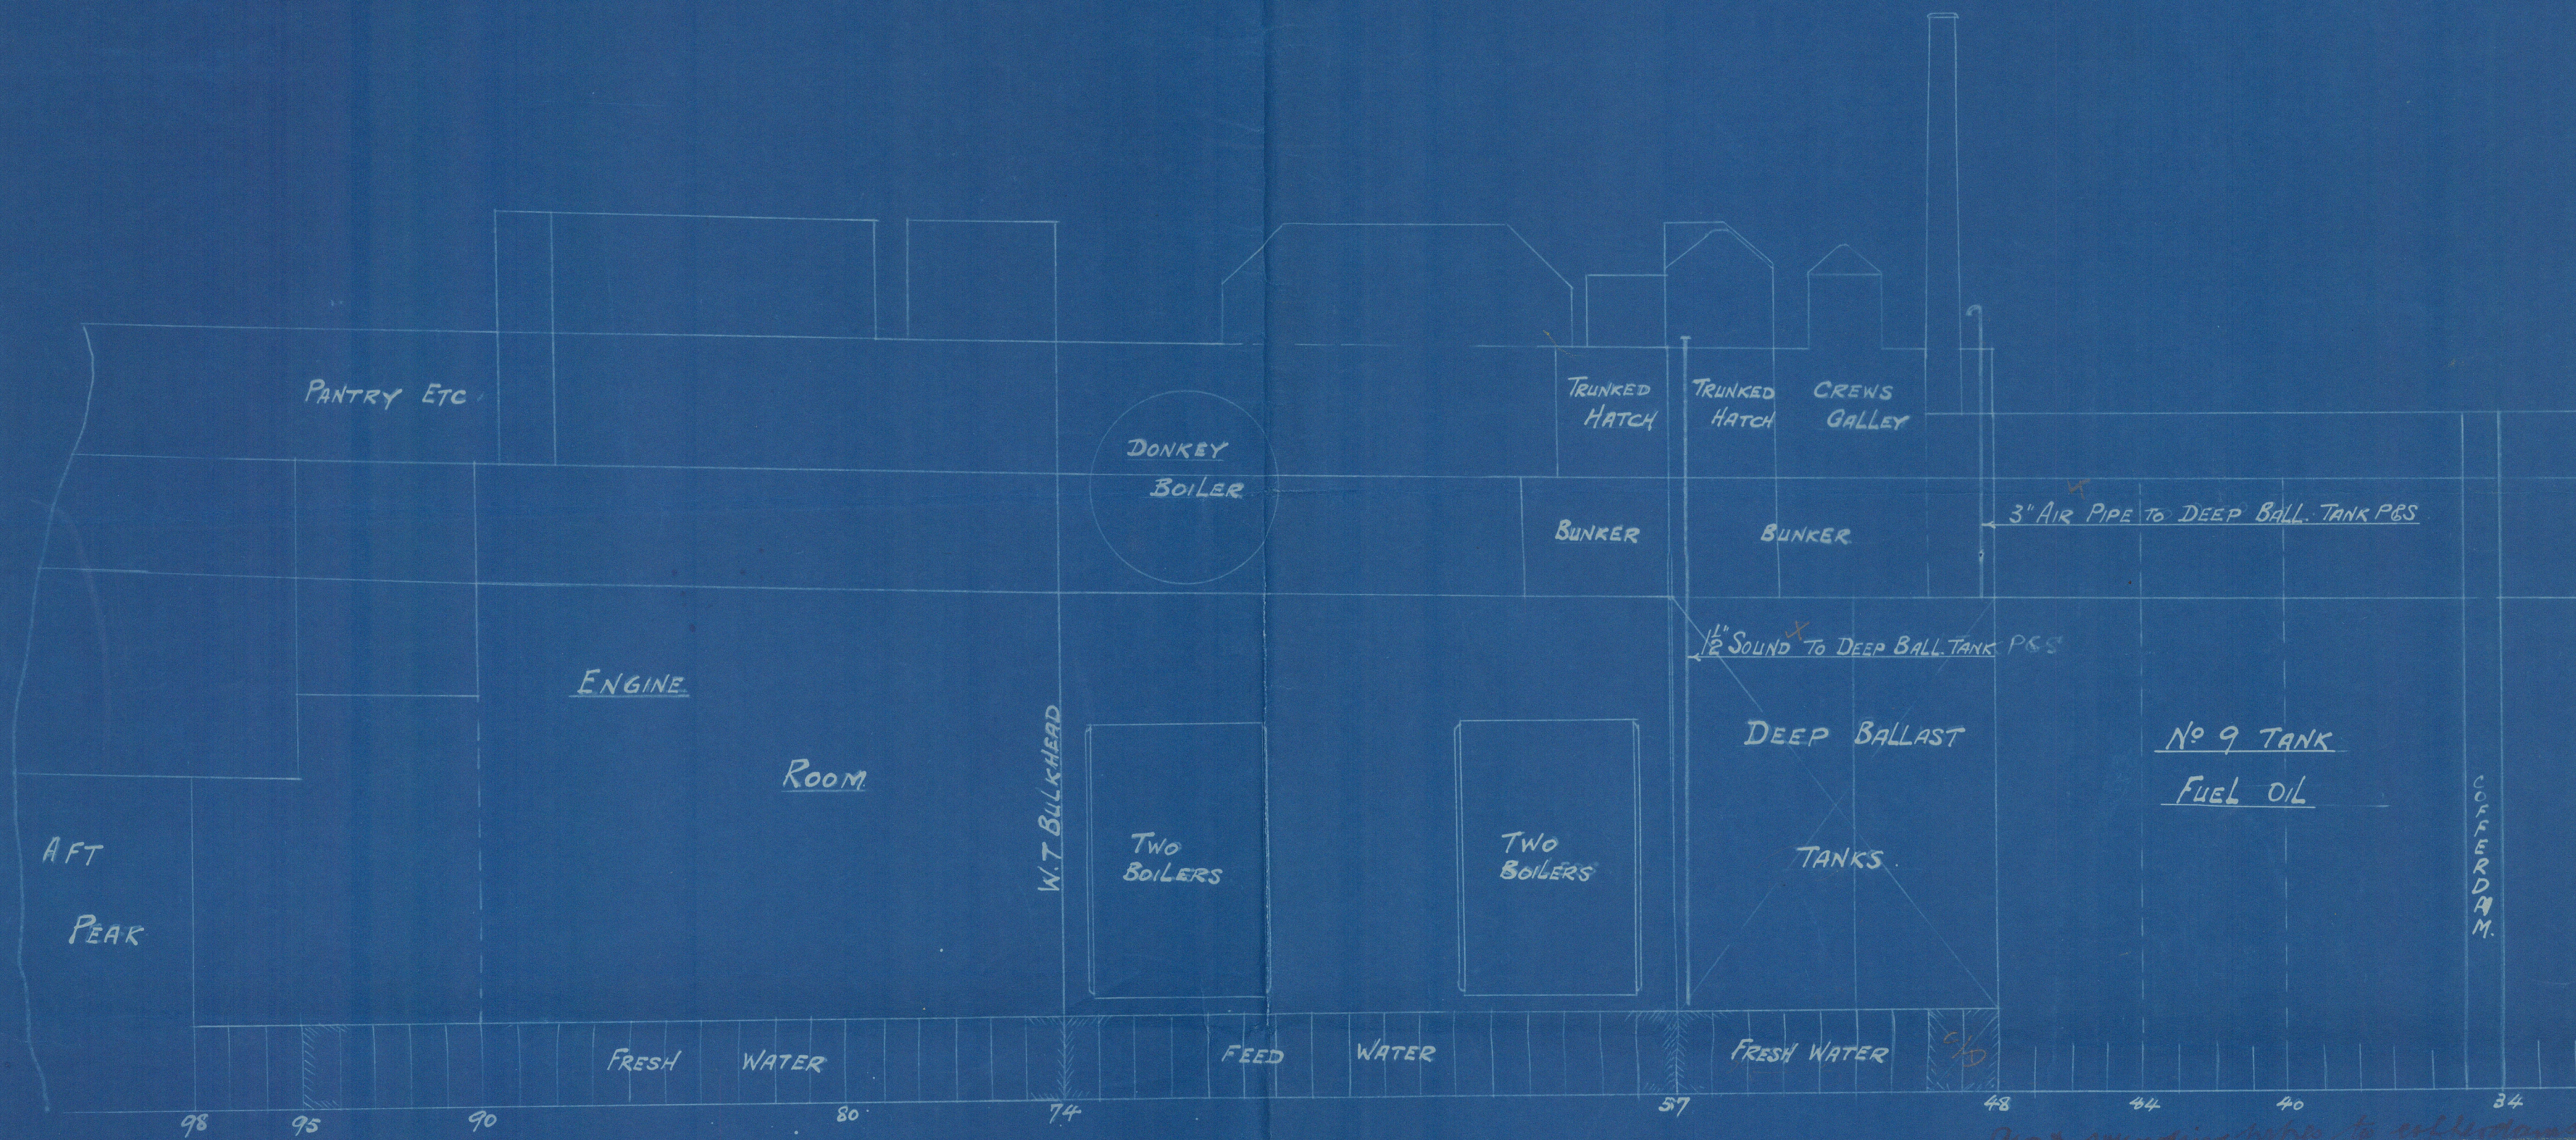

VALVES MARKED ∇ TO BE BLANKED OFF
" " ∇ TO BE REMOVED
" " ∇ TO BE FITTED IN FUEL MACHY SPACE.

The bulk point of the oil fuel for landing purposes to be blanked off as per Section 10 of the Rules (1934-5) as to be supplied with oil as they are applicable.

The remaining requirements of Section 11 of the Rules (1934-5) to be complied with.

LONDON COPY

S.S. Inguois.

Ref. Rept. No. 11404.

Arrangement of pipes in way of deck
ballast tank

LONDON COPY

W309 - 0062



© 2021

Lloyd's Register
Foundation