



S.S. IROQUOIS - PILLARS & GIRDERS IN BOILER-ROOM, AS FITTED FOR TONNAGE REQUIREMENTS.


SCALE: $\frac{1}{4}'' = 1 \text{ FOOT}$.

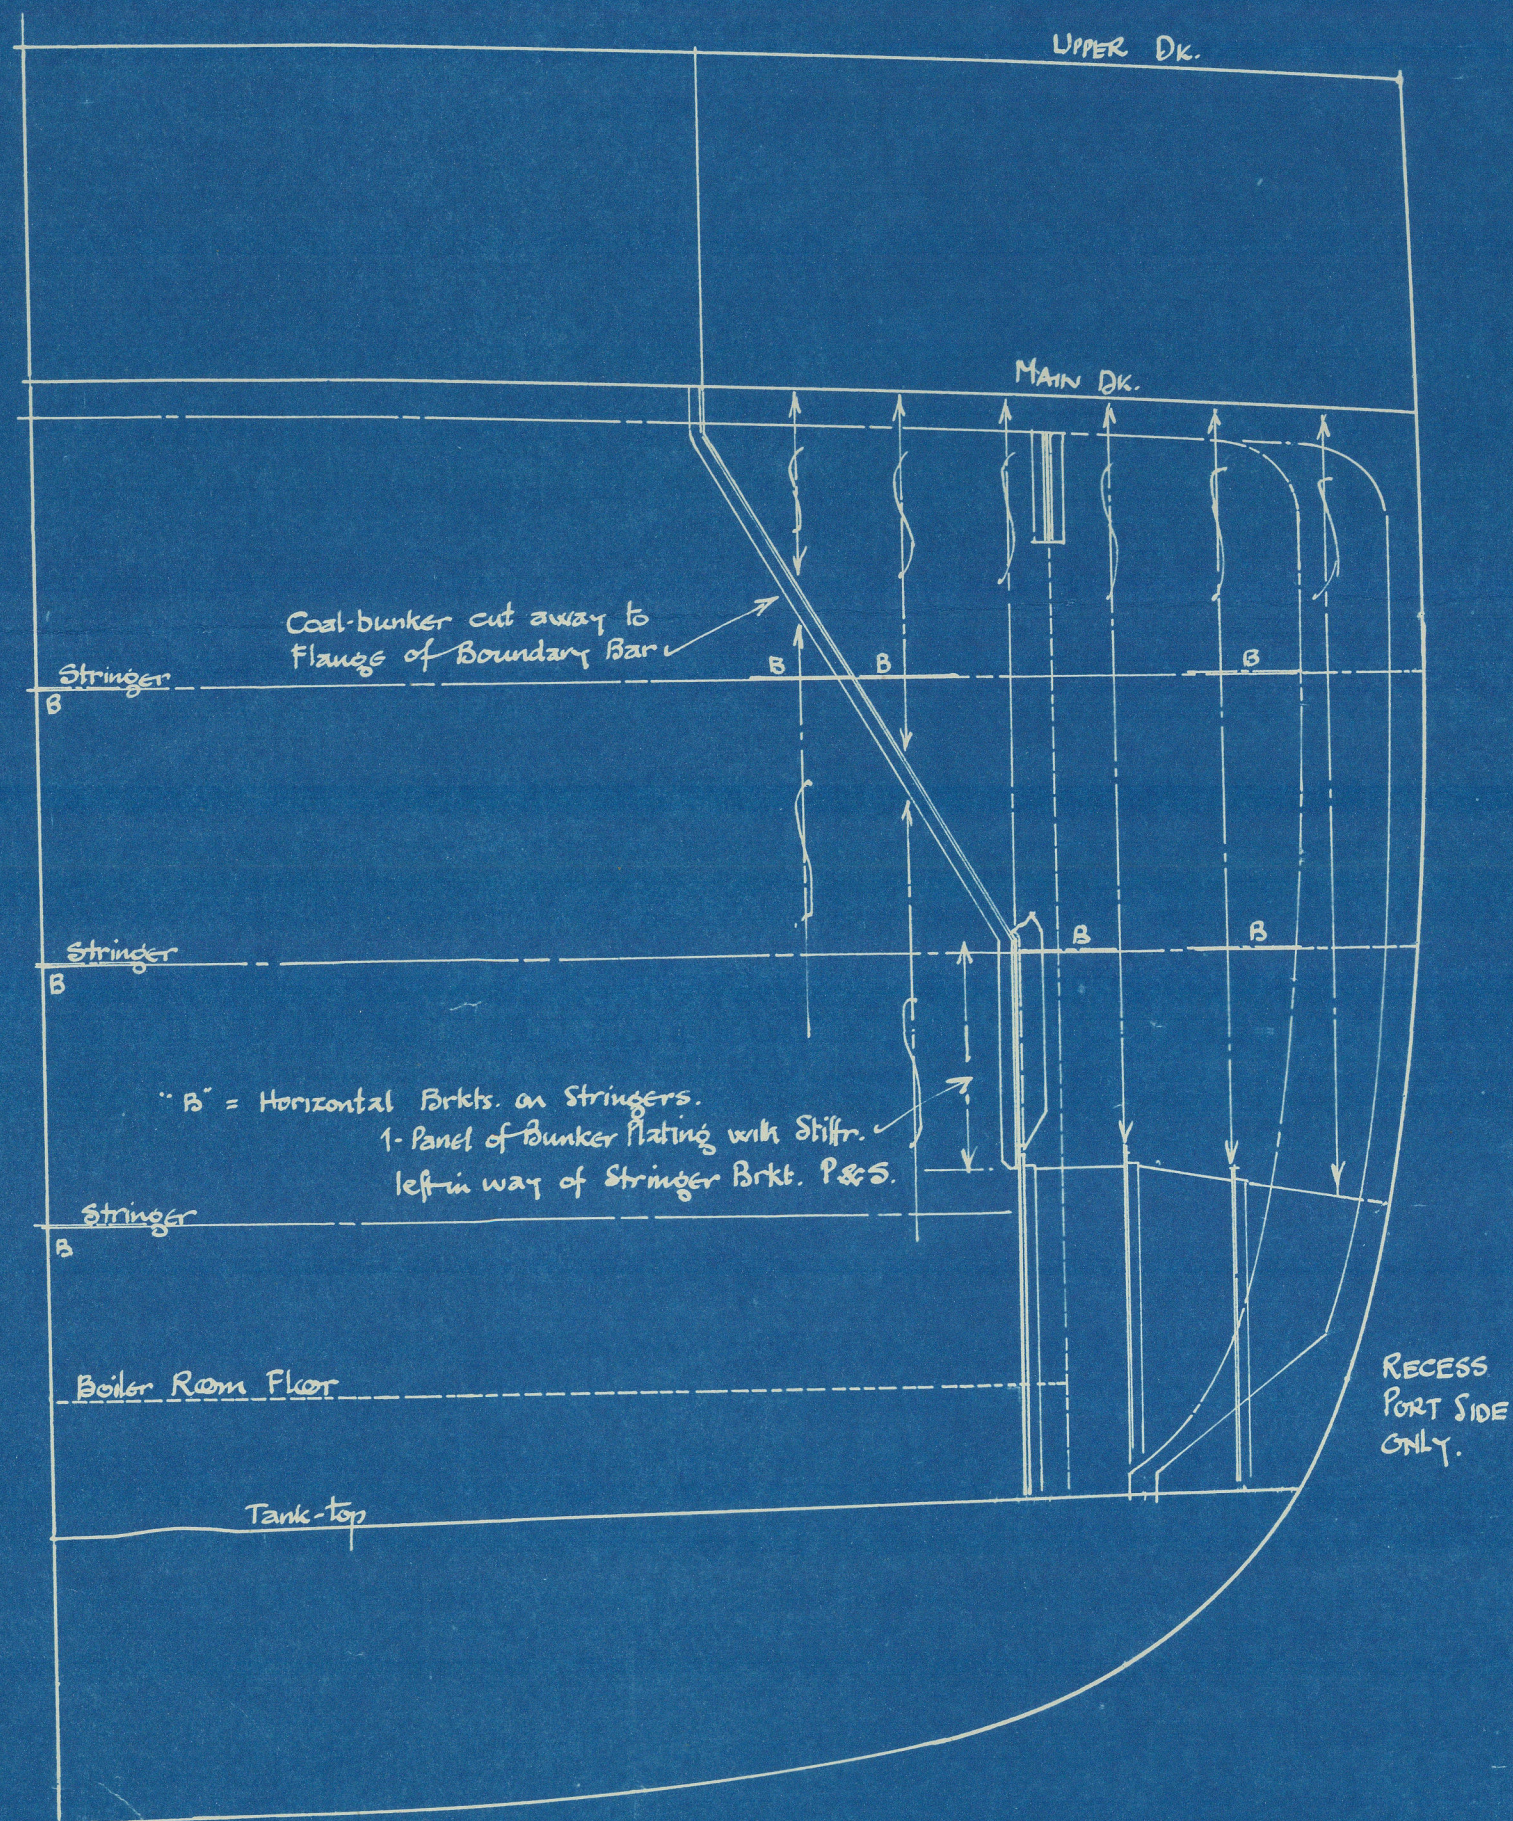


Bhd. 74 Looking Aft.

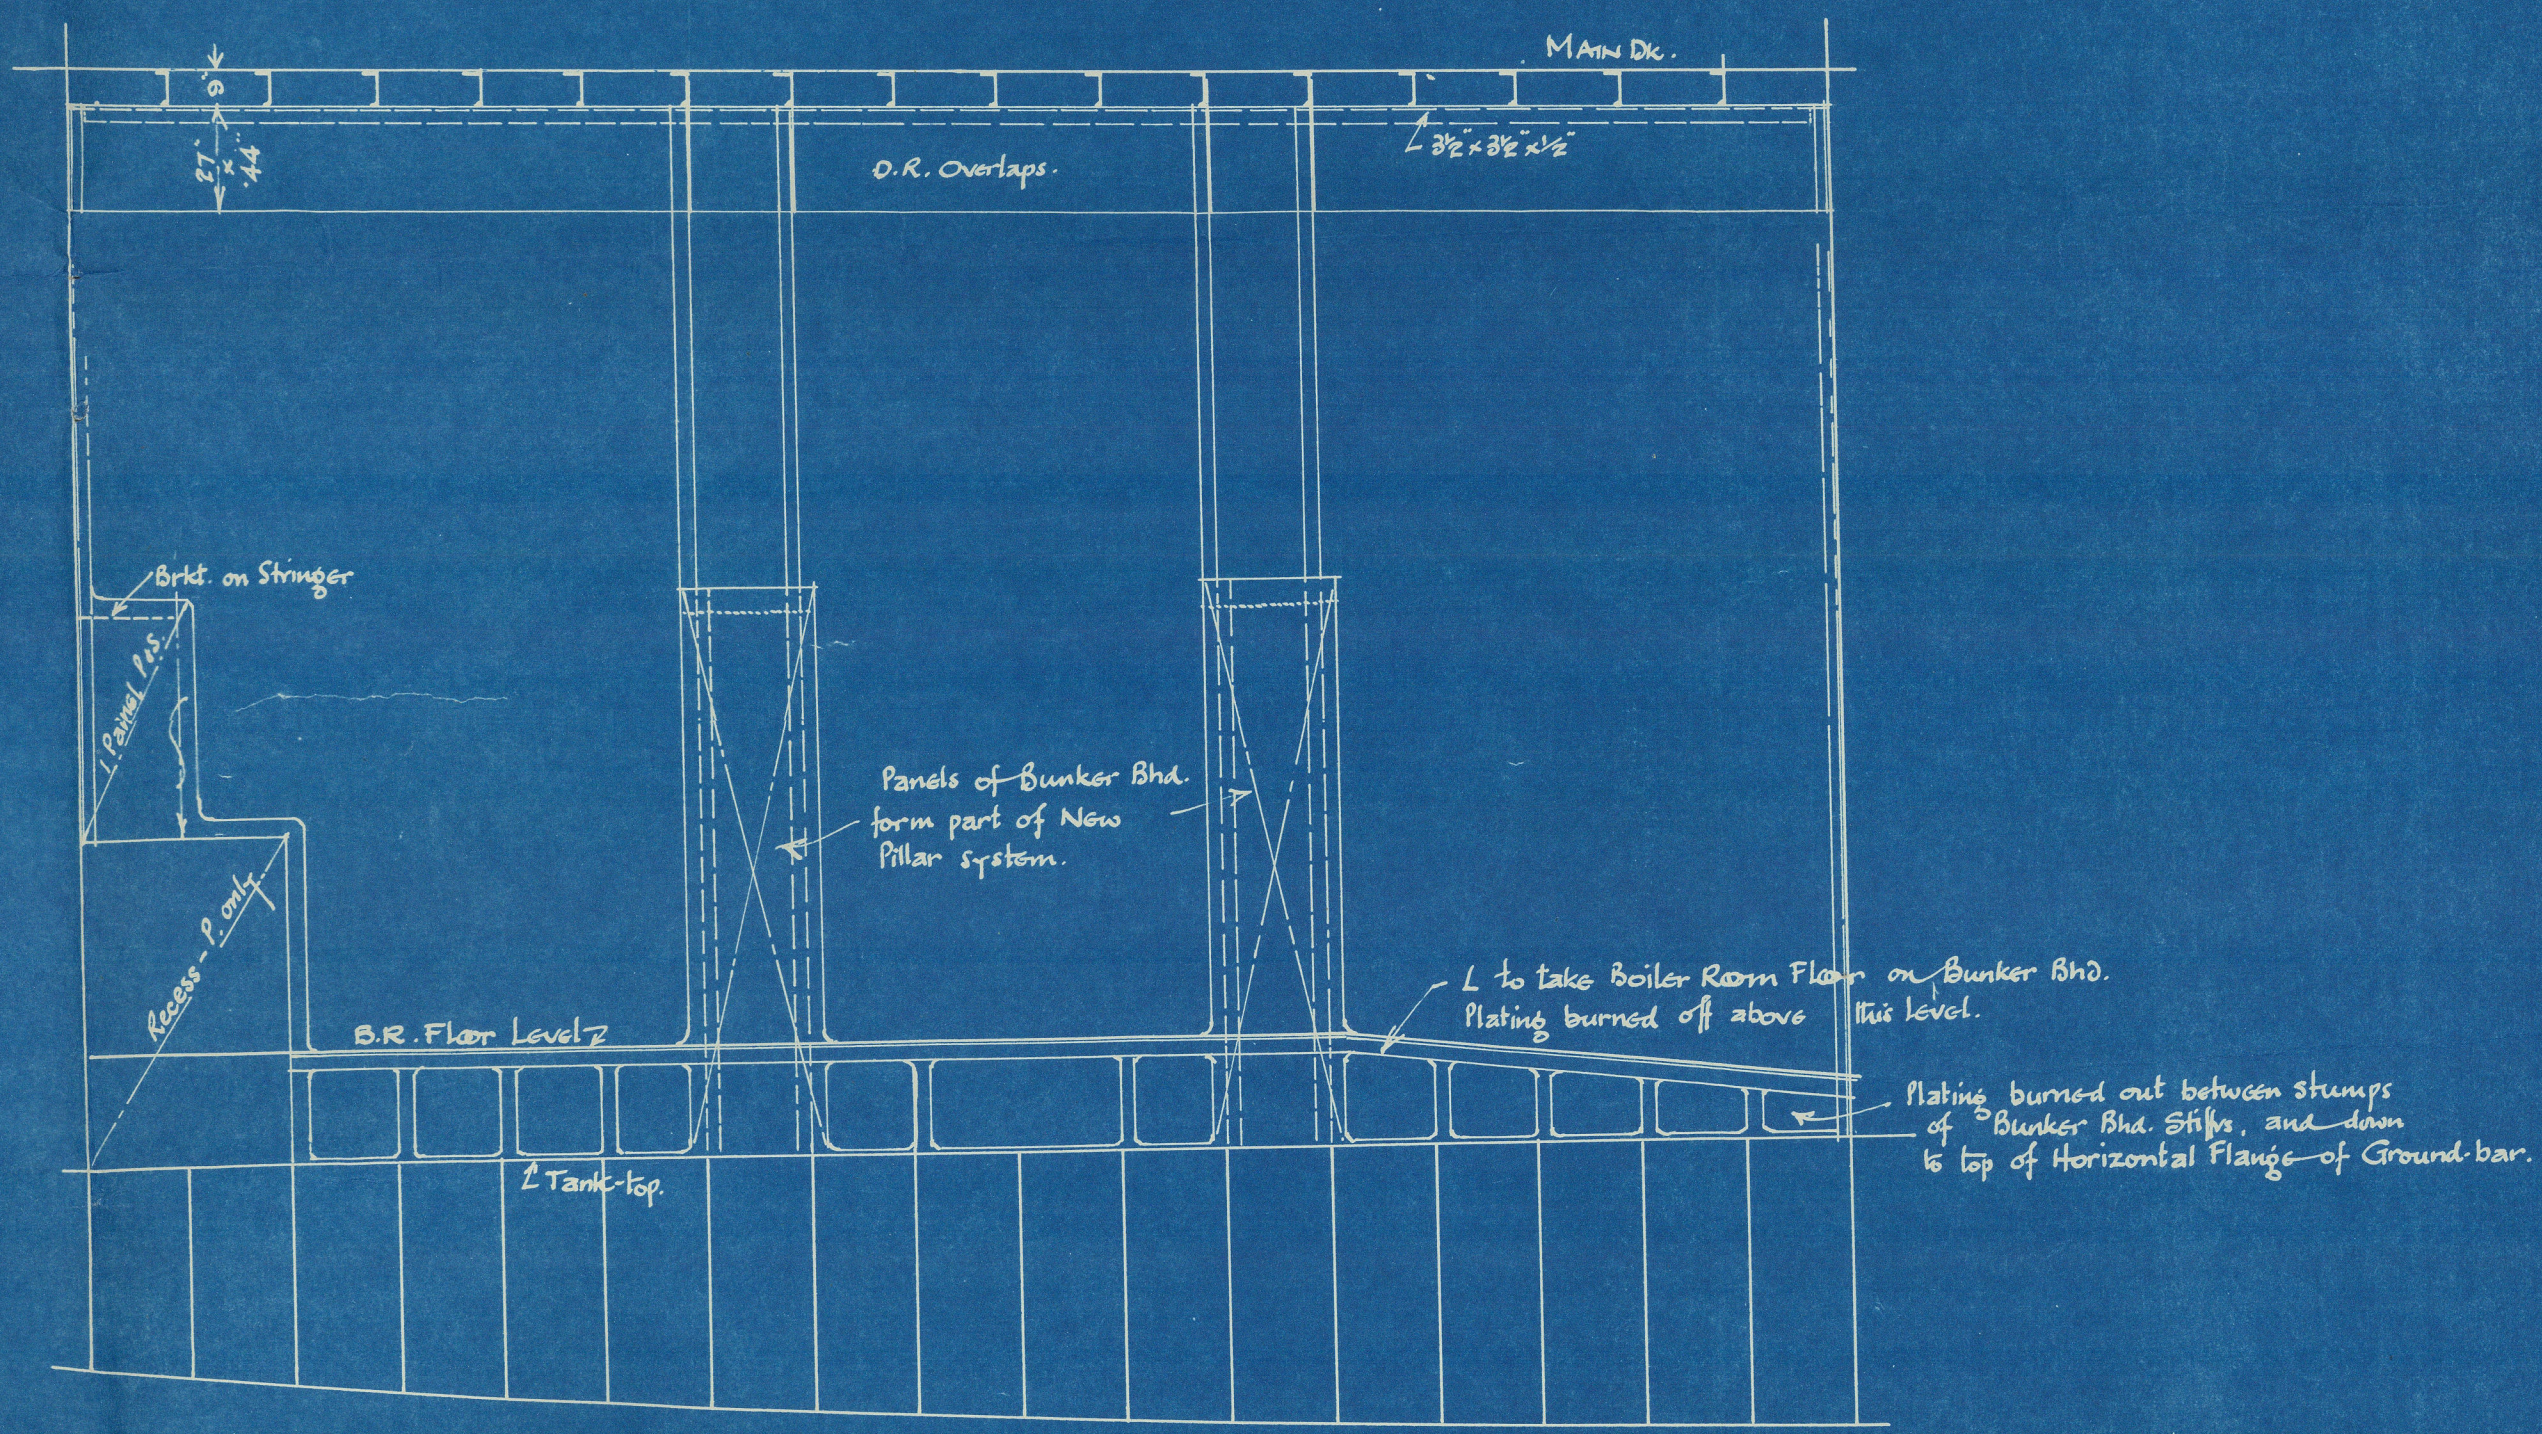

Elevation - Looking to Port.

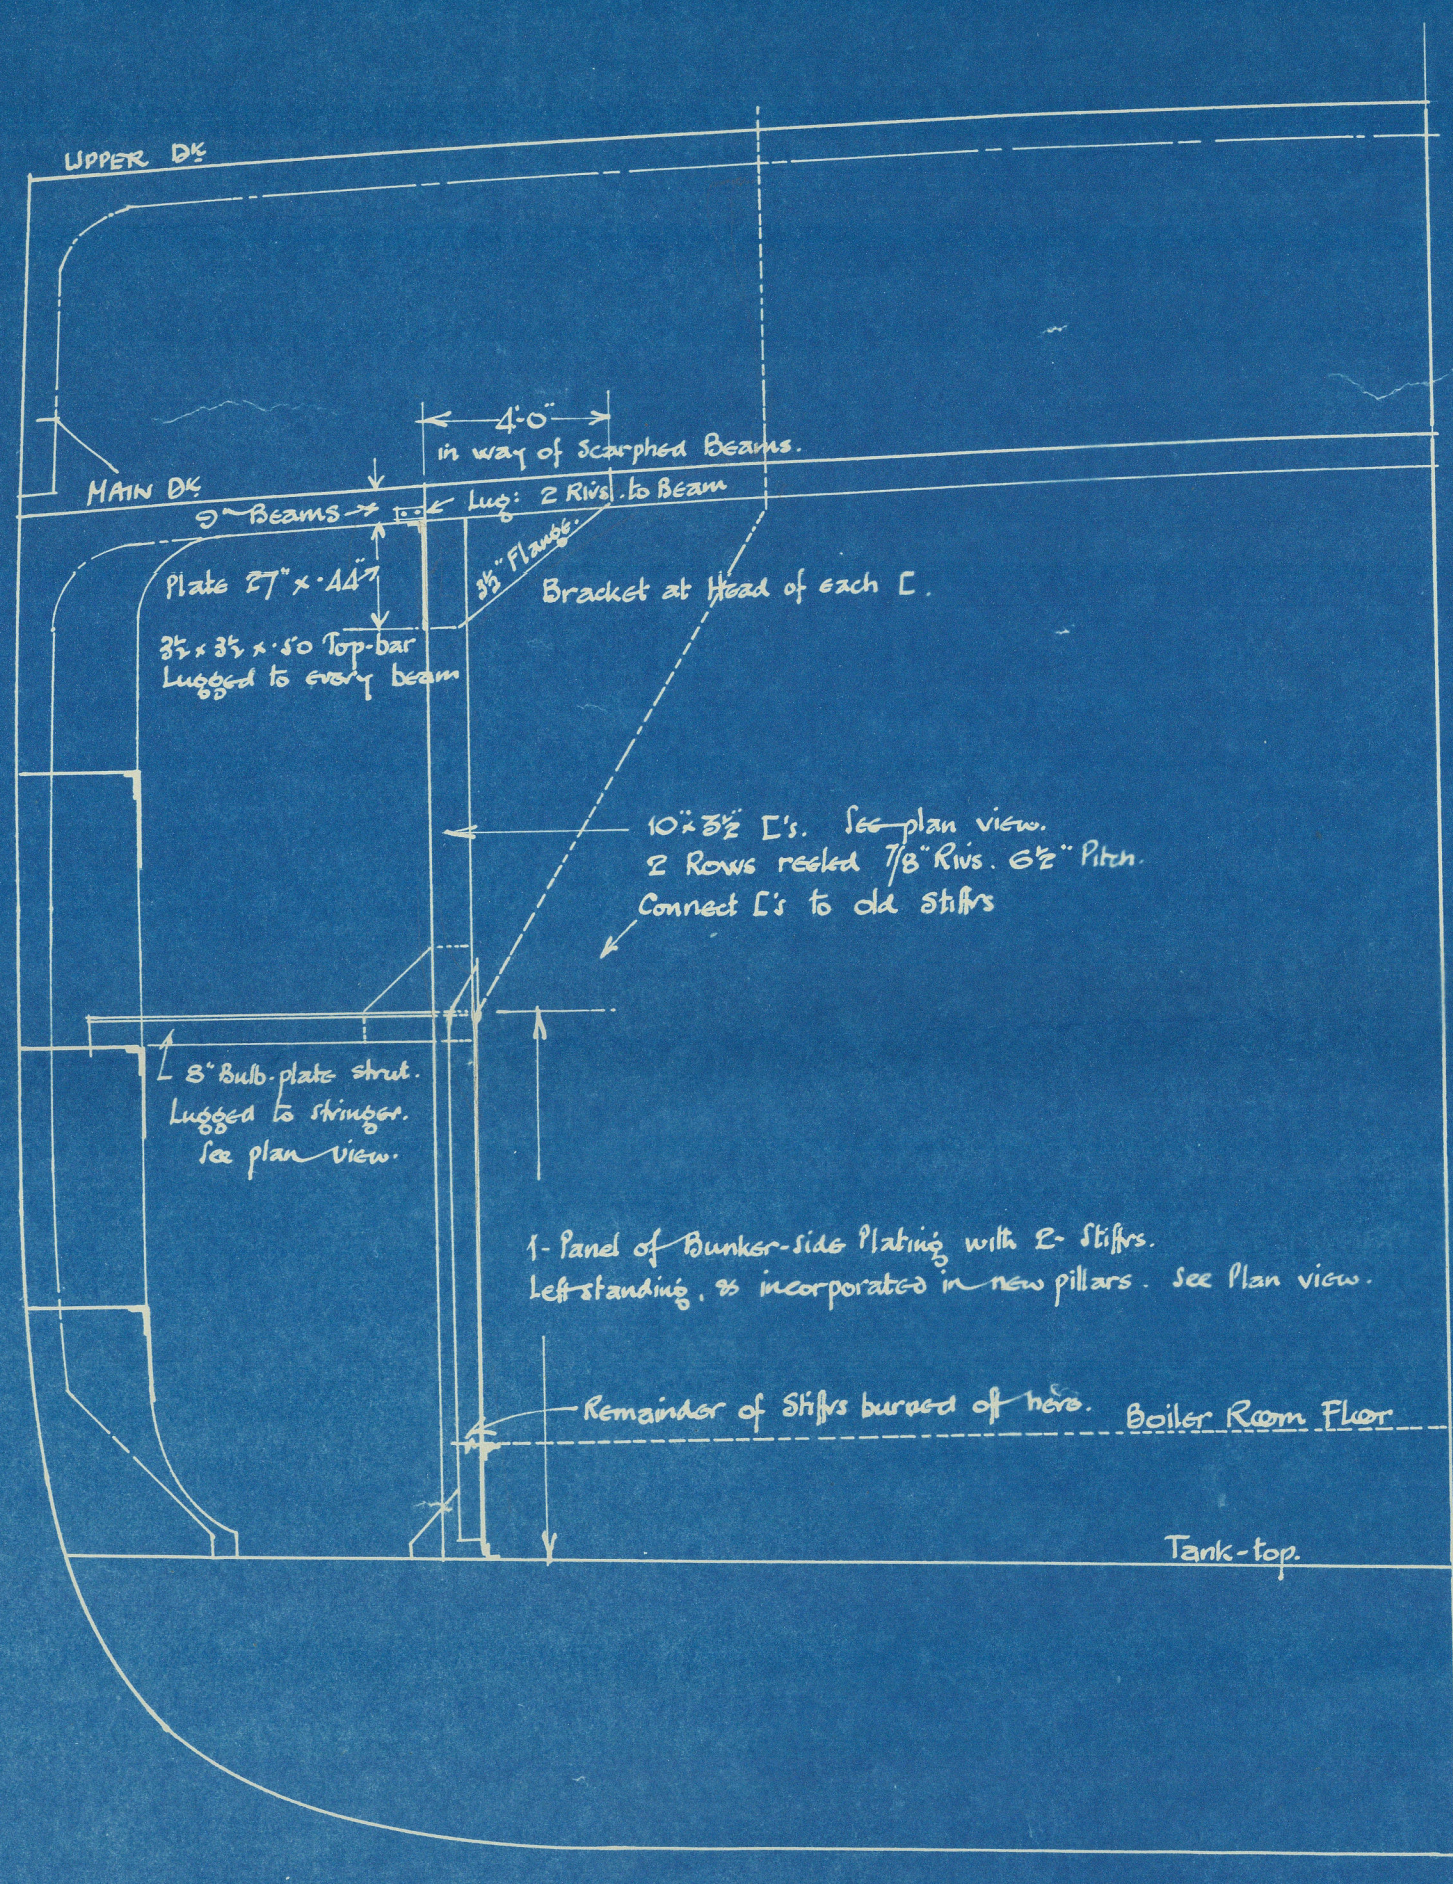

General View - Looking Forward.

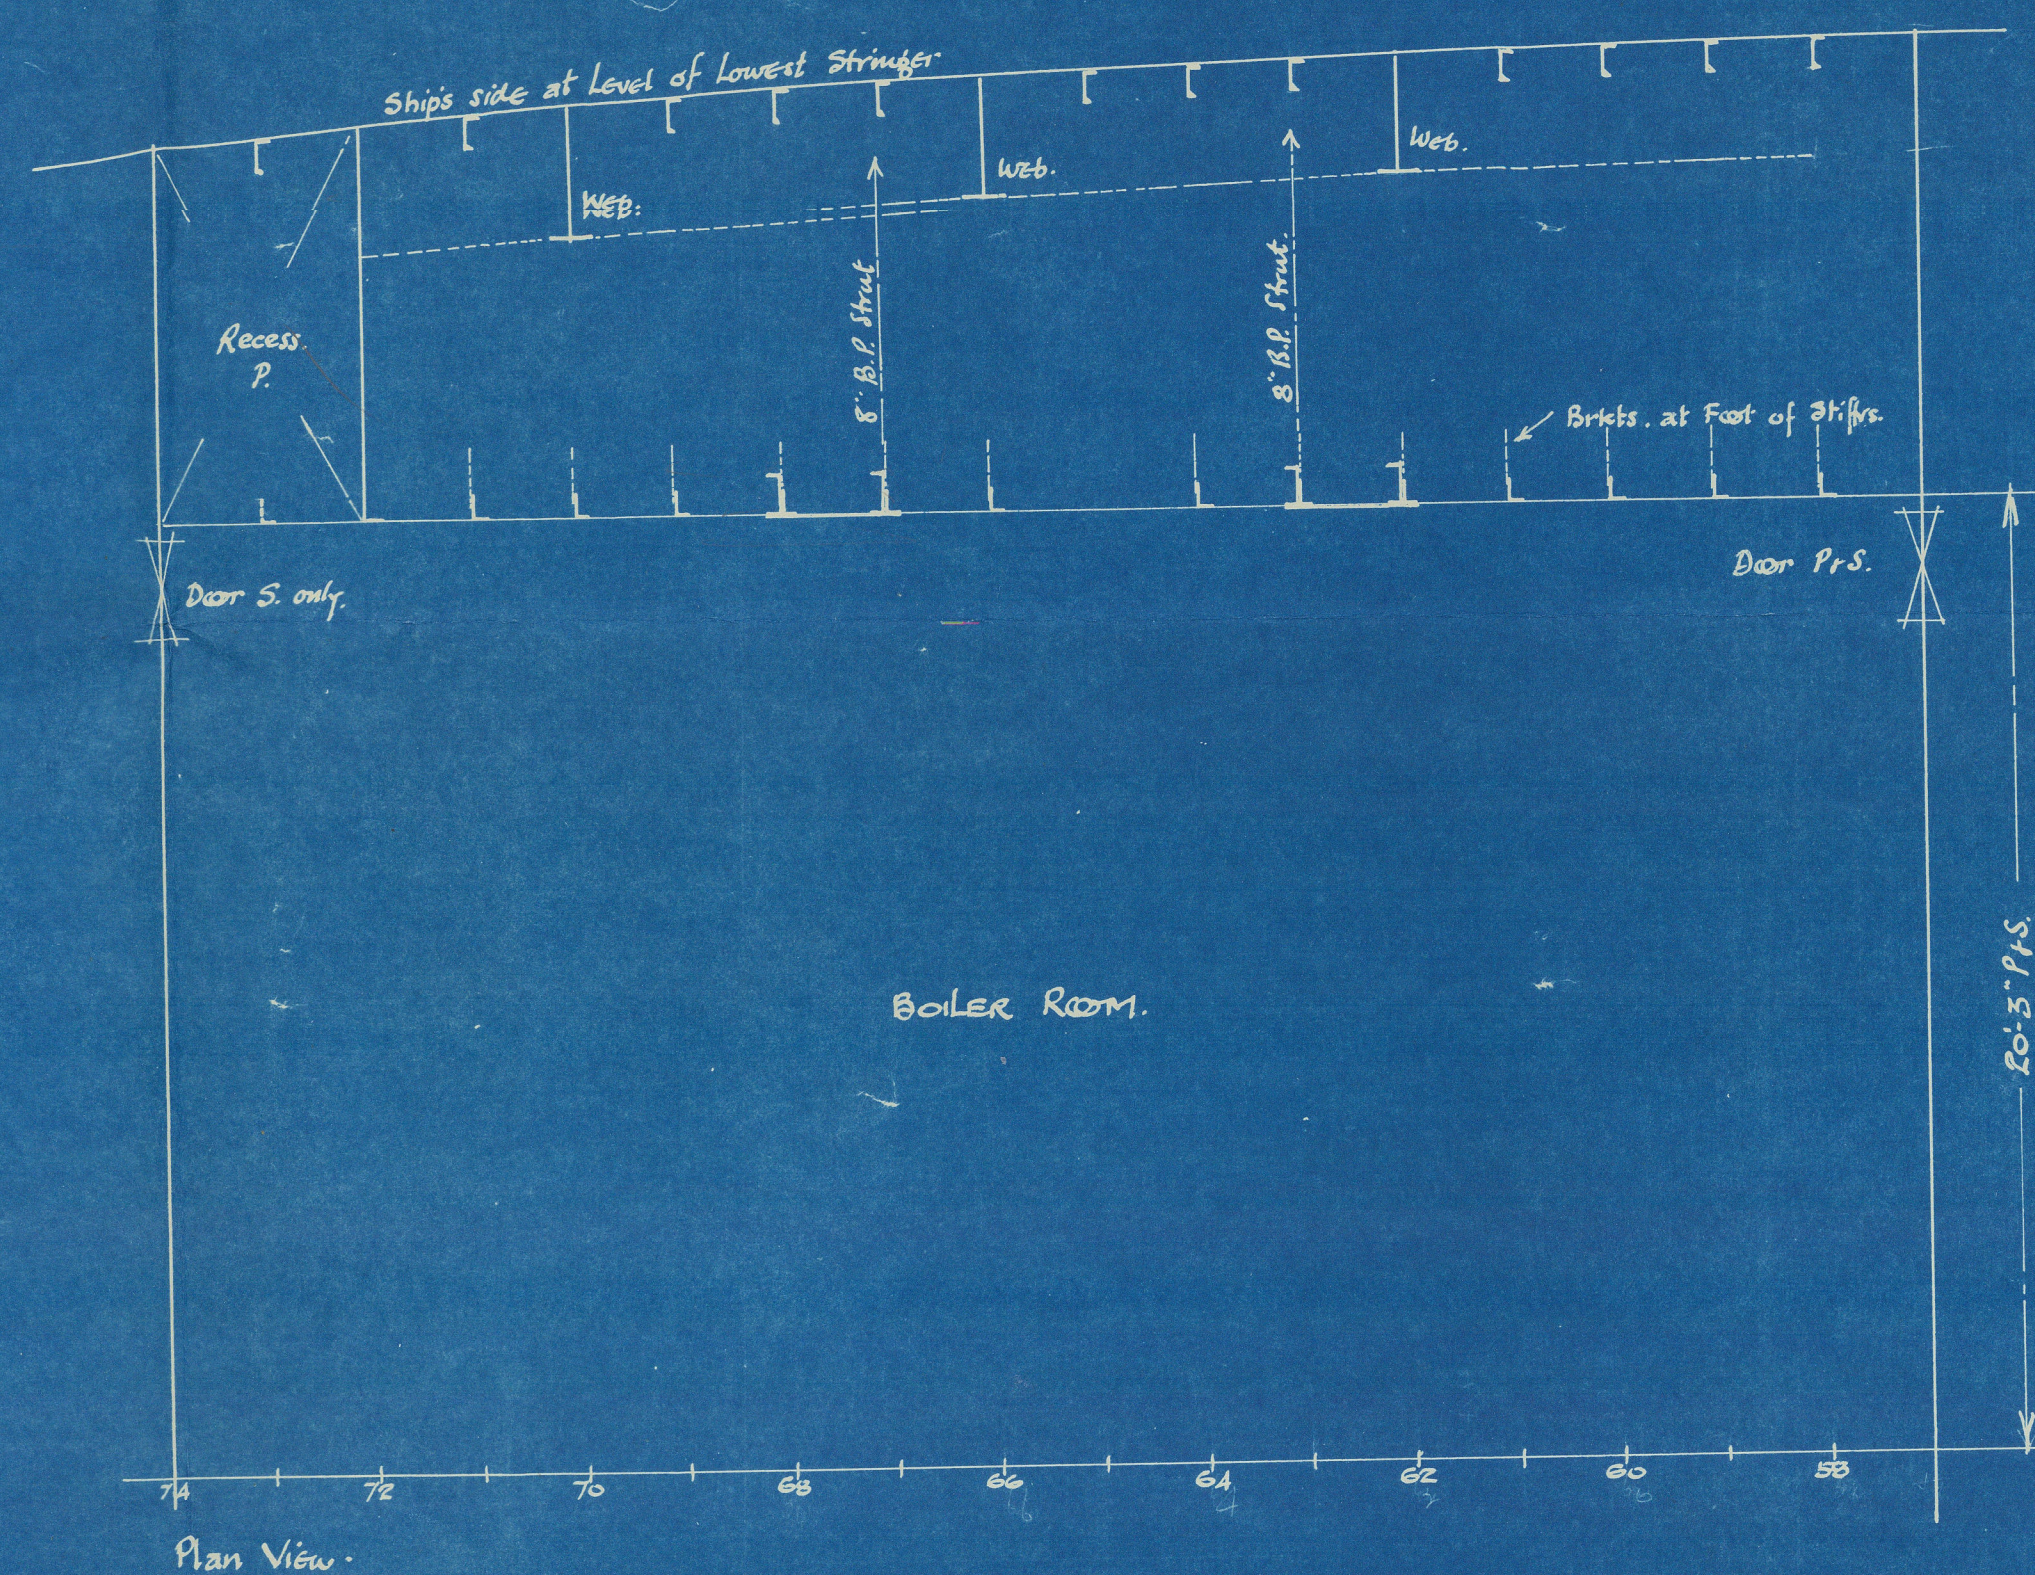

Plan View.

1ROQUOIS

Rel. rept. No. 11404.

Pillars Gunders in Boiler Room in lieu
of Side Bunker Bulkheads.

W309 - 0072



© 2021

Lloyd's Register
Foundation