

For the information of Surveyors and the Committee only.

Received at

Office

Lloyd's Register of Shipping.

(Report on Vessel No.

Port

Fleetwood

No. *F8022*

SHIP FORGINGS OR CASTINGS.

I have to report that the undermentioned ~~Iron or~~ Steel Forgings or Castings, manufactured by *Messrs J. S. Forester & Son Ltd.* of *Sunderland*, for the Vessel No. *S.S. MELOA*, being *REPAIR* by *Messrs J. Robertson & Son Ltd.* of *Fleetwood* have been inspected by me as set forth below and found to be, so far as can be seen, *Sound*.

Forgings or Castings.

Lloyd's

No. *1372*

15.5.39


J. E. Gallford

Sunderland

15.5.39

	STERN FRAME.	RUDDER FRAME. <i>REPAIRS</i>	STEM.
1* ...	<i>New head to frame. Scrap steel.</i>	<i>Forged & smithed.</i>	
ade ...			
iled ...			
ons ...		<i>4 1/4" D.I.A.</i>	
on Inspection ...		<i>Forging & smithing.</i>	
en Inspected ...		<i>11.5.39 to 13.5.39.</i>	
ASTINGS.			
n Standard Test Pieces.			
Test—			
er square inch ...			
on per cent. ...			
ding Test—			
efore fracture ...			
t—			
from ground ...			
ing Test—			
e according to Rules			
ound satisfactory ...			

SKETCHES OF FRAMES SHOWING POSITION AND DESCRIPTION OF WELDS OF FORGINGS.

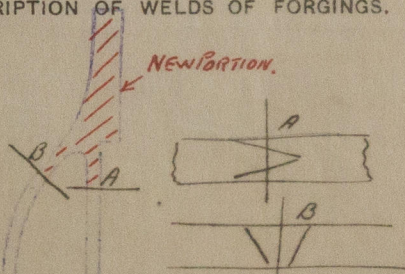

(if any chargeable) £ *1 : 0 : 0*

To be paid at

SUNDERLAND.

Iron, state whether scrap or puddled Iron. If of Steel, state whether made on the Open Hearth process.

W309 - 0086

© 2019

Applied for

REPAIR

15 MAY 1939

F683

Lloyd's Register Foundation