


PROFILE
S.T. NOS. 265-6
DIM^s 126'-8" B.P. x 23'-0" EXT. x 13'-0" MLD.
To CLASS 100A1 AT LLOYDS FOR FISHING PURPOSES
SCALE 1/4" = 1 FOOT

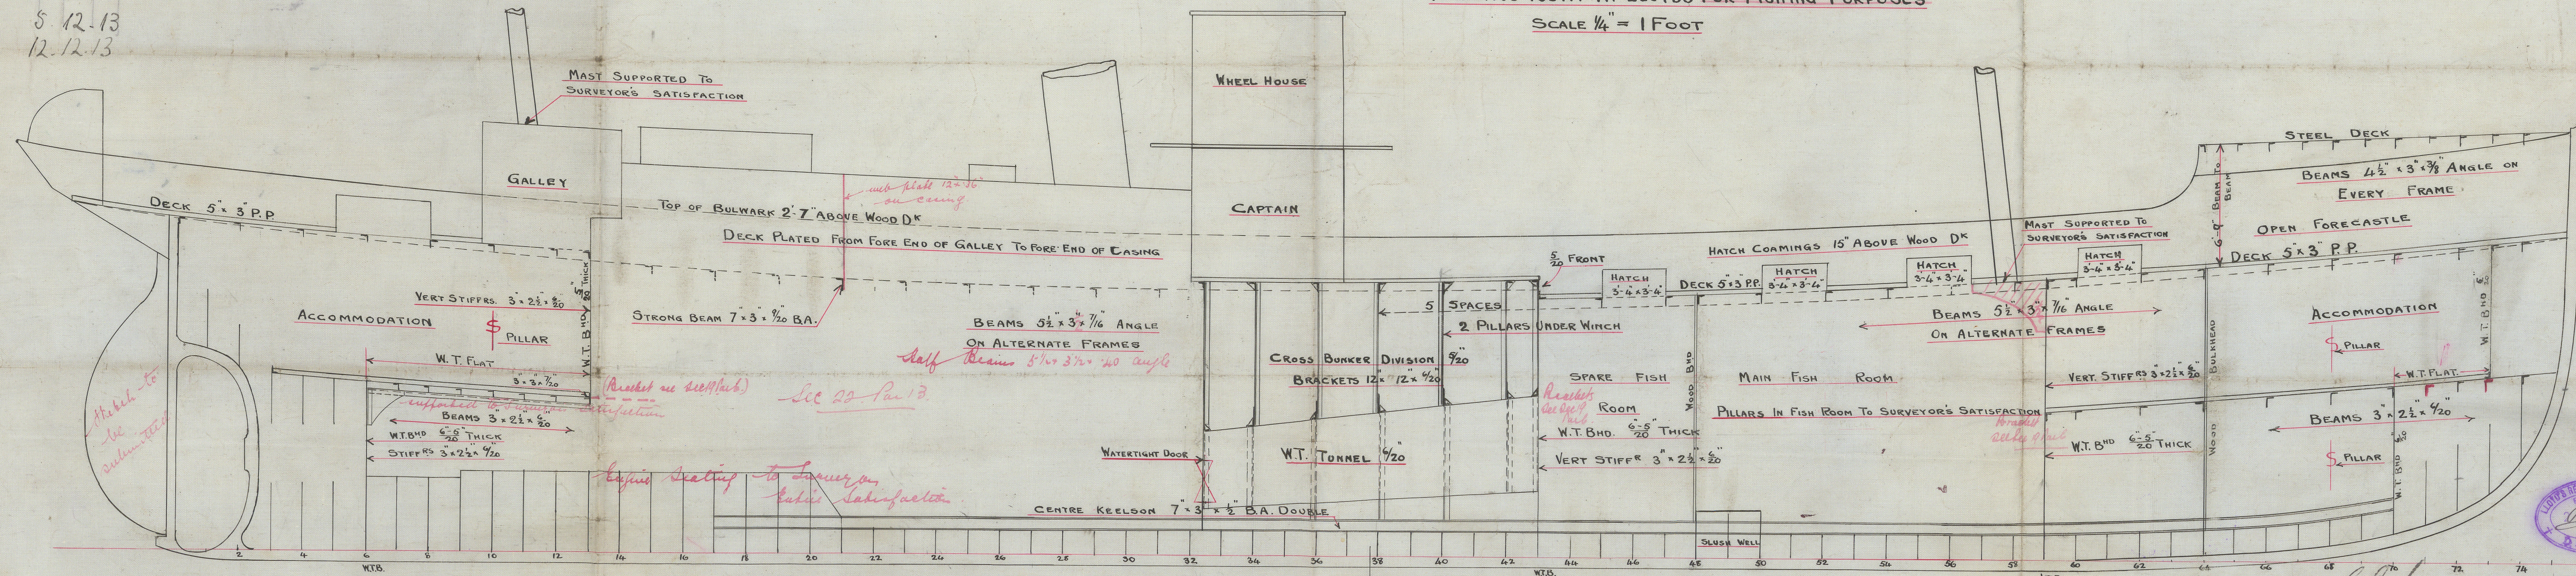

f. 12. 13.

PROFILE PLAN
DUNDEE S. B. CO. LTD


N^{os} 265 & 266

S.S. "IMELDA"

S.S. "LUCIDA"

DUN. RPT. N^o 7847

DUN. RPT. N^o 7848

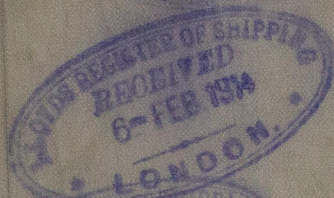

© 2021

Lloyd's Register
Foundation