

MIDSHIP SECTION OF TWIN SCREW STEAMER.
- M^{LD} DIMENSIONS 477'-0" x 60'-9" x 34'-0" ^{26' 1" OS} TO MAIN DECK


TO CLASS 100A.1. AWNING DECK

SCALE $\frac{1}{2}'' = 1 \text{ FOOT}$

— SCANTLINGS OF FORCE

8/20
SIDE PLATING
STRINGER 44 x 820 PLATING 9/16" WOOD DECK 5-3P.
BEAM 10-32 x 31 1/2" CHANNEL ON ALUM. FRAMES
BEAM KNUCK 304 x 1/2" 7.75 TITENED. *equivalent to 2 rows of fillers.*

SECTION IN WAY OF 8'6" LOWER.
TWEEN DECKS.

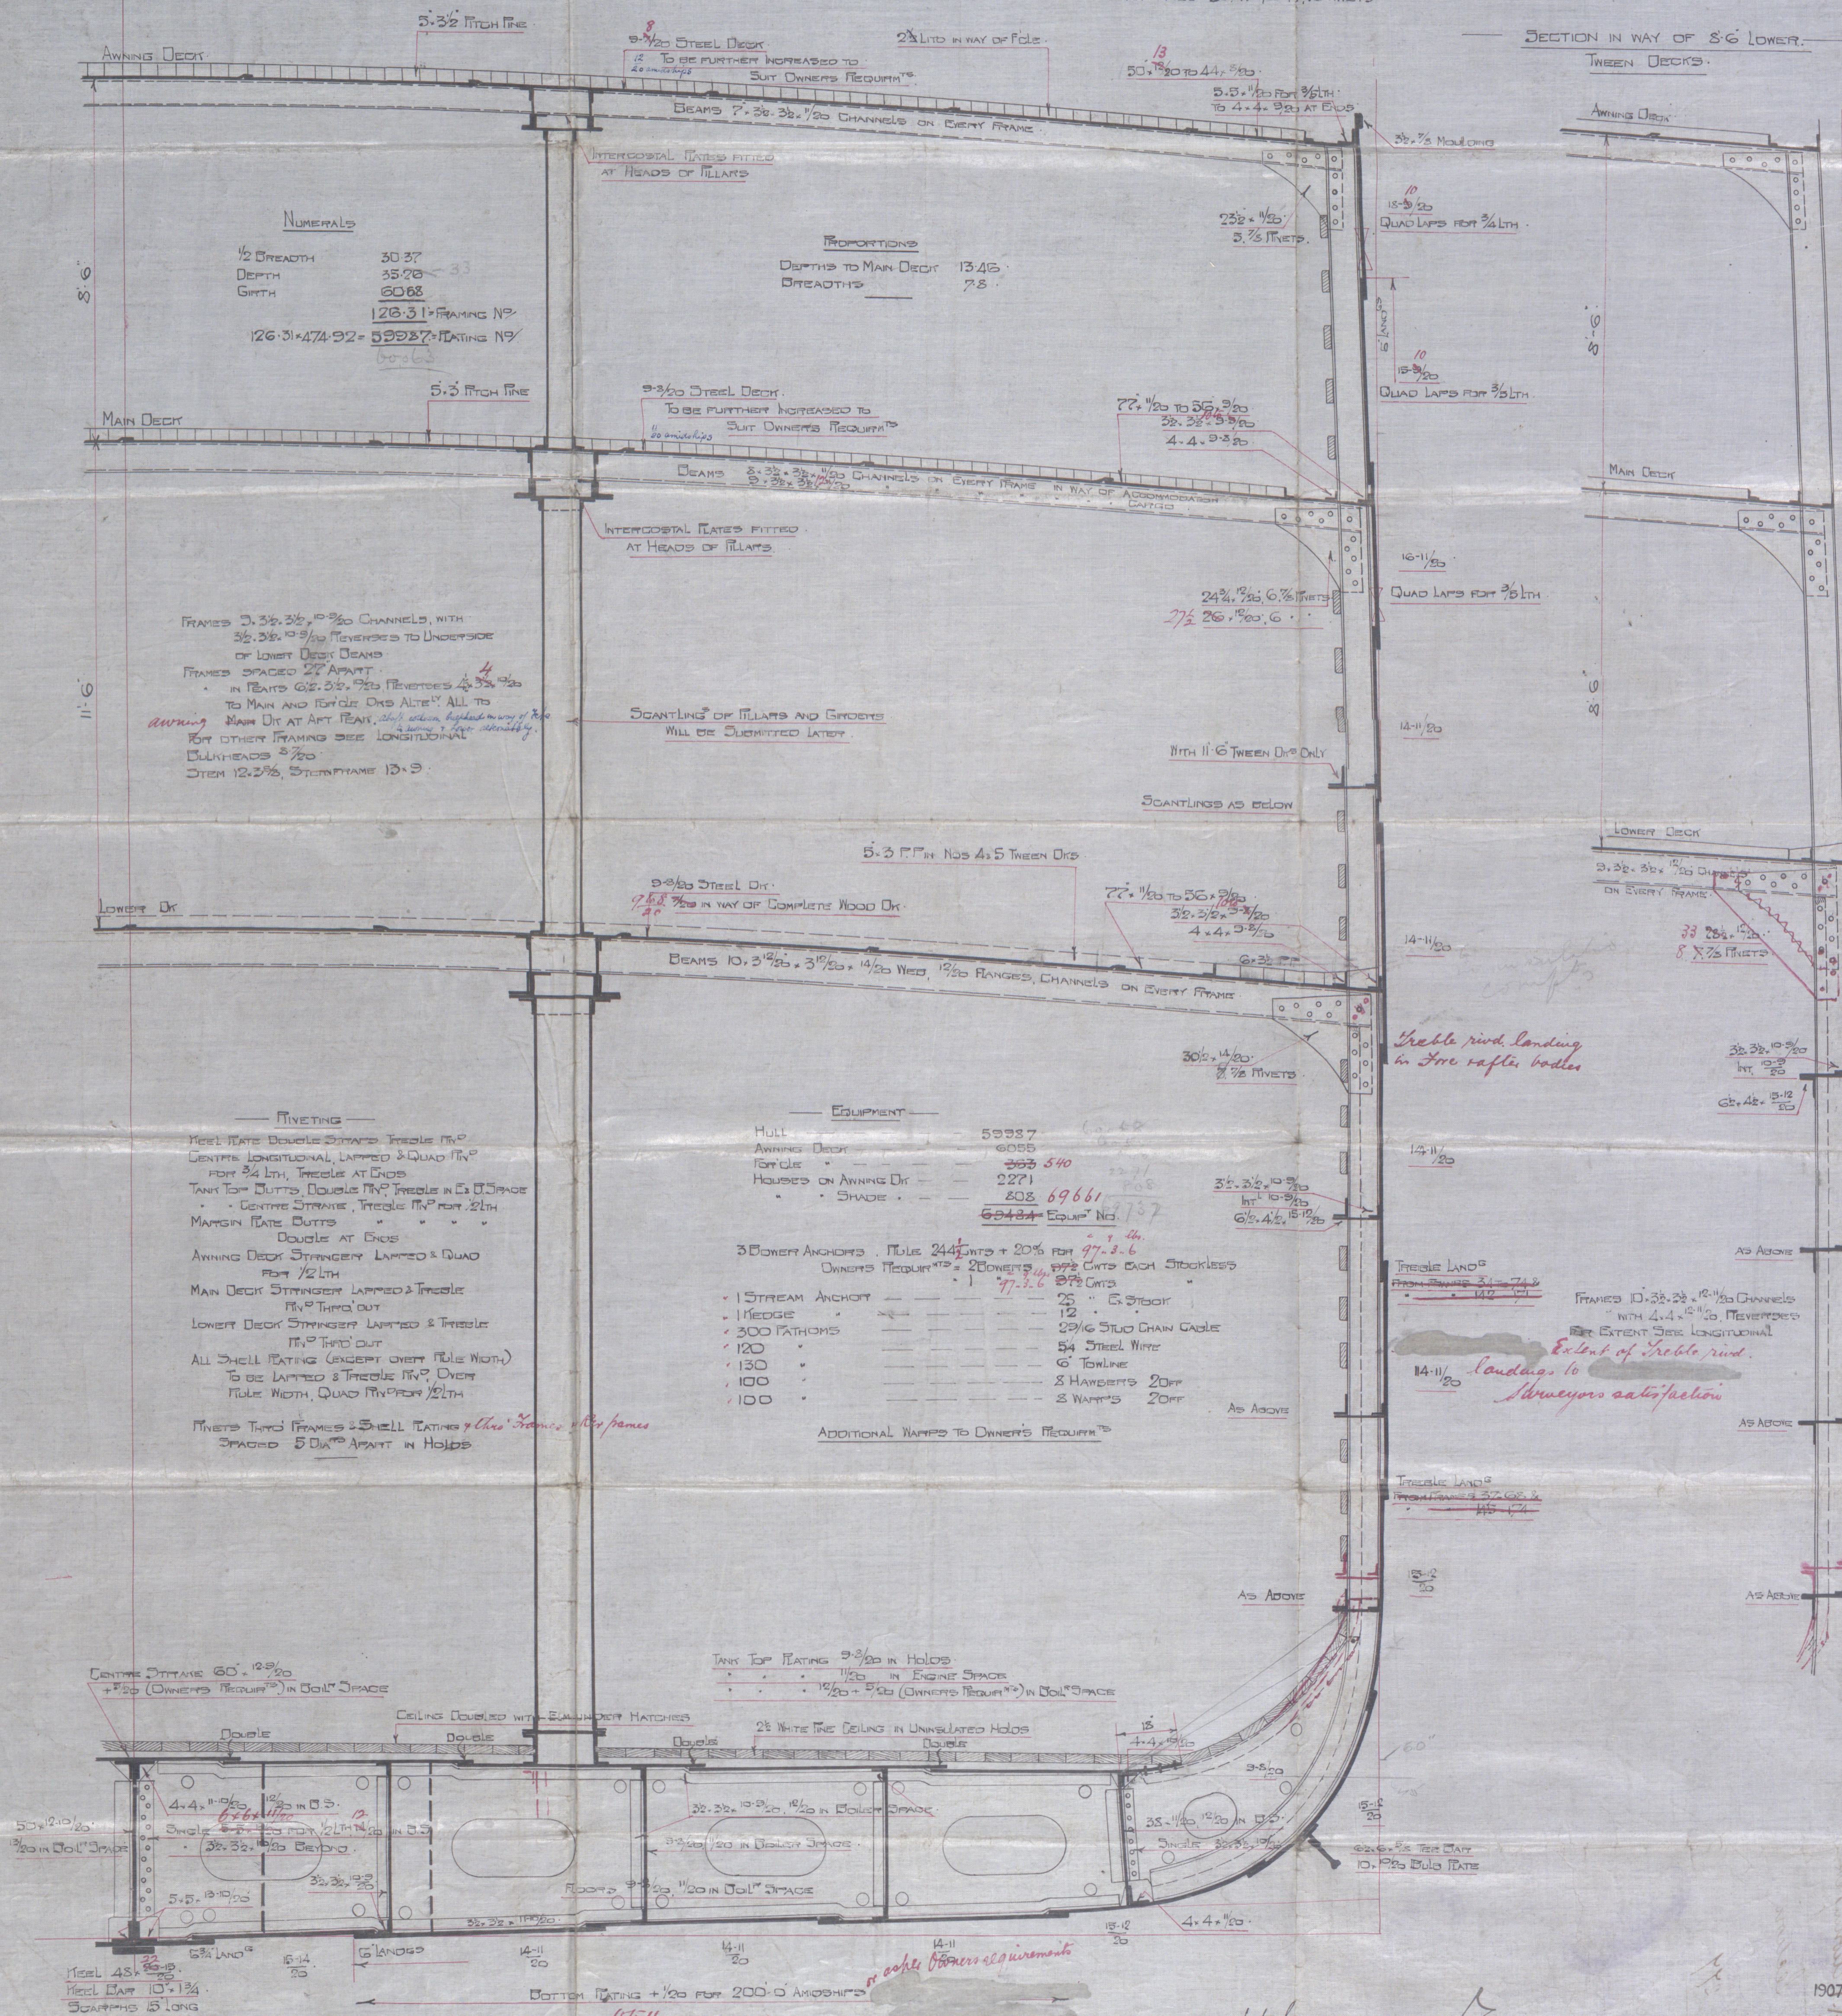

1907

Mess^r Workman Clark W^d L^d

T.S.S. 477' x 60'9" x 34'0" Med &
Main Dr.

To Class 100 A.1. Awaiting Dr.

Friendship Section

Yard No. 274

"Empire"
"Gairnii"
Rel 6524



© 2020

Lloyd's Register
Foundation

W31-0141