


EXTRA COMPENSATION ORDERED BY LLOYDS SURVEYOR COMPLETED

NEW PLATE. RUSSELLS. SPACED 6'-0" UP FROM HERE.

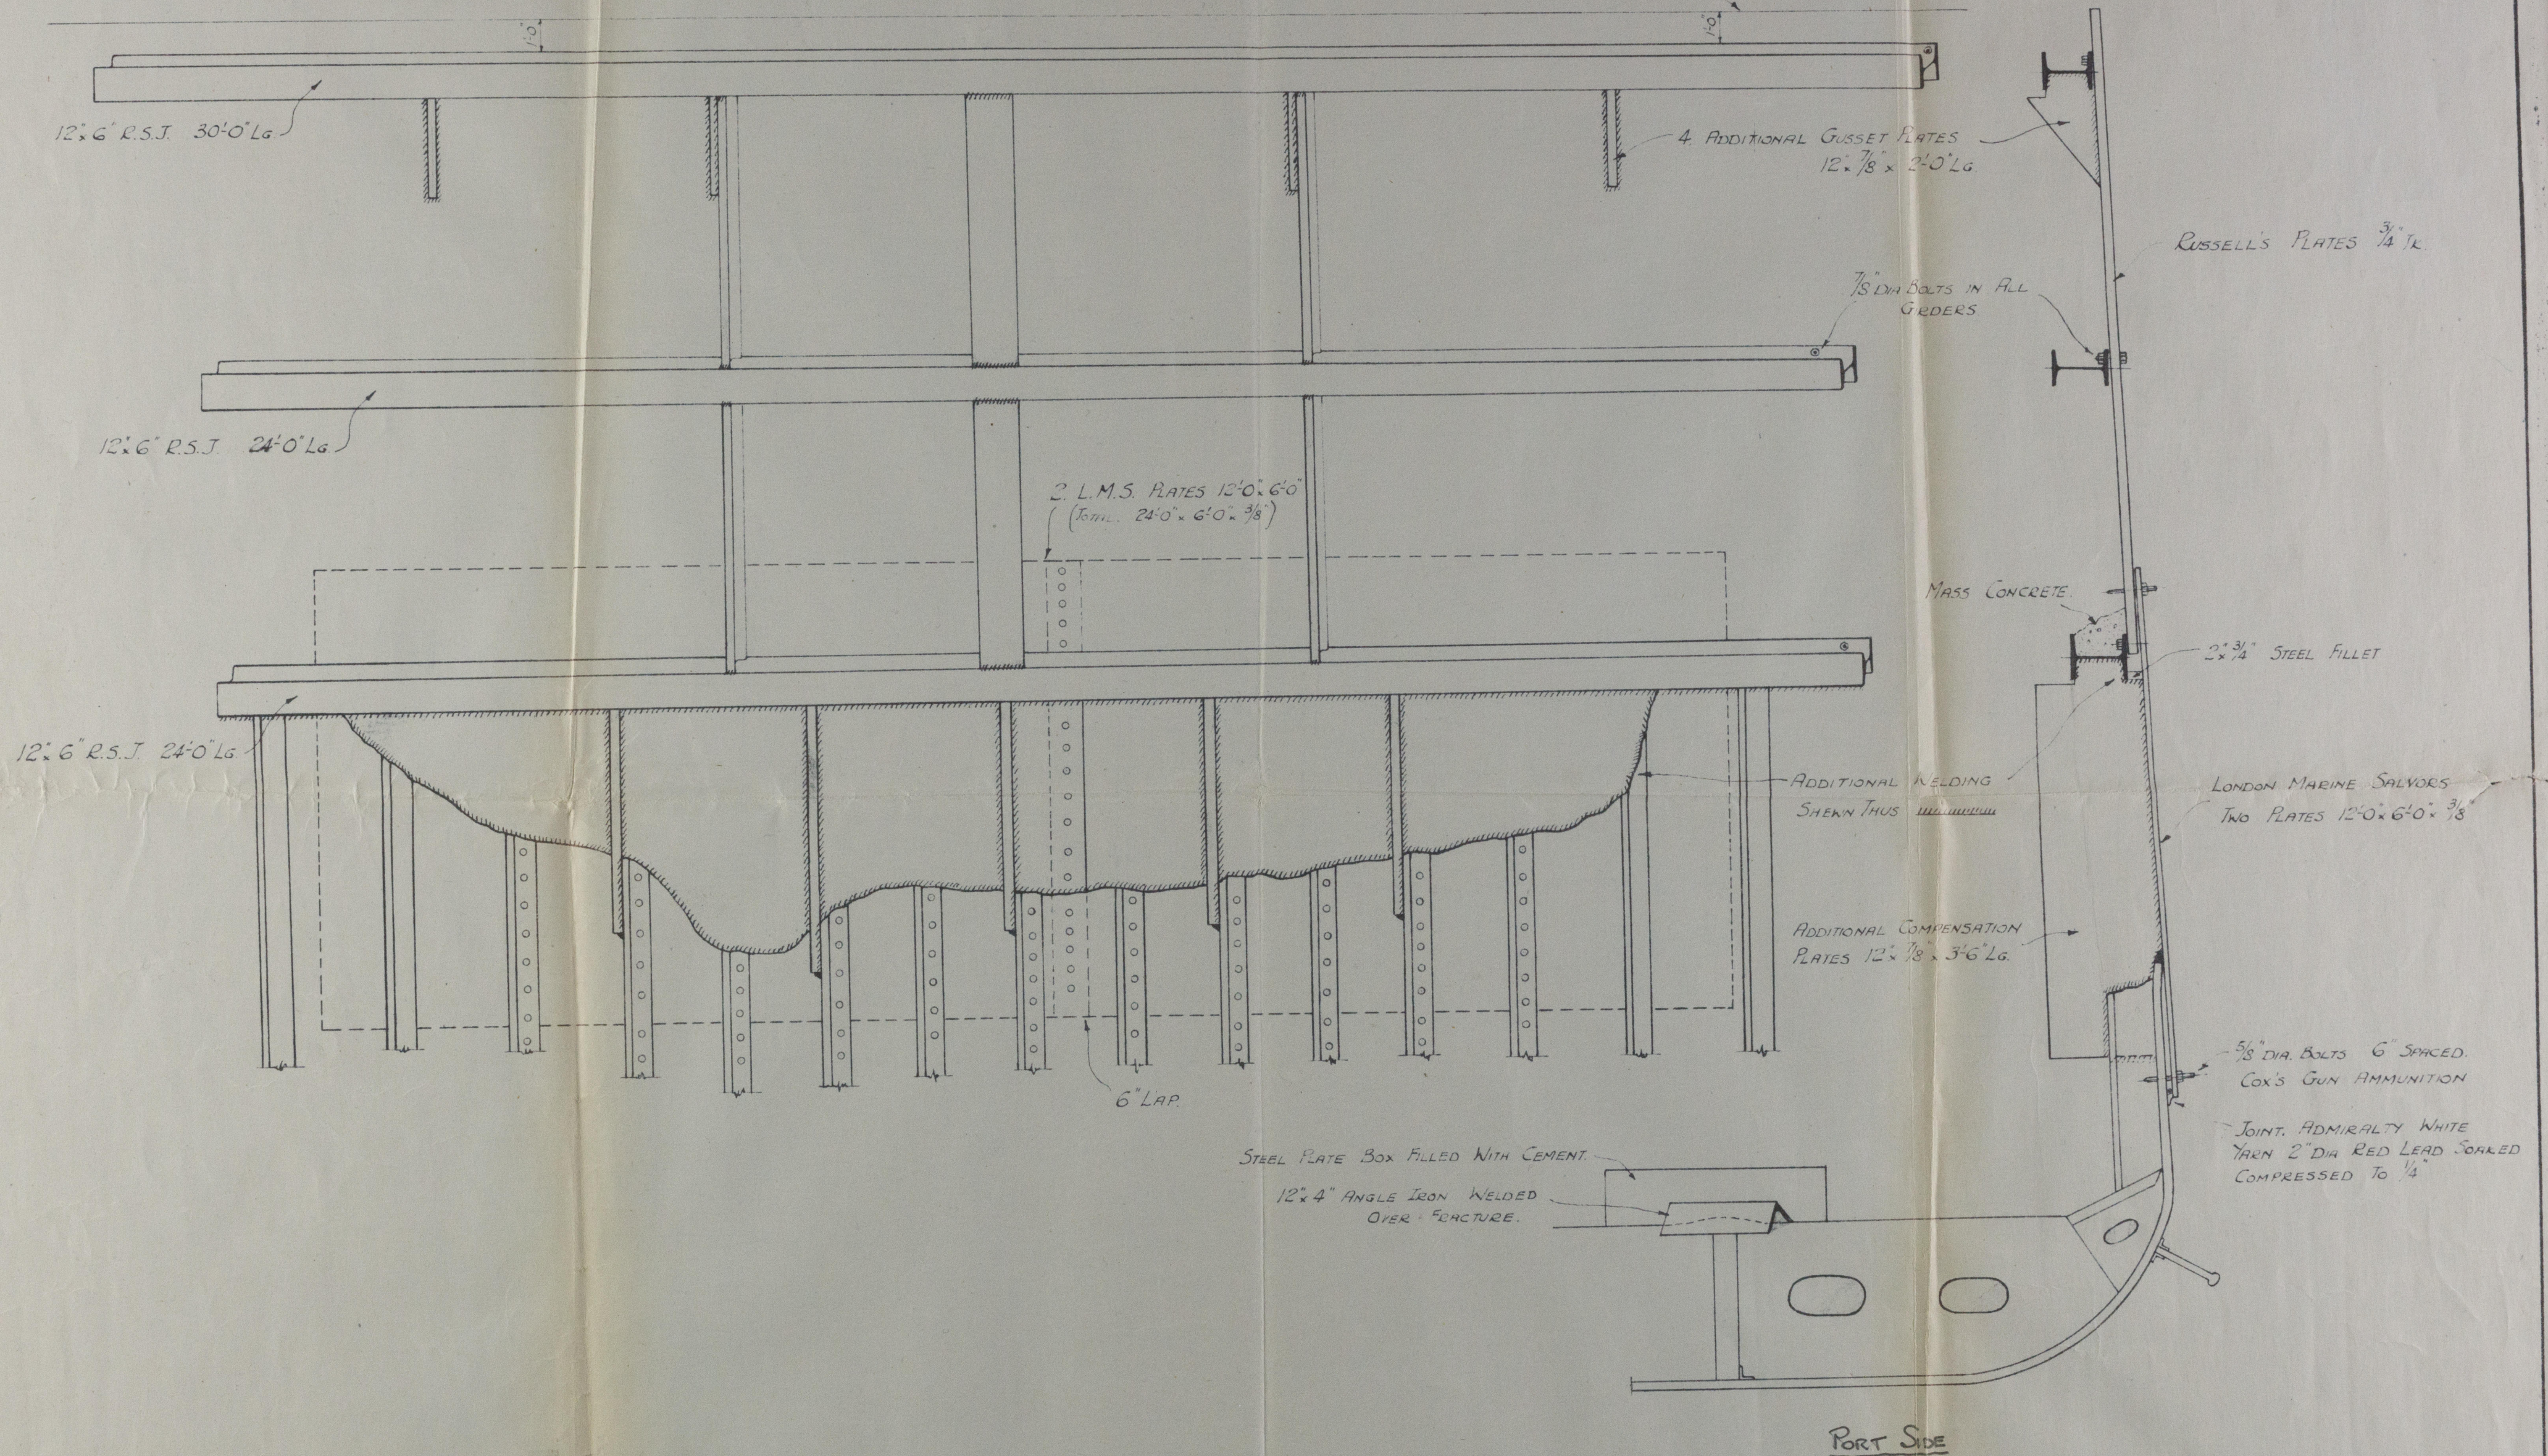

OUTLINE SKETCH OF TEMP<sup>y</sup> RPRS ON PORT SIDE  
ABREAST N<sup>o</sup>3 HATCHWAY  
NOT TO SCALE

S.S. MOSCHA. D. KYDONIEFS.


MANOR (LONDON) LIMITED  
ENGINEERS & SHIPREPAIRERS  
7, ST. HELEN'S PLACE.  
BISHOPSGATE, E.C.3.

© 2019  
Lloyd's Register  
Foundation



"Varvassi."

Invc rept No. 103934.

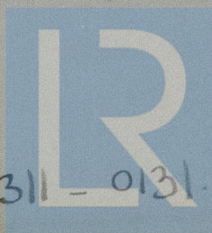

© 2019

Lloyd's Register  
Foundation

W 311 - 0131.1