


PROFILE & DECK PLANS N°223.

SCALE $\frac{1}{8}'' = 1$ FOOT.

DIMENSIONS. 375'-0" B.P. x 51'-8" M.L.P. x 26'-12" M.L.P.

PLANS OF PILLARS & GIRDERS, HATCHWAYS, HATCH END BEAMS & PILLARS TO BE SUBMITTED.

14.3.14
20.3.14
28.3.14

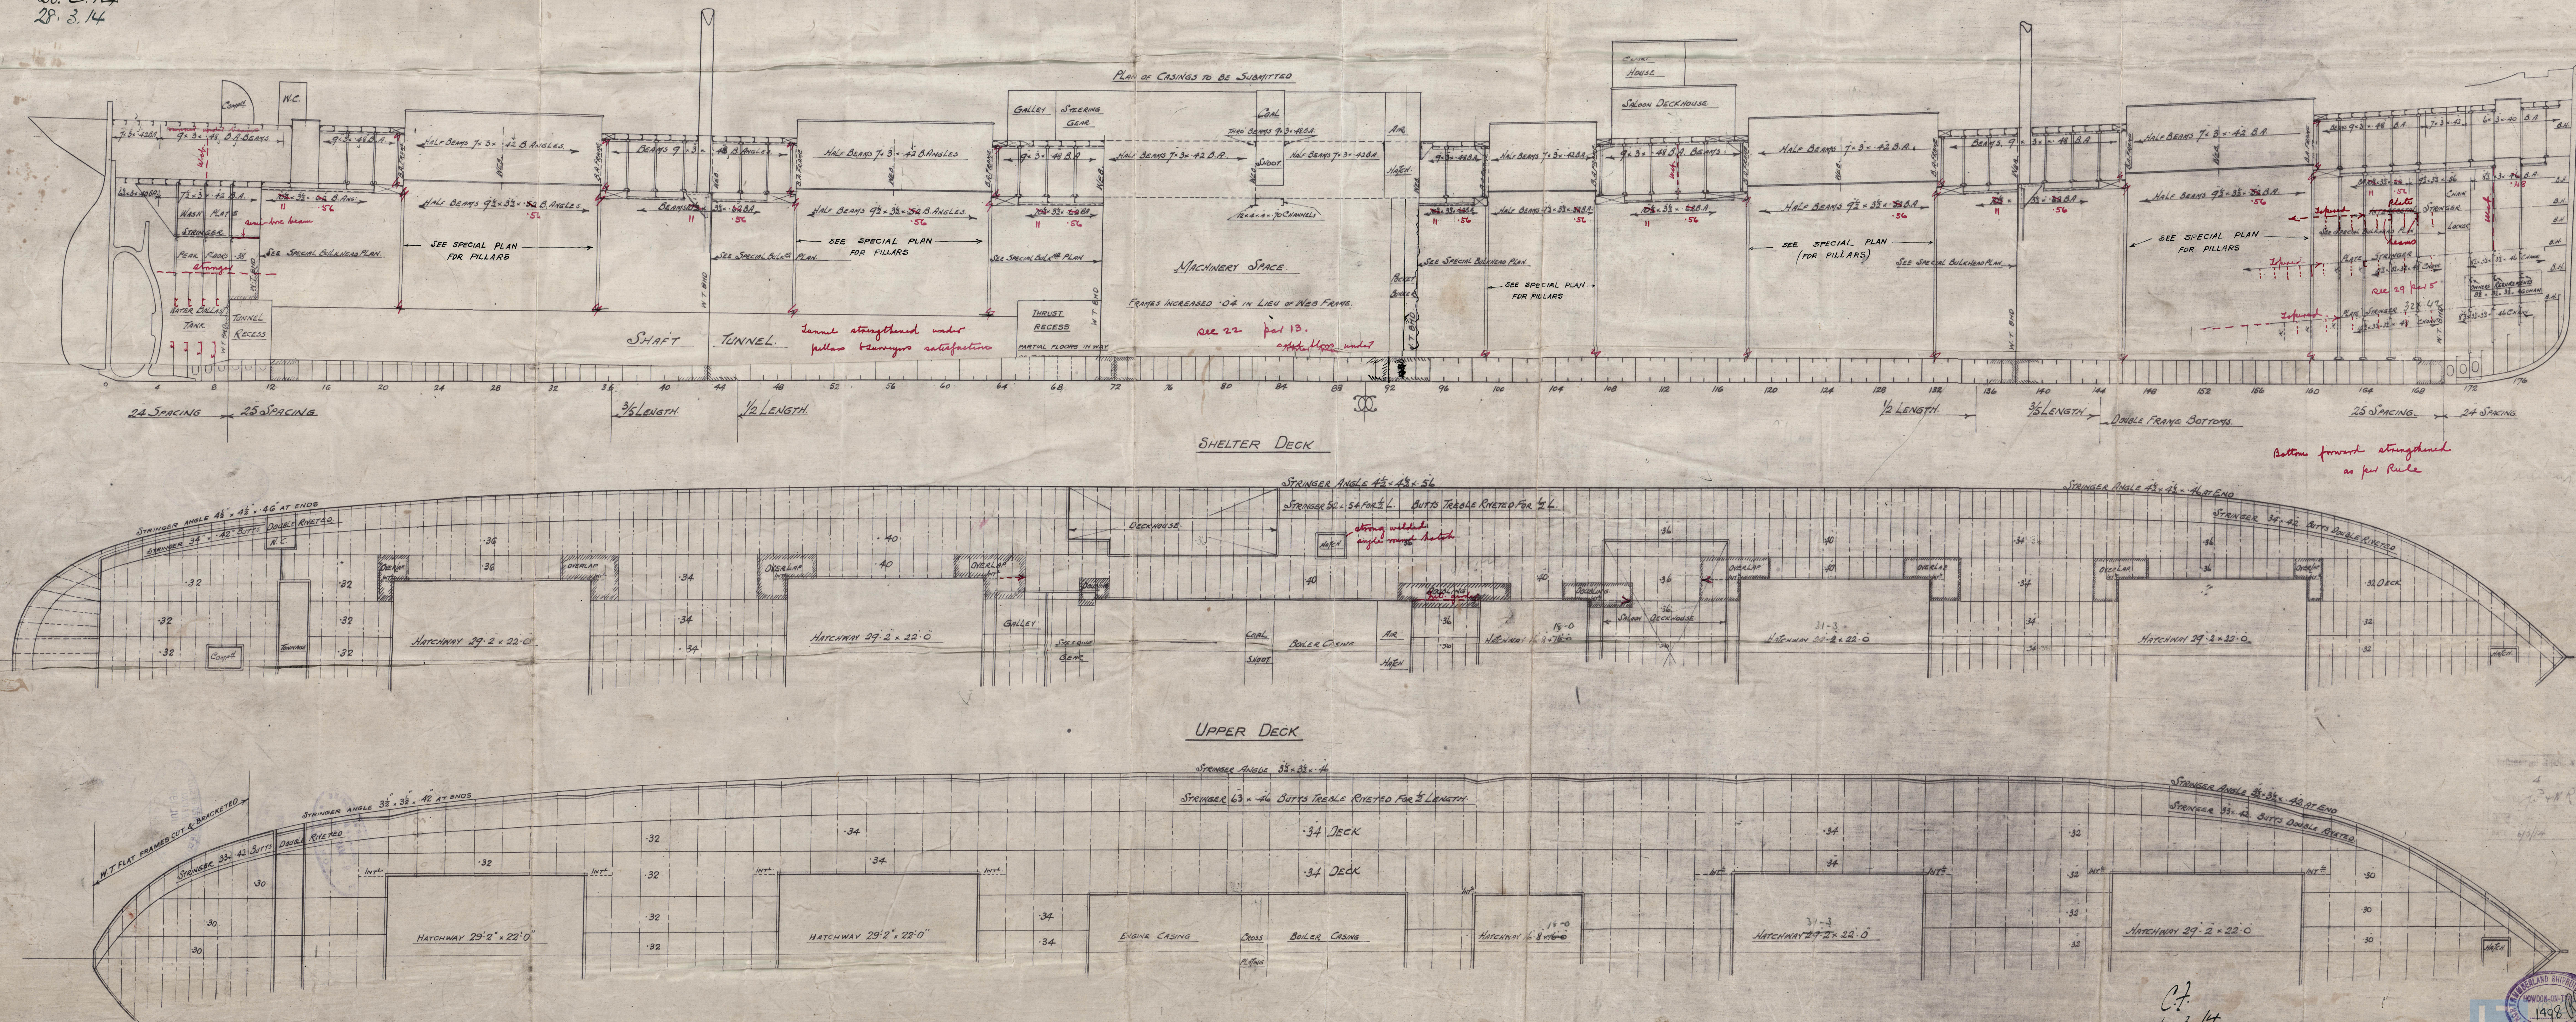

C.F.
14.3.14

Northumberland S.B. Co.

Profile & Decks.

No 223




"Vovassi" Rpt No 6084
Ex

S.S. "BRONZE WINGS".

Report No 67318.



(Moscha & Kydonia)

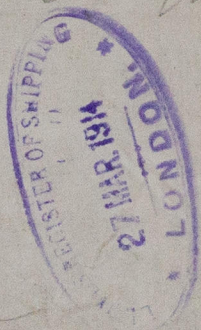

W311-0146



© 2019

Lloyd's Register
Foundation