



24.8.03

— PROFILE & PLAN. —  
— N<sup>o</sup> 228 SHIP —  
— DIMENSIONS 102' x 23' x 13' MLD. —  
SCALE  $\frac{1}{4}$ " = 1 FT.

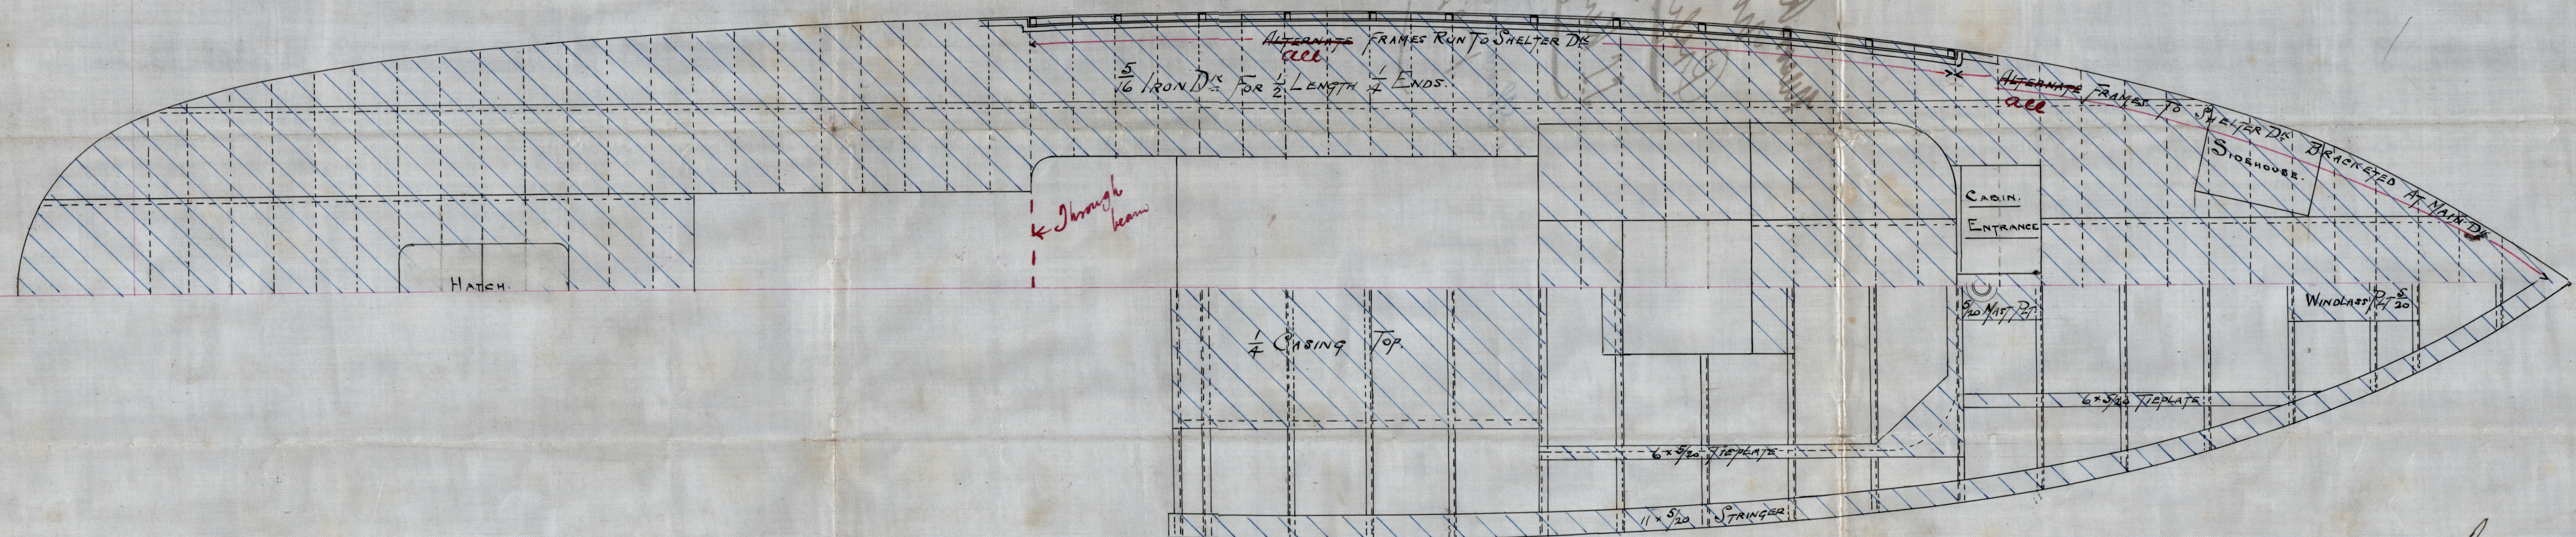

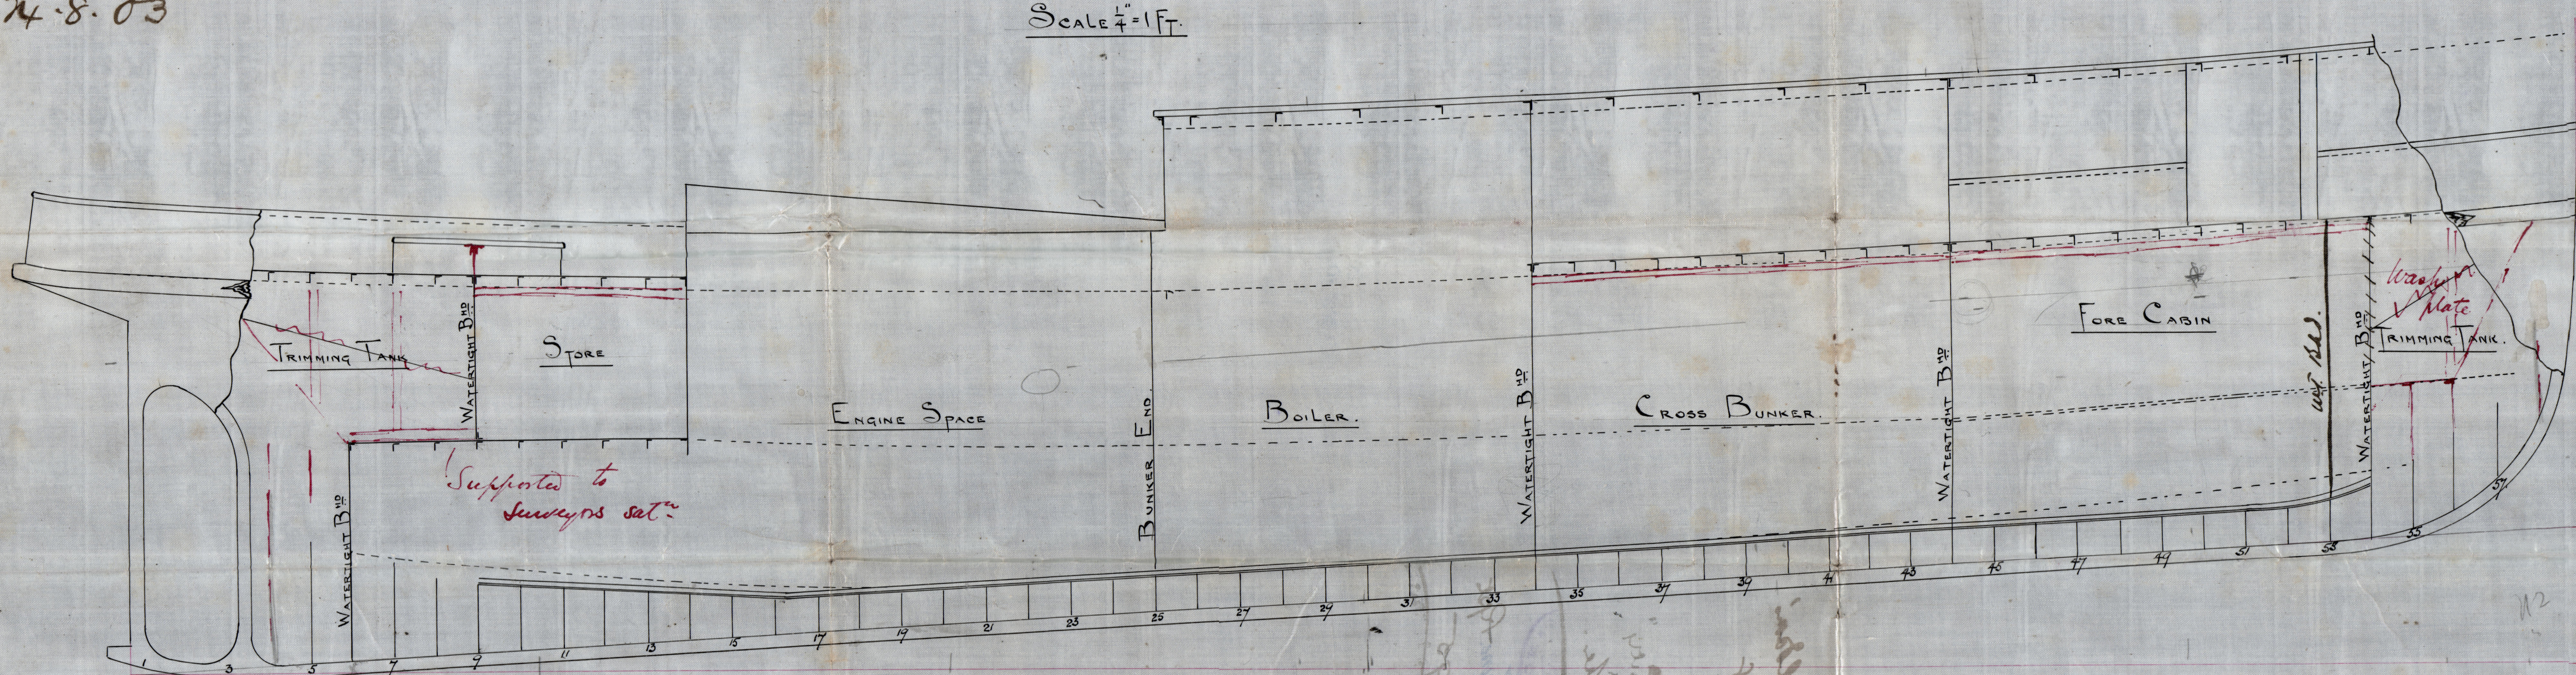

Nelson R. Arnoldson  
No 228

Profile

Security

L.I. Kingfisher

Newcastle-on-Tyne. Rpt

No. 46.795

Kingfisher



© 2019

Lloyd's Register  
Foundation

W311-0268