


CHARLES D. HOLMES & CO LTD  
ENGINEERS & BOILER MAKERS  
HULL

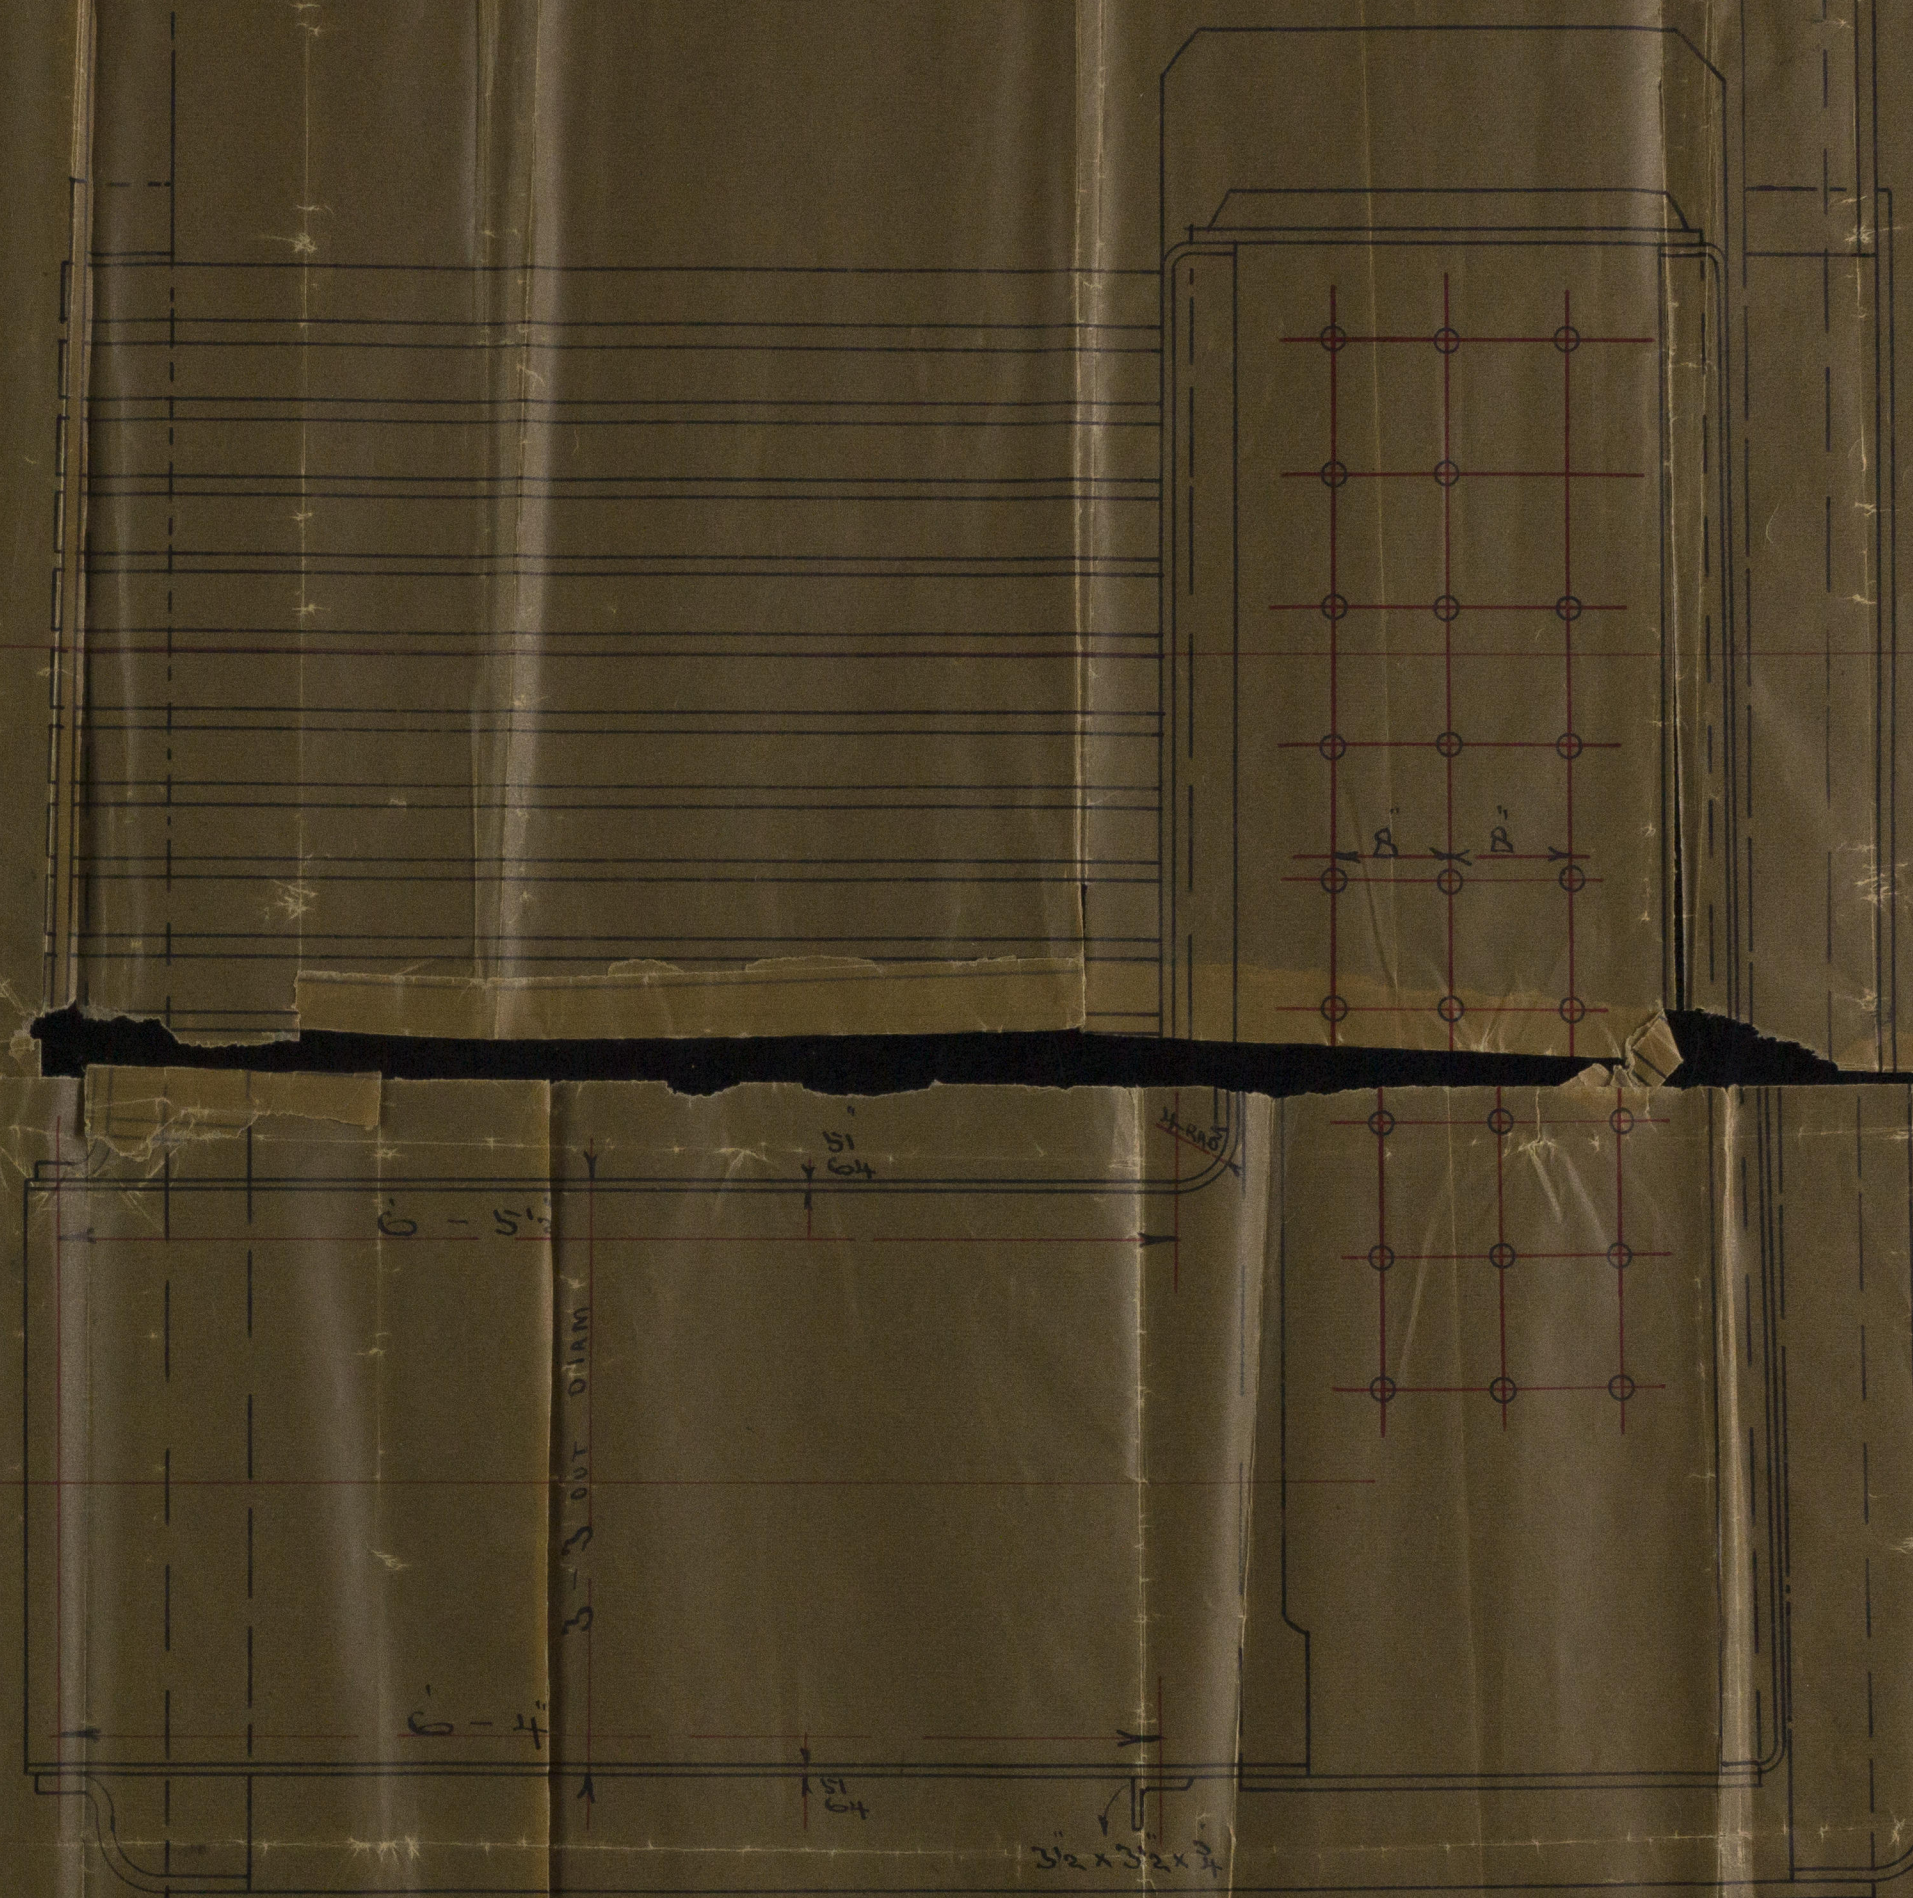

W311 0103127

# ALTERATION TO COMBN CHAMBER STAYS BOILER N°1107

H-T 50 53  
12/2/20  
C. D. Holmes

W312-0103127



© 2019  
Lloyd's Register  
Foundation