


COPY.

S/S "NORTHGATE"

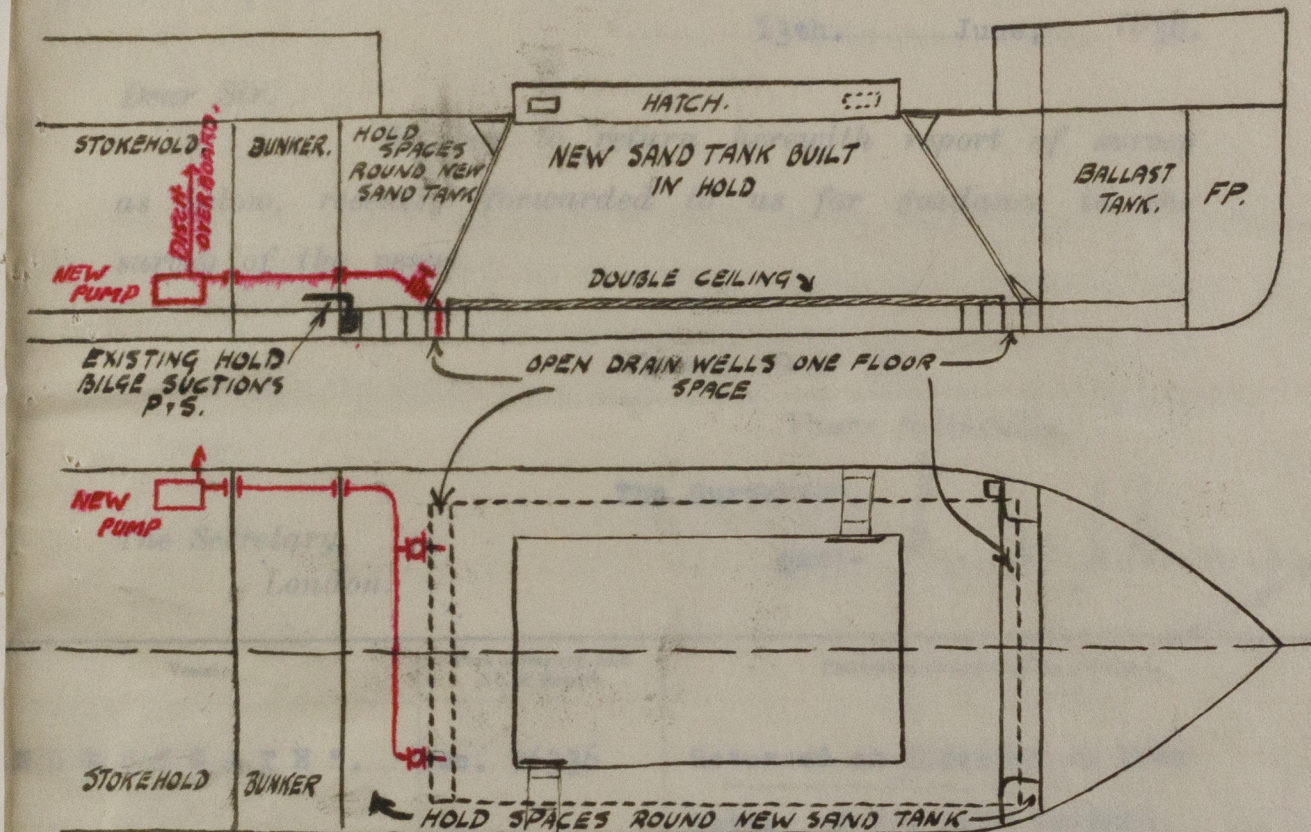

NEW 4" BILGE SUCTION LINE, DISCHARGE LINE AND NEW BILGE PUMP IN STOKEHOLD SHOWN IN RED.

Handwritten signature/initials



© 2019
 Lloyd's Register
 Foundation

W312-0123

W312-0123