


5/5 NORTHGATE

PROPOSED CONVERSION FOR CARRYING & PUMPING SAND IN BULK

1/2" PLATING

properties of material
in bulk pumping sand
bulk

W312-0138

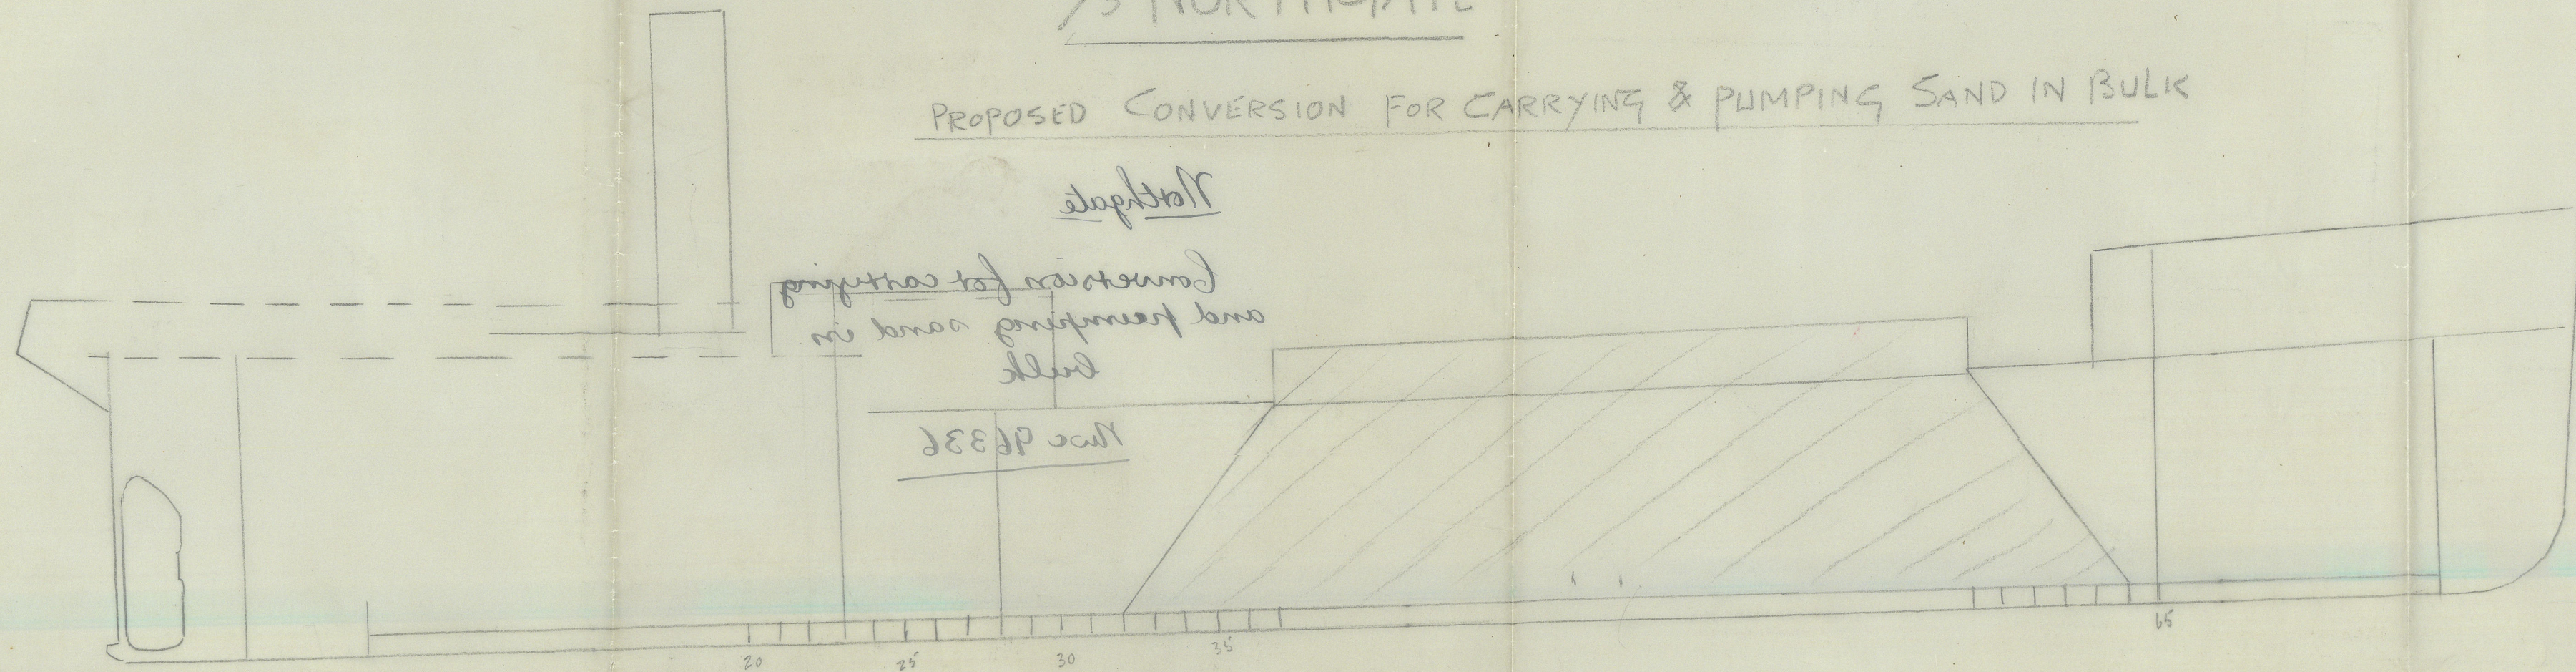

W312-0138

HOLE FOR DRAINAGE
WITH MEANS OF CLOSING WATERTIGHT
TO SURVEYORS SATISFACTION

6 x 3 x .44 C SPACED 22" APART

3/8" PLATING

3/8" PLATING

Cement

STIFFENERS ON END BULKHEADS
6 x 3 x .44 C SPACED 17" APART
BRACKETED TOP & BOTTOM 4 3/4" RIVETS

1. K. 38


1/2 NORTHGATE

PROPOSED CONVERSION FOR CA

Northgate

Conversion for carrying
and pumping sand in
bulk

Nwc 96336

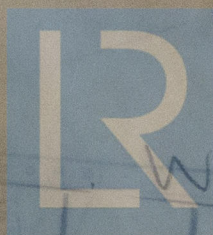

© 2019

Lloyd's Register
Foundation