
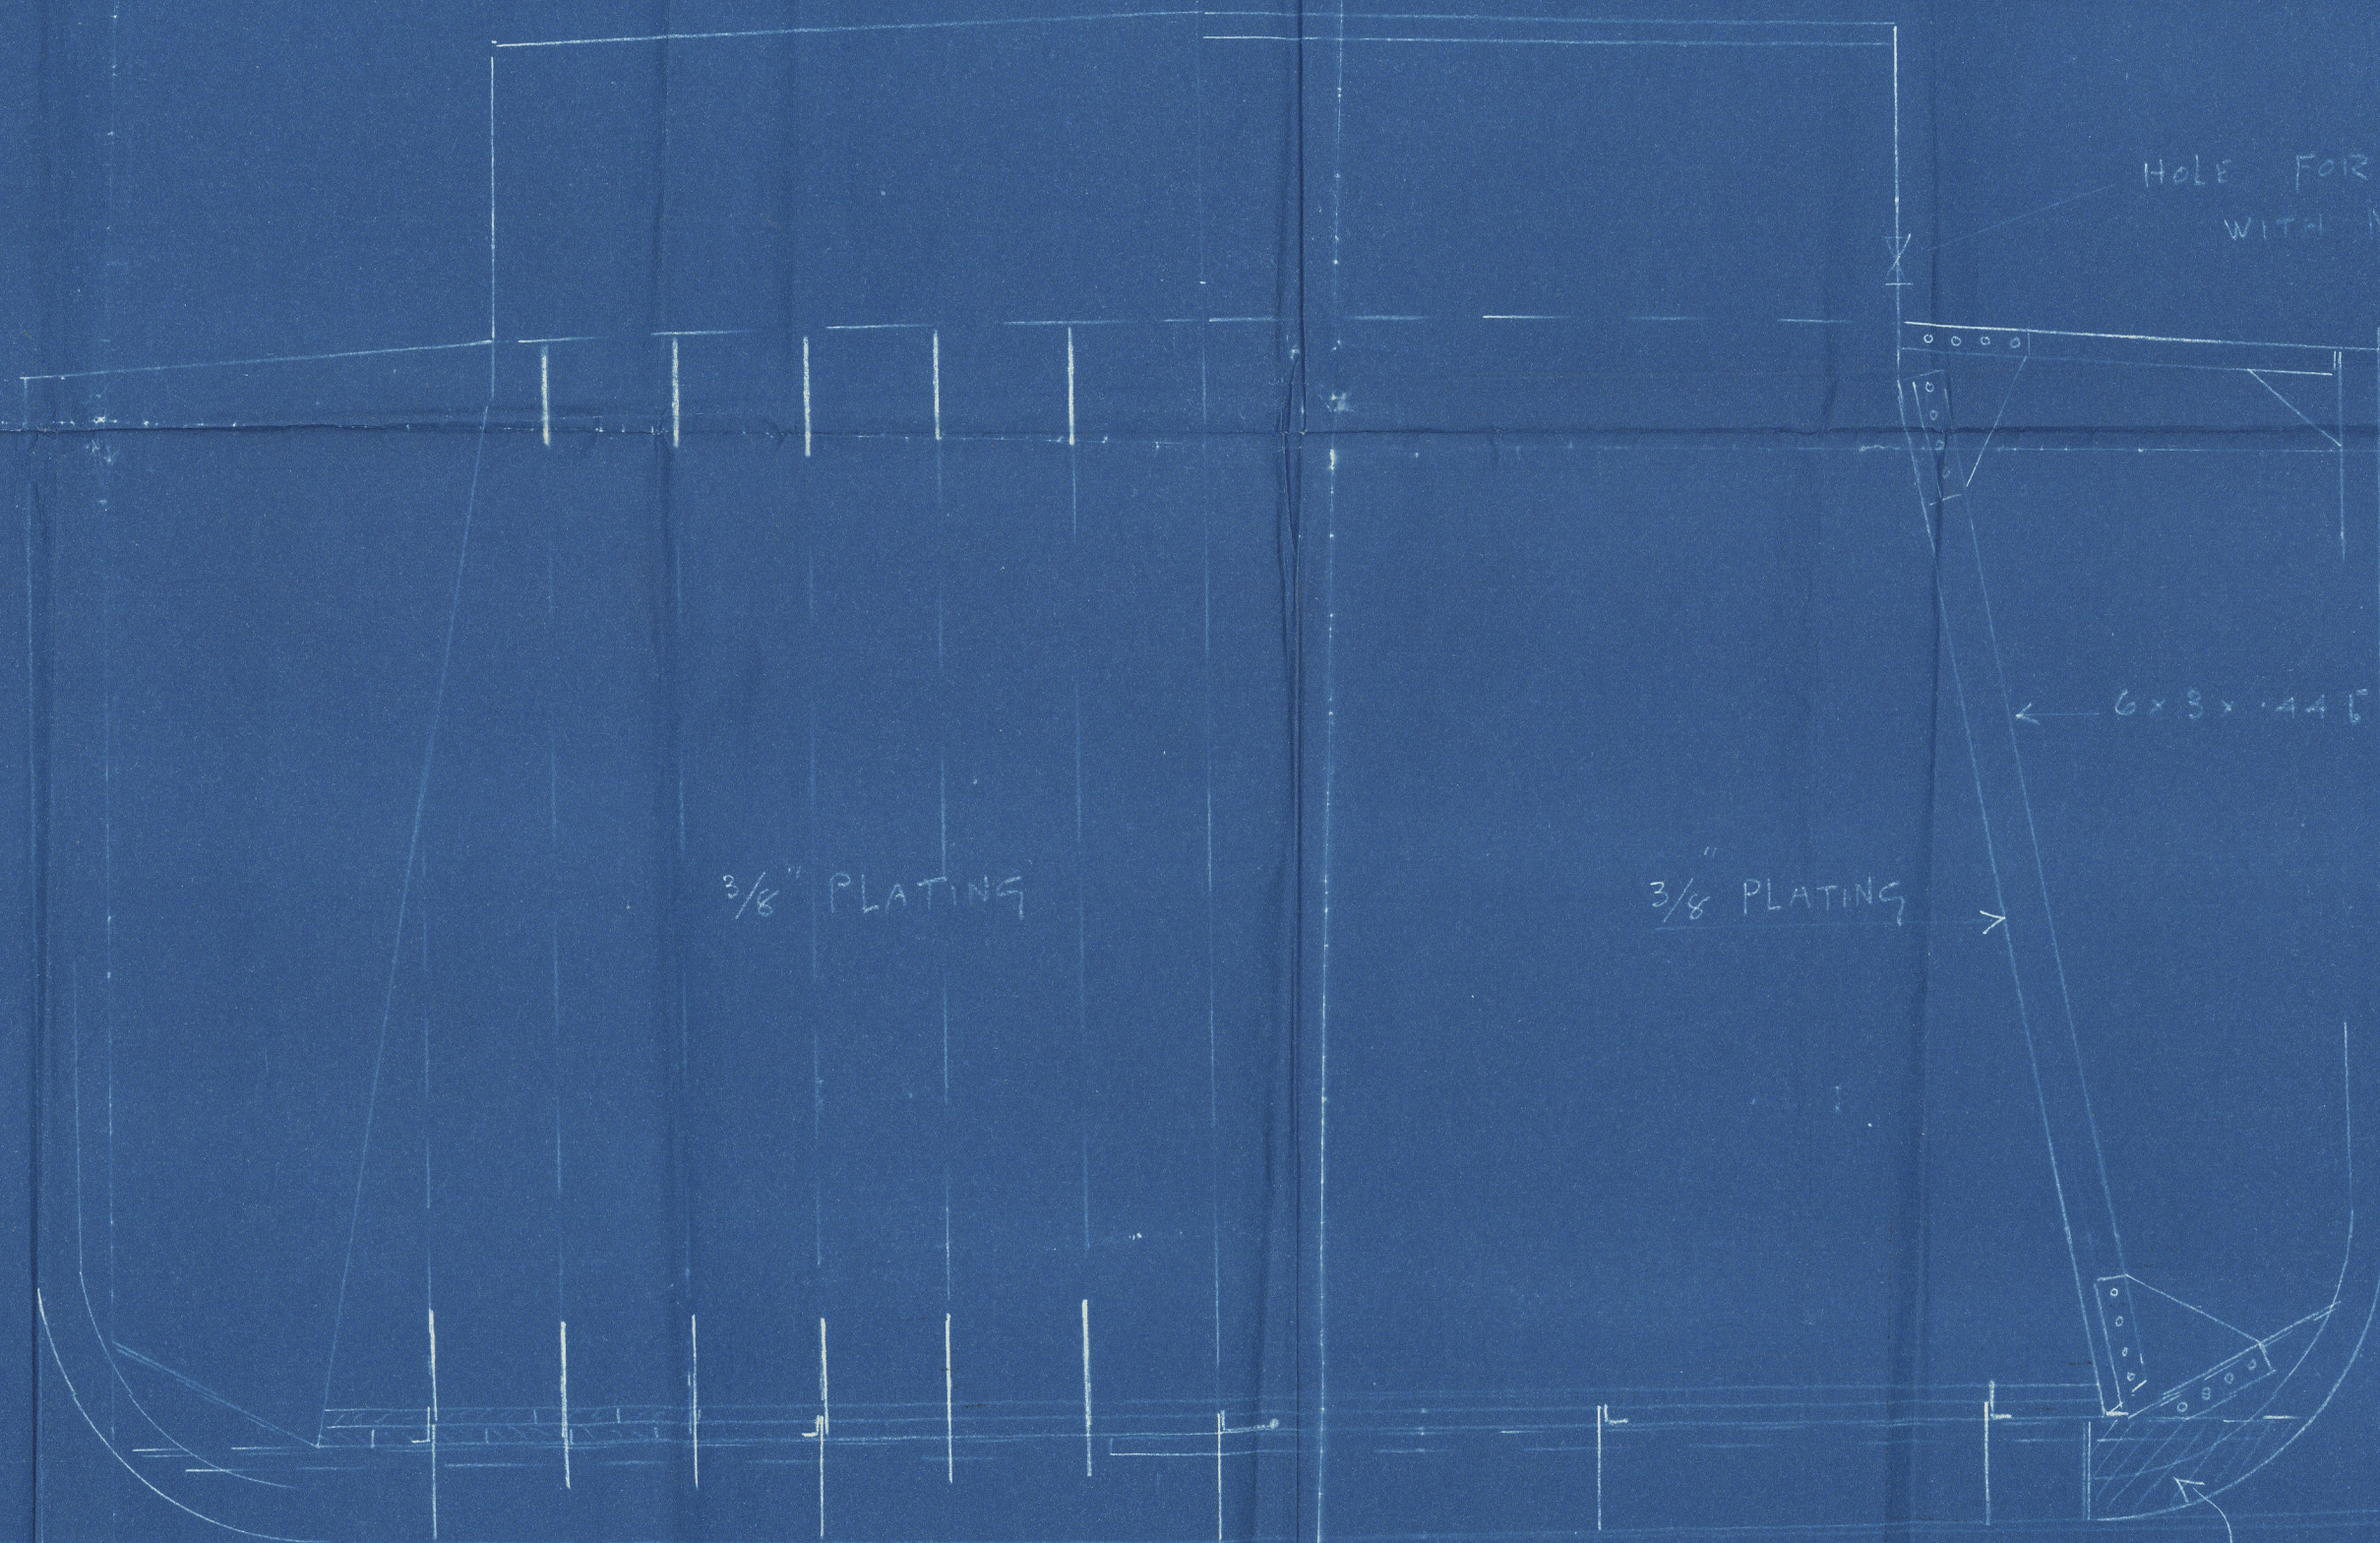


3/5 NORTHGATE

PROPOSED CONVERSION FOR CARRYING & PUMPING SAND IN BULK

Alterations carried out at Cardiff in June & July, 1938, as shown.

See Cardiff Report No. 52481.

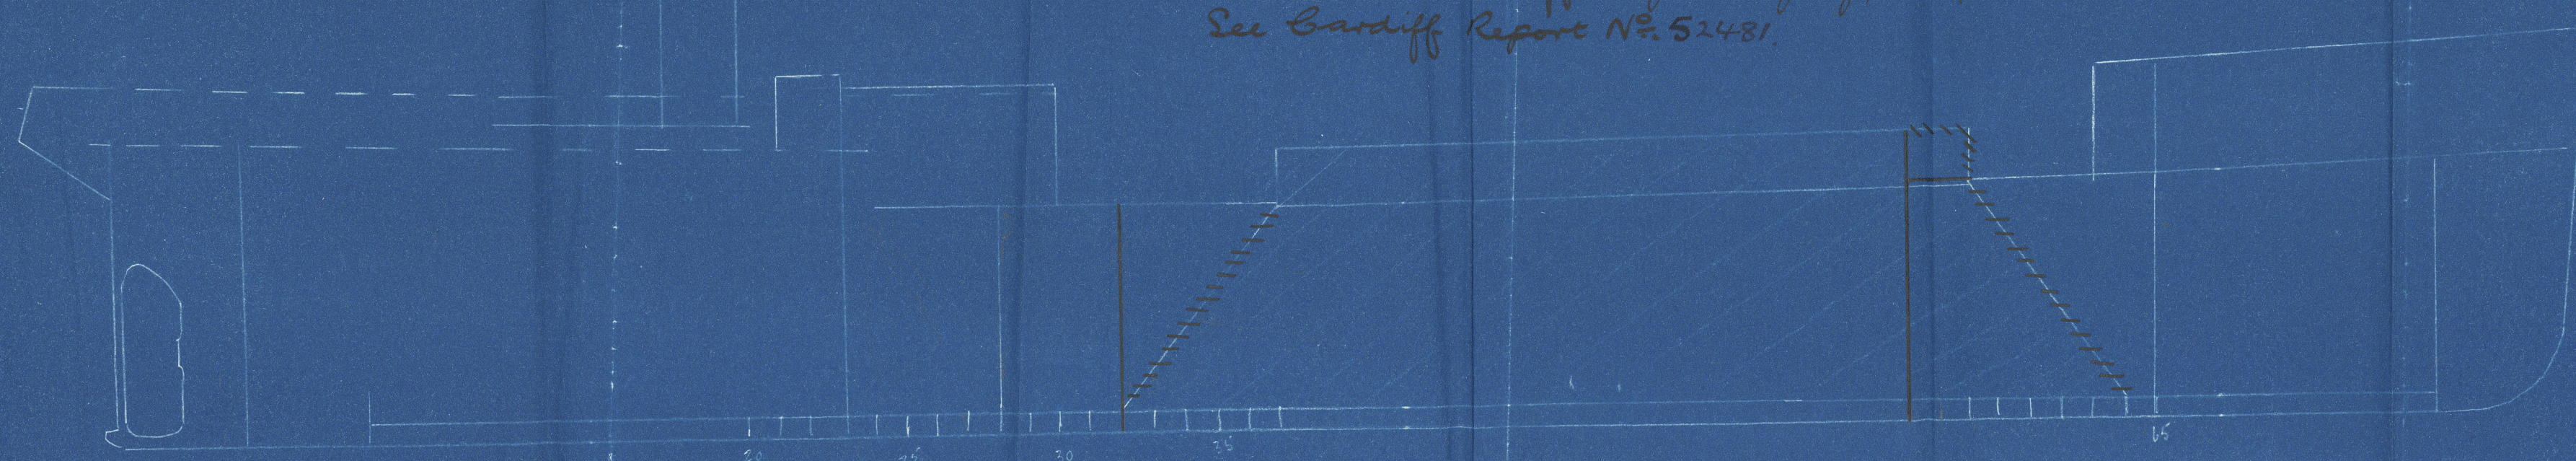

HOLE FOR DRAINAGE
WITH MEANS OF CLOSING WATERTIGHT
TO SURVEYORS' SATISFACTION

← 6 x 3 x .44 C SPACED 22" APART

3/8" PLATING

3/8" PLATING

Cement

← STIFFENERS ON END BULKHEADS
6 x 3 x .44 C SPACED 17" APART
BRACKETED TOP & BOTTOM 4 3/4" WETS

1.11.38

GARDIFF. Report No. 52481.

"Northgate"

n.n.

"Ganth."


W312-0140



© 2019
Lloyd's Register
Foundation