

21/1/25


SHIP N^o 539.

MIDSHIP SECTION

DIMENSIONS. 144'-0" x 25'-0" x 12'-7" D.M.D. TO UPPER DK.

16'-7" TO R.Q.D.

SCALE $\frac{1}{2}$ " = 1 FOOT

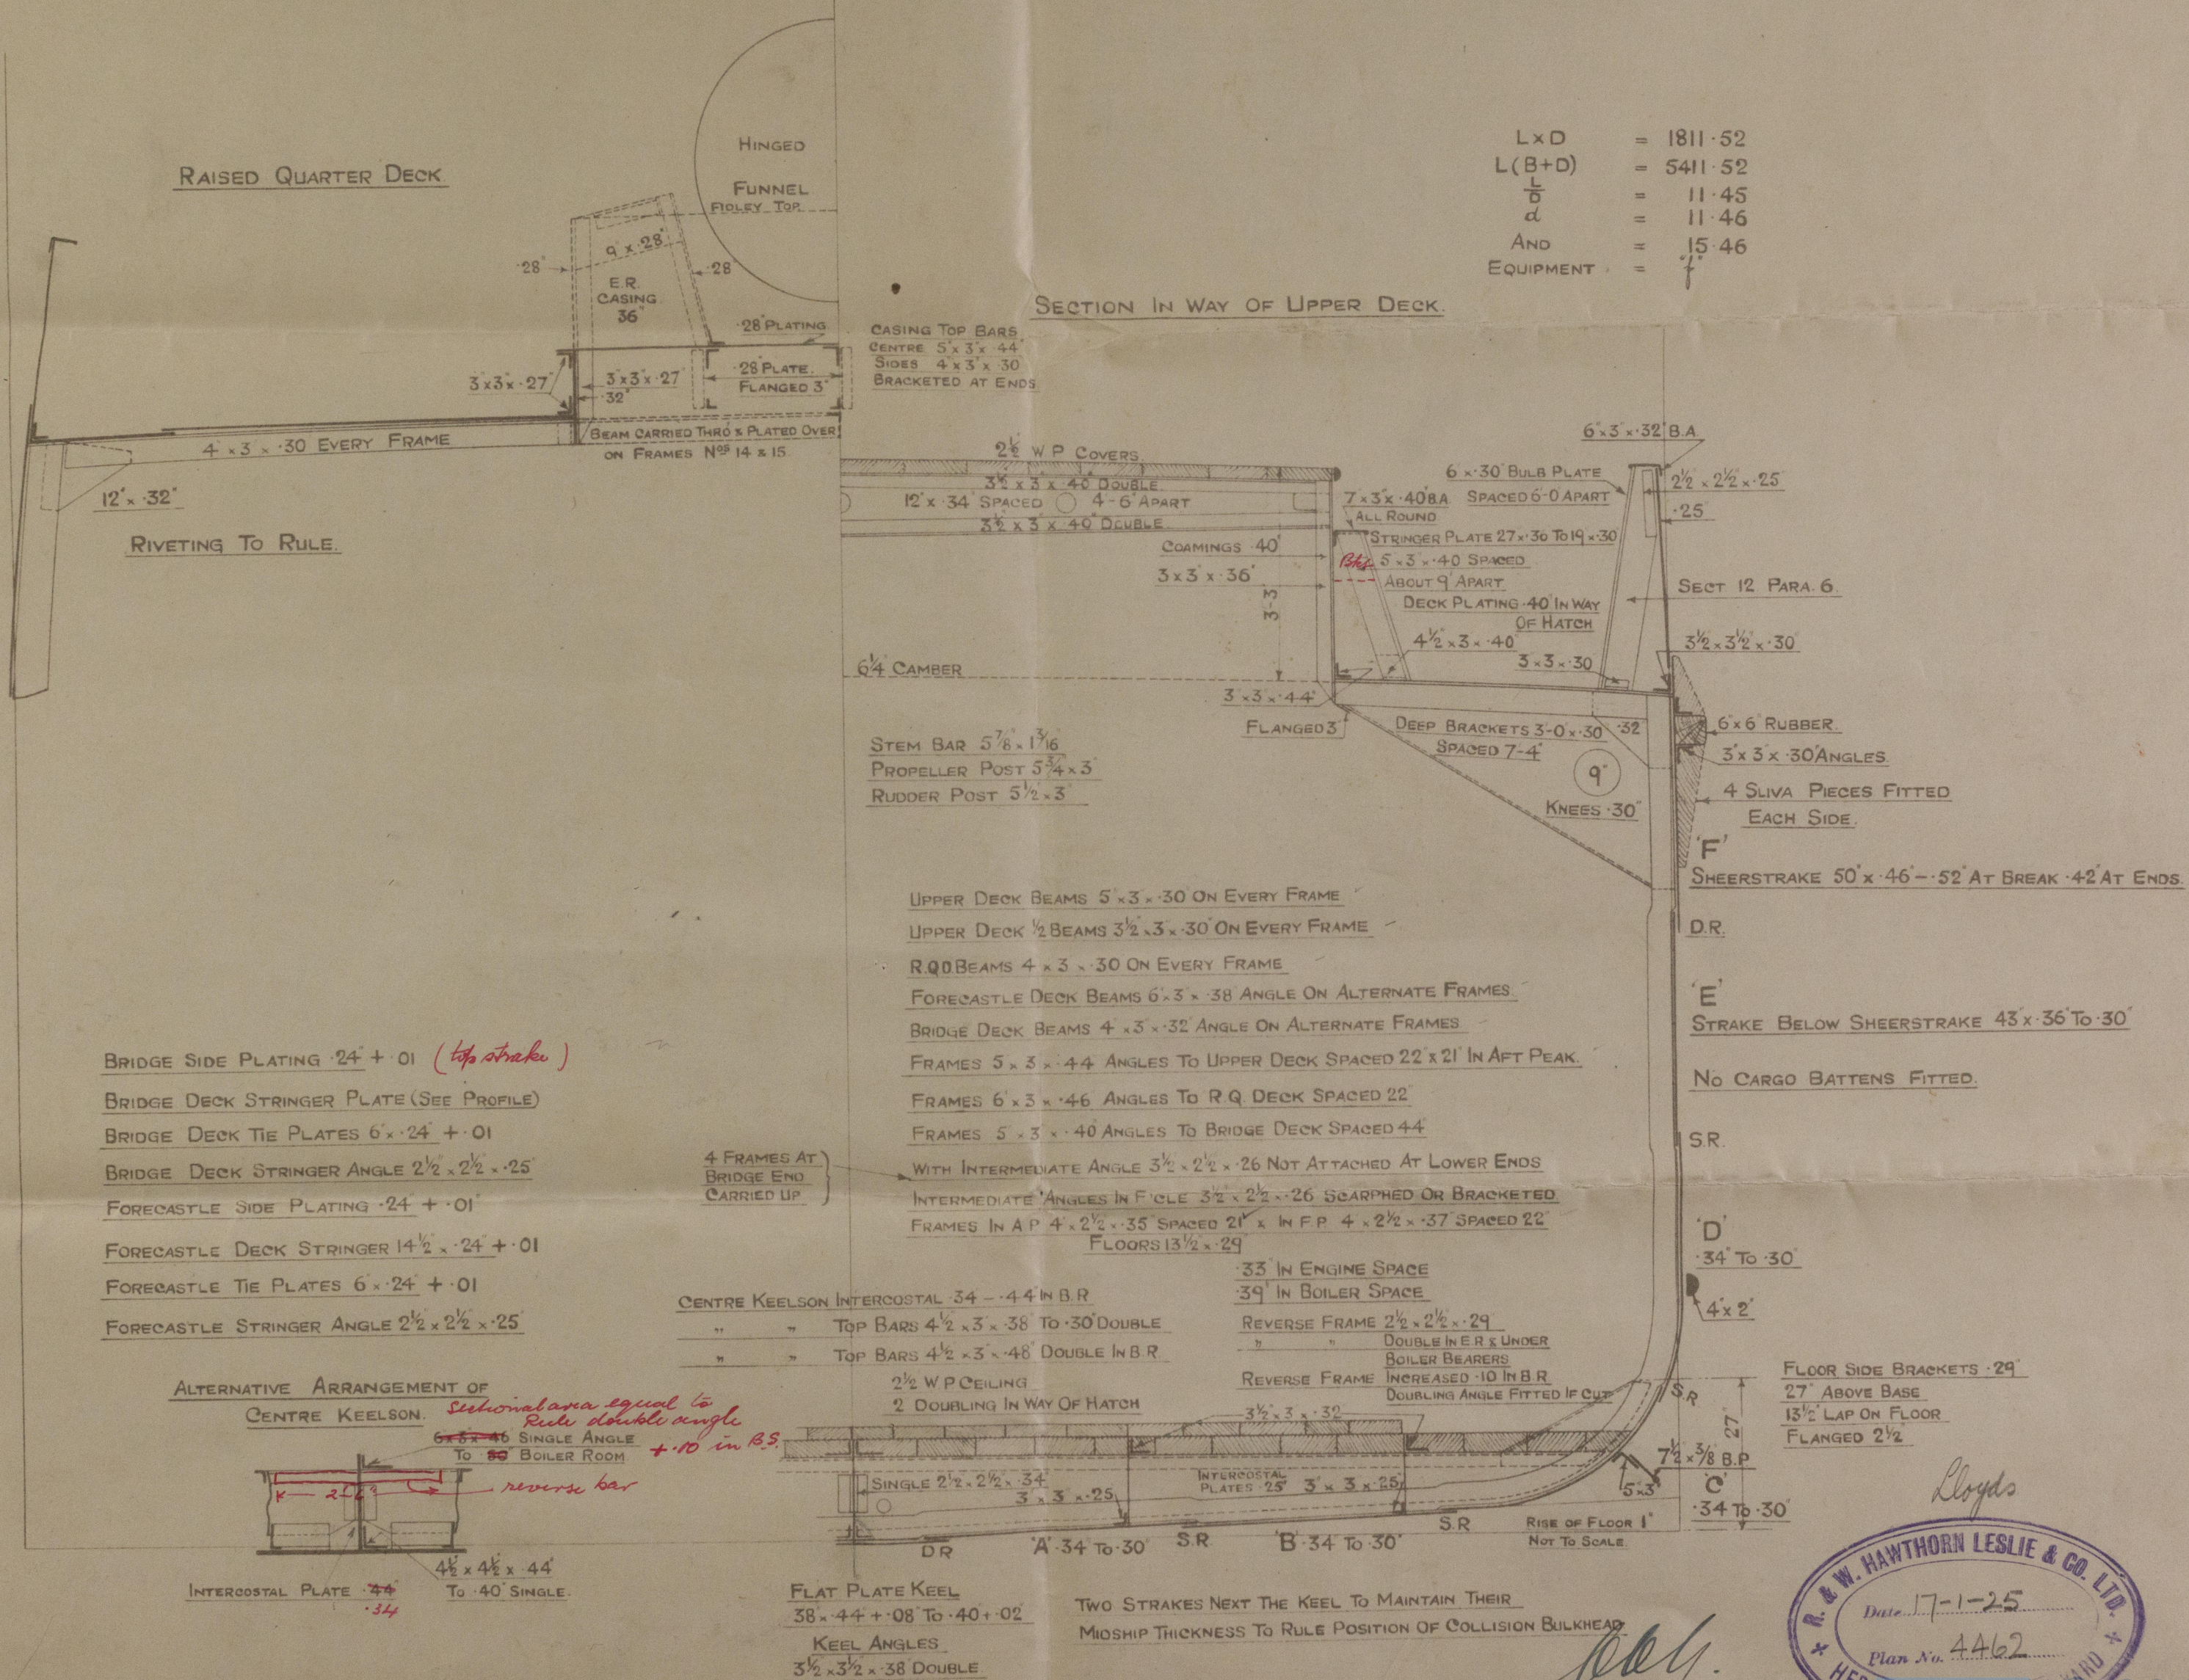

| | | |
|---------------|---|---------|
| L x D | = | 1811.52 |
| L (B+D) | = | 5411.52 |
| $\frac{L}{B}$ | = | 11.45 |
| $\frac{L}{d}$ | = | 11.46 |
| AND | = | 15.46 |
| EQUIPMENT | = | |



1

Hawthorn Leslie

539

Mid - Section


~~"Gard"~~
EX

R.R. No 79247

SS "NORTHGATE"

NEWCASTLE ON TYNE.

Report No. 79247

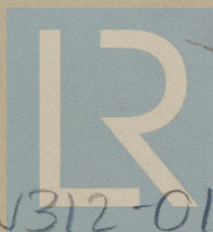

© 2019

Lloyd's Register
Foundation

W312-0148