

S. S. "NORTHGATE".

MIDSHIP SECTION.

CLASS 100 A.I. LLOYDS.

DIMENSIONS 144'-0" x 25'-0" x 12'-7" MLD.

SCALE $\frac{1}{2}$ " = 1 FOOT.

LLOYDS NUMERALS

1ST LONGITUDINAL N° L x D = 1811.52

2ND LONGITUDINAL N° L x (B+D) = 5411.52

$\frac{L}{D}$ = 11.45

$\frac{L}{B+D}$ = 11.46

AND = 15.46

EQUIPMENT = "f"

EQUIPMENT.



2 BOWER ANCHORS 9 CWTs. EACH. STOCKLESS.

1 STREAM ANCHOR 3 CWTs. EX-STOCK.

165 FATHOM OF 1" STUD CHAIN CABLE.

RAISED QUARTER DECK.

SECTION IN WAY OF UPPER DECK.

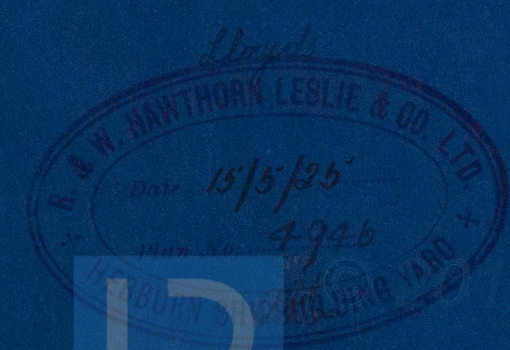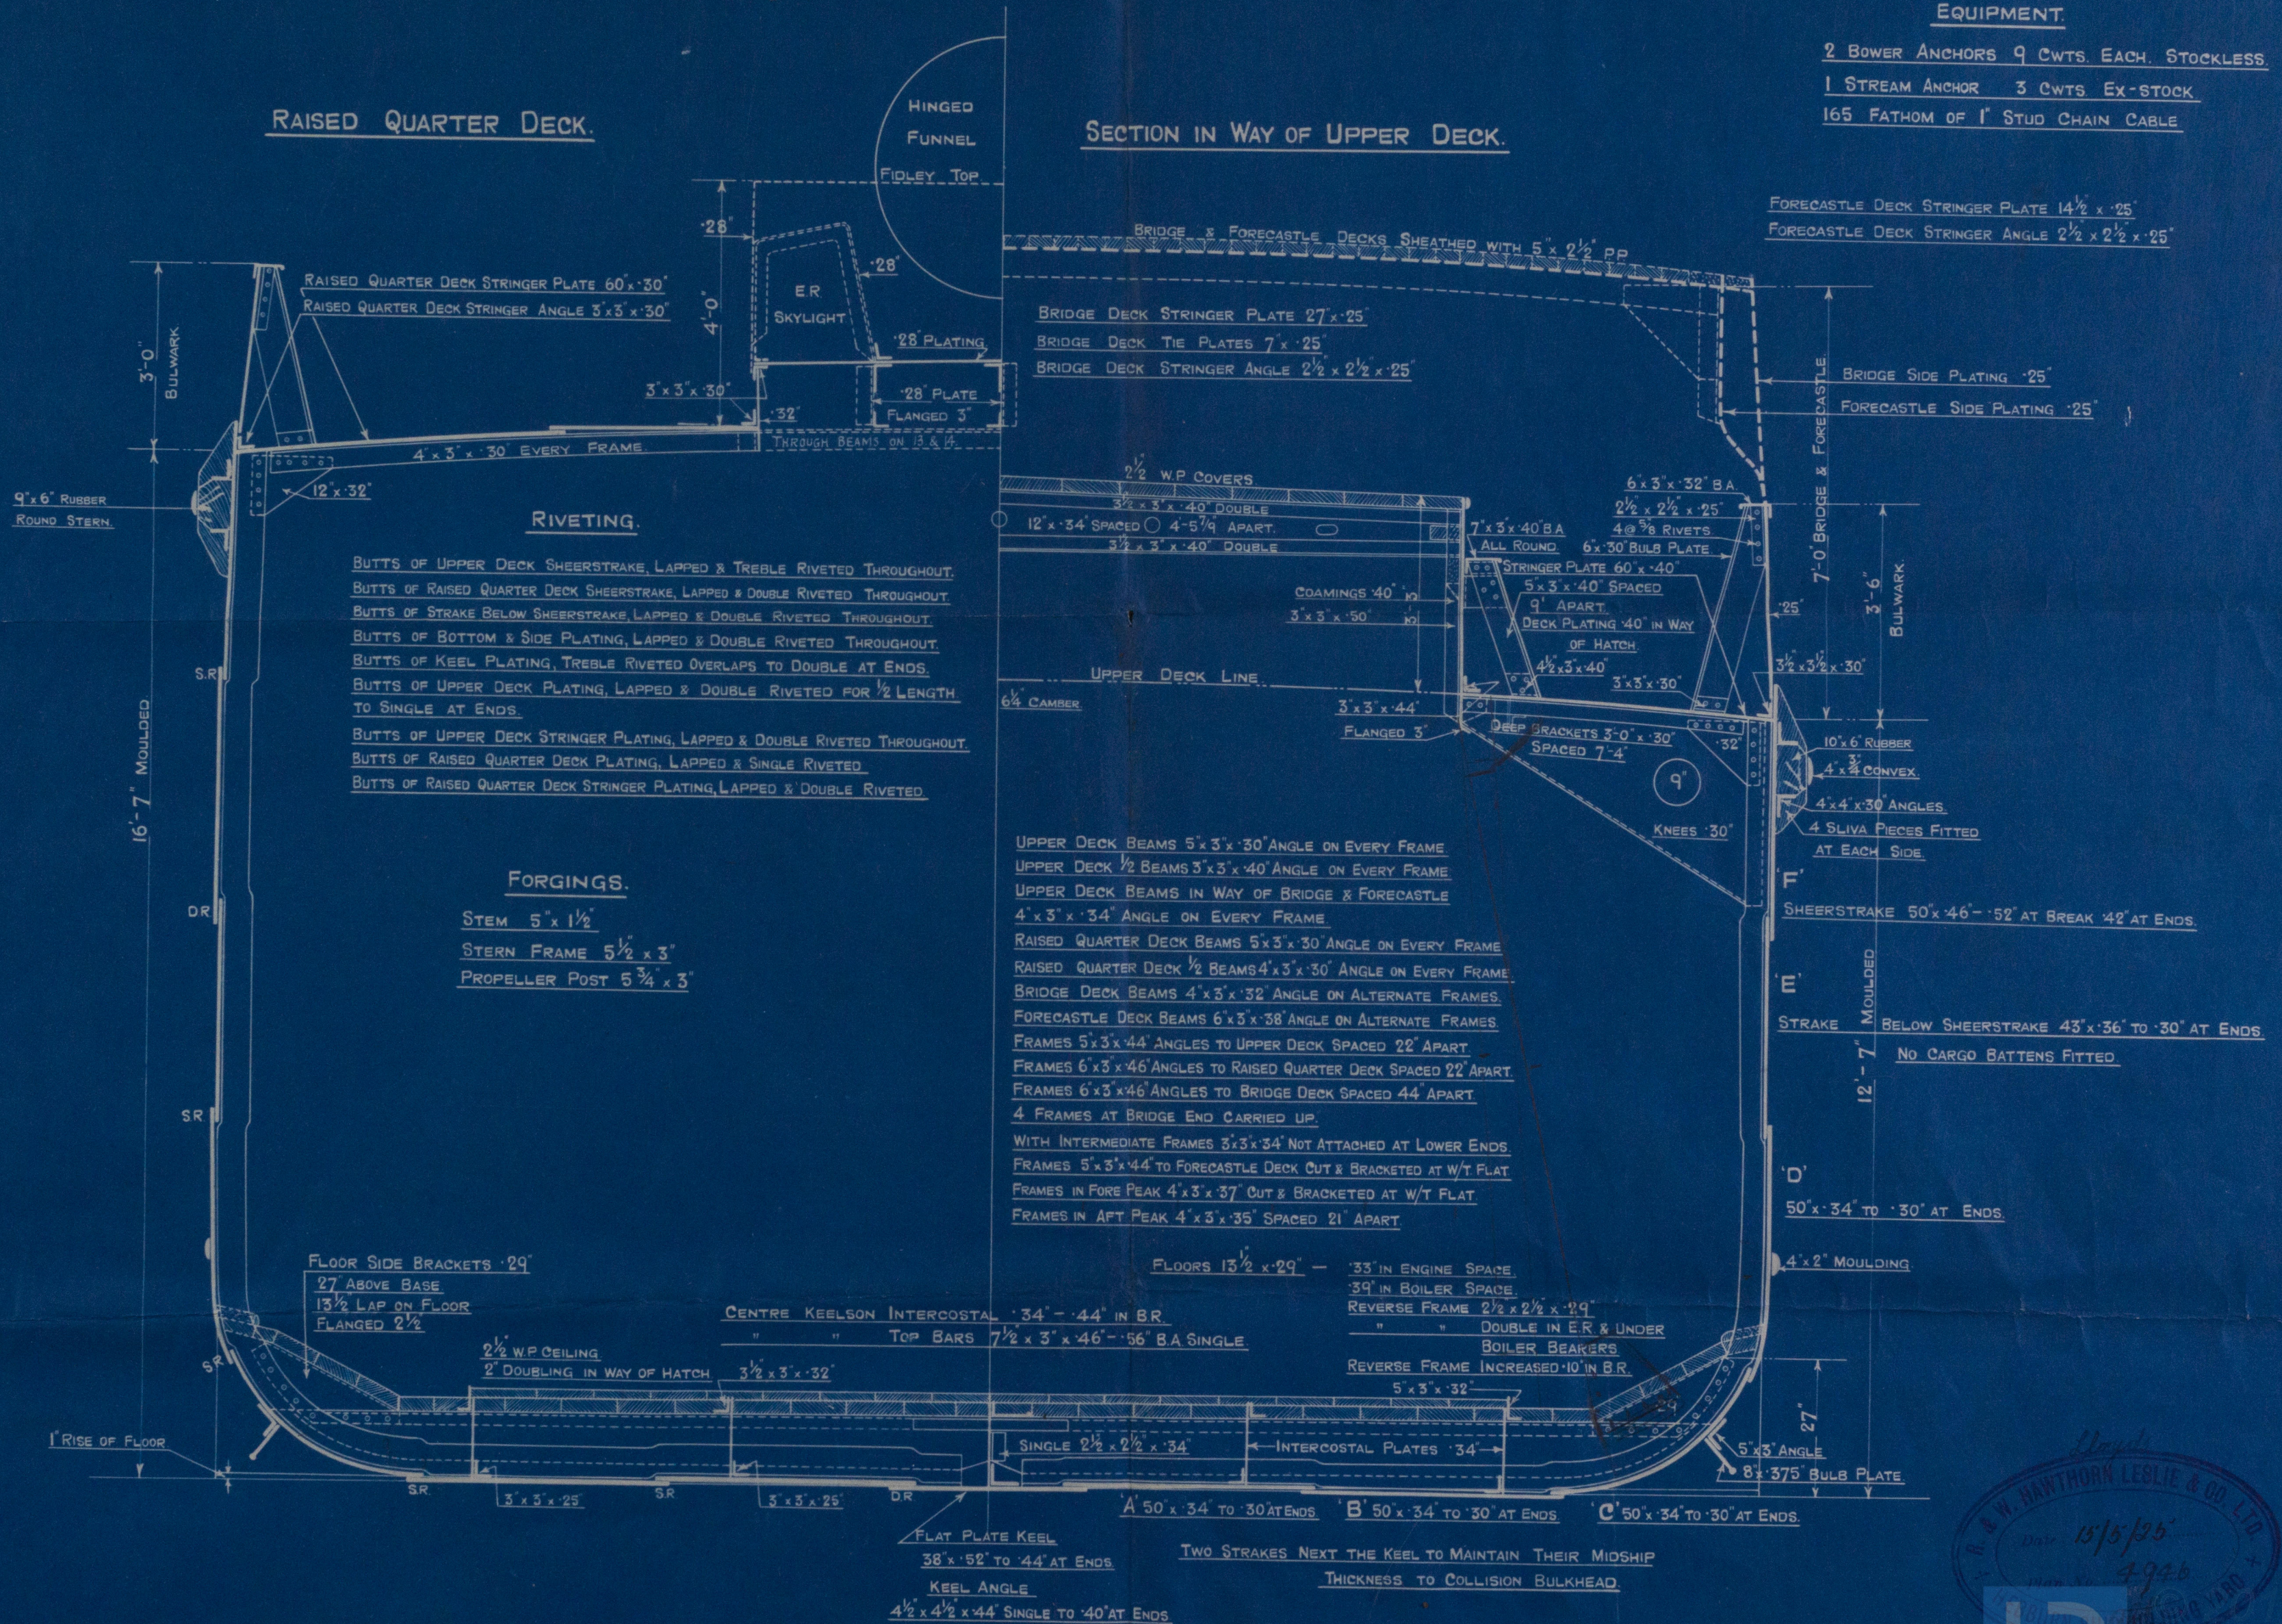

W312-0149

Hawthorn Leslie

539


~~Below~~

Midship Section
(vessel as built).

"Garth"

S.S. NORTHCOTE how "Garth".
NEWCASTLE ON TYNE.

Report No. 79047.

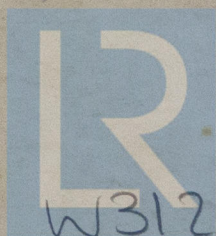

© 2019

Lloyd's Register
Foundation

W312-0149