

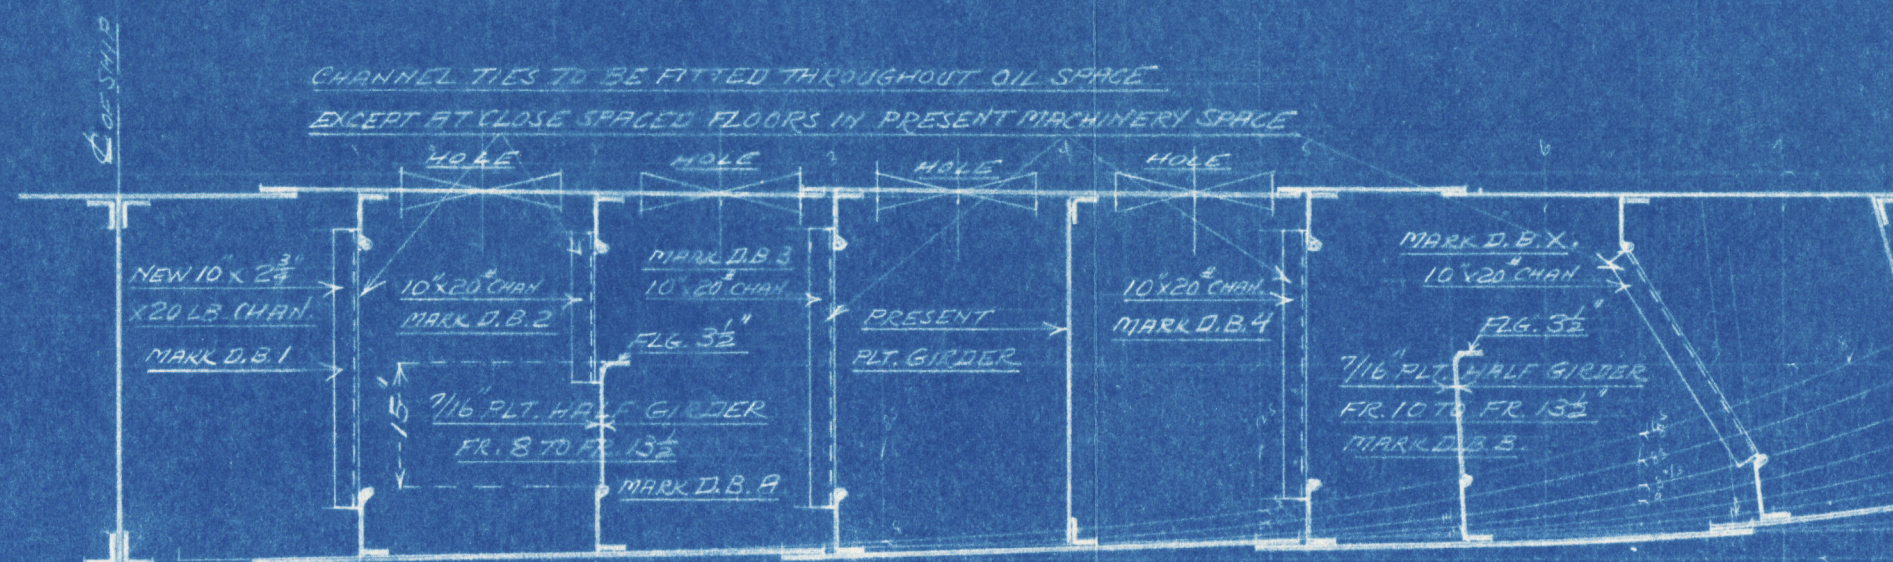



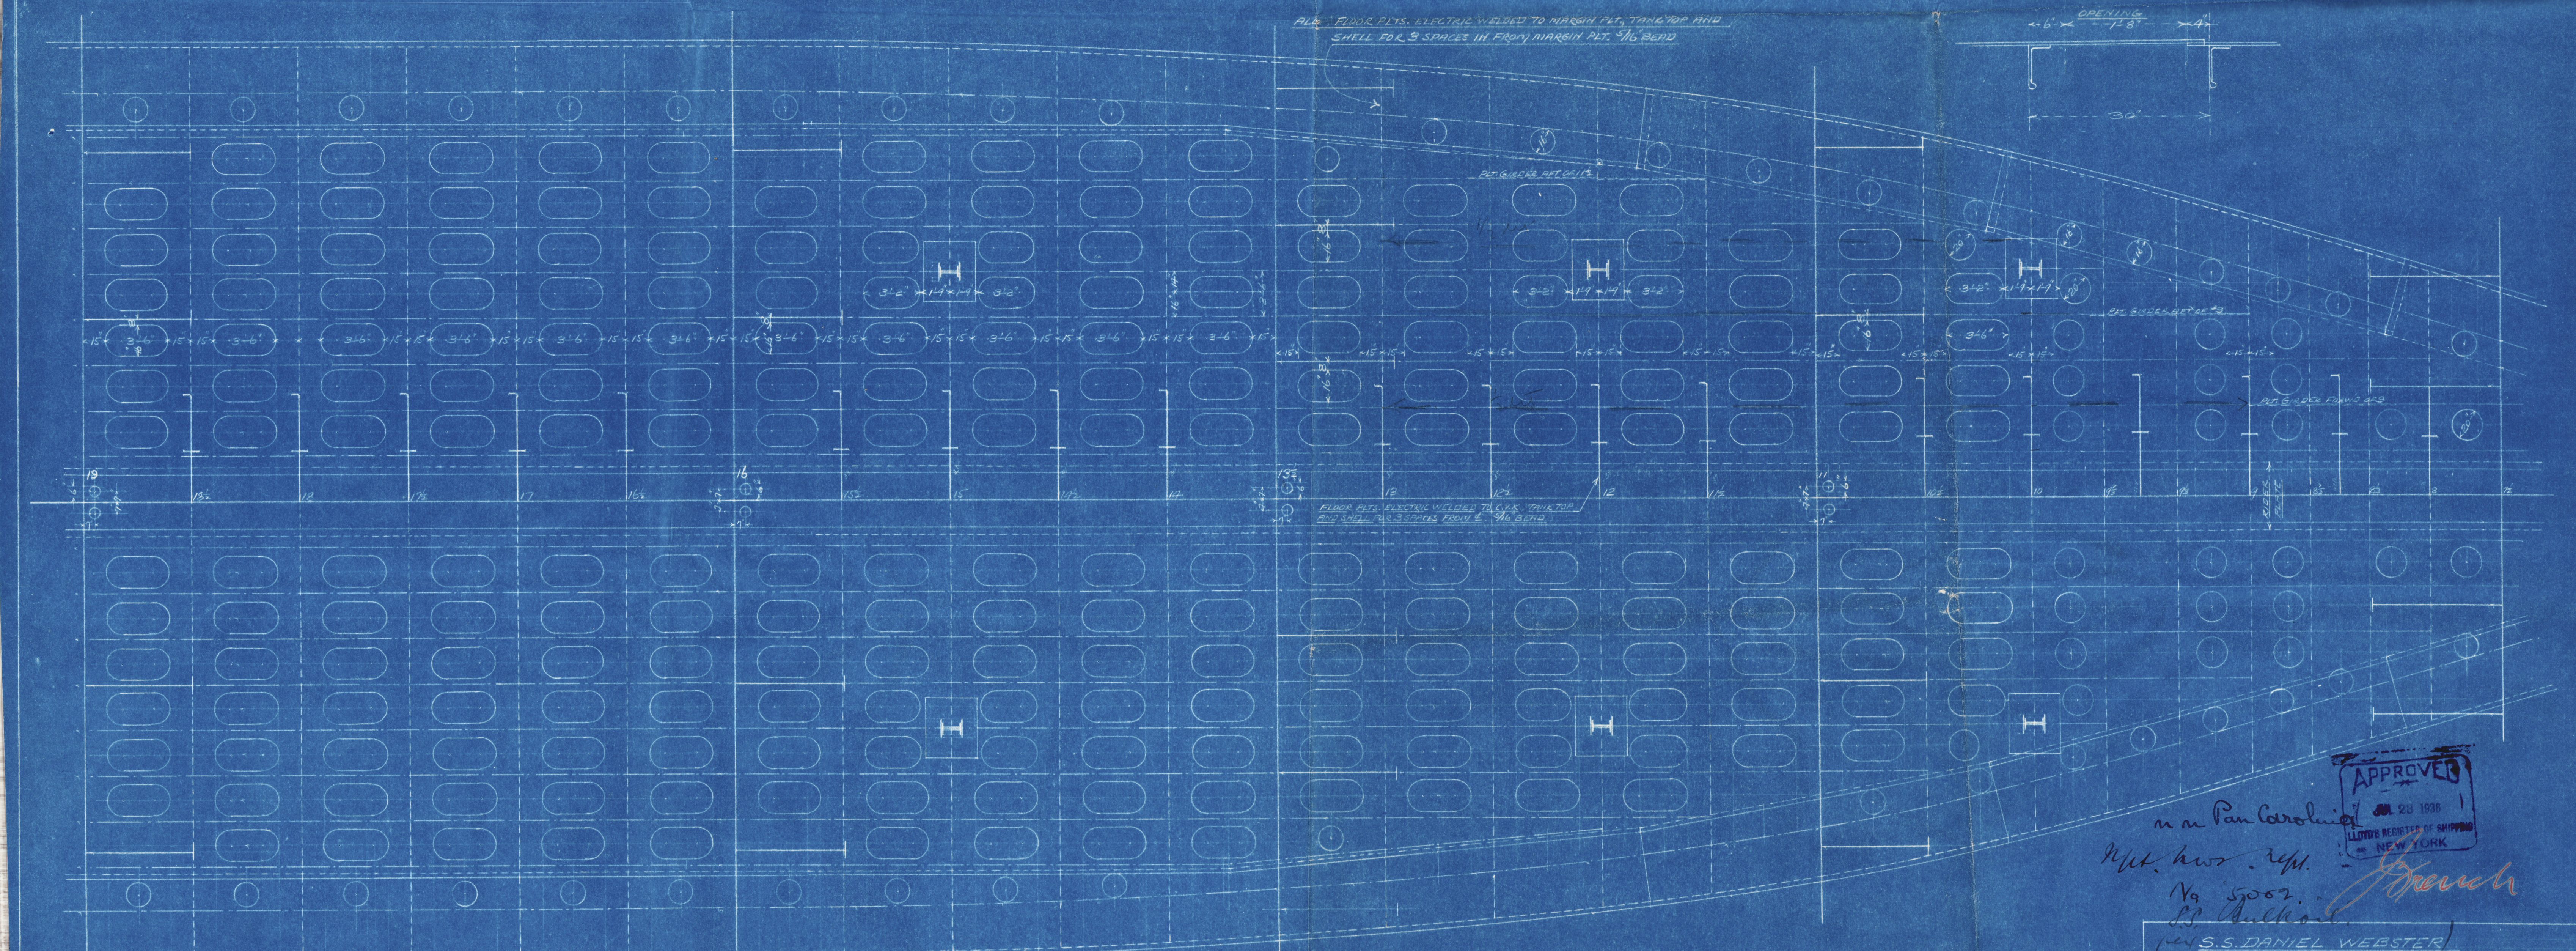


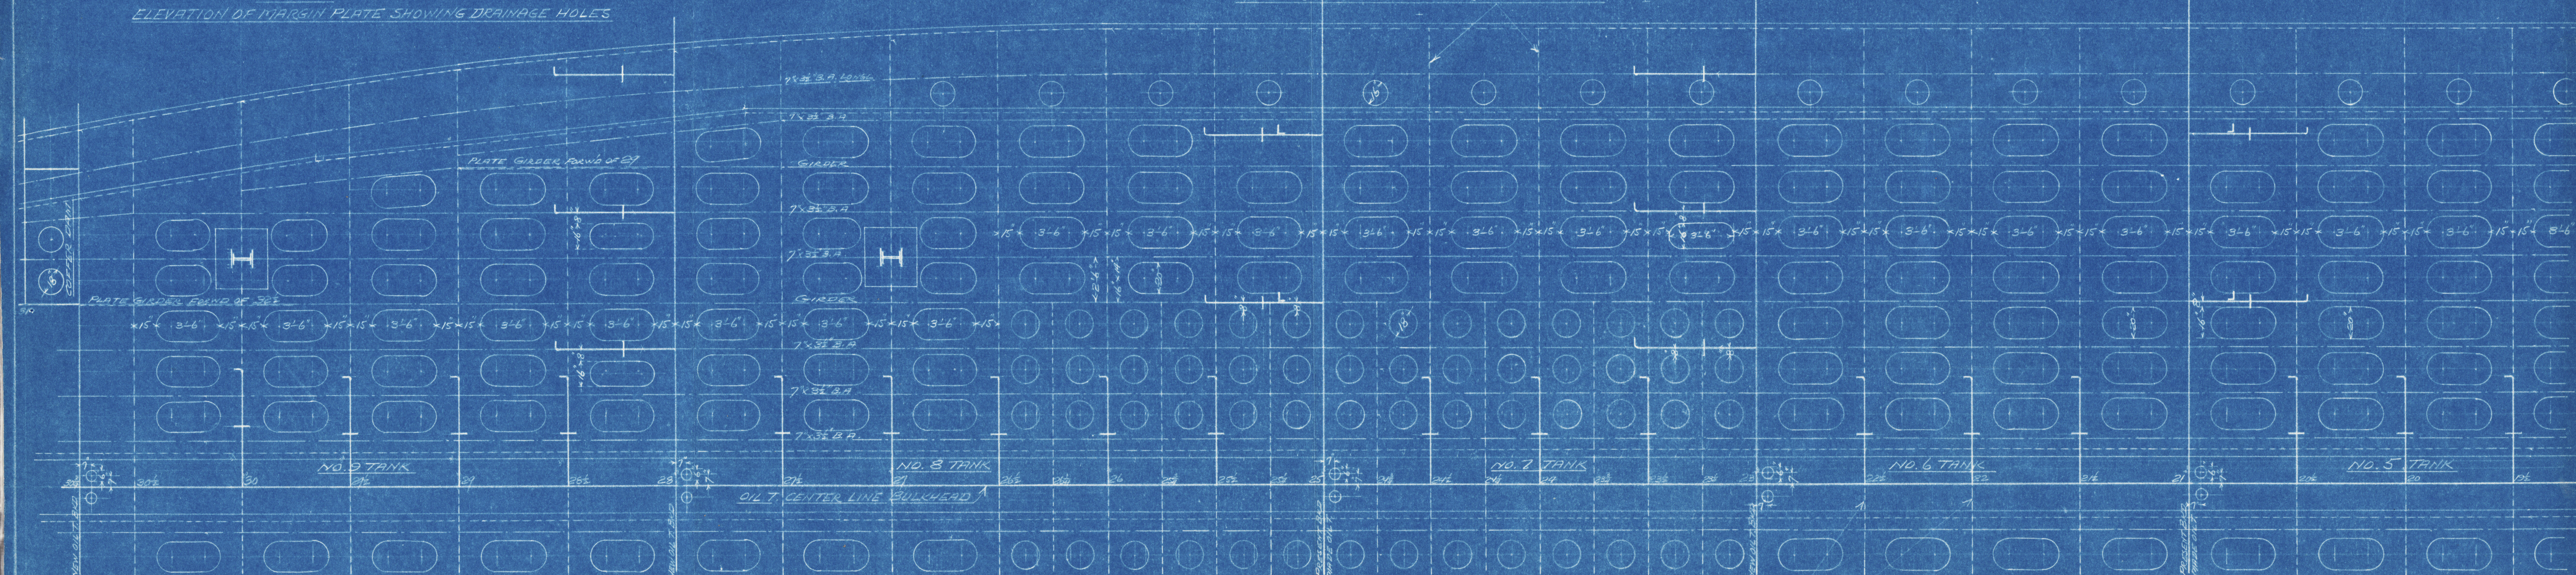

m m Pan Carolina
 Mpt. hwr. rft.
 No 5002.
 S.S. Bullock
 S.S. DANIEL WEBSTER
 CONVERSION INTO A BULK CARRIER
 OPENINGS IN TANK TOP AND
 HALF GIRDERS & TIES IN DOUBLE BOTTOM.
 WELDING ENGINEERS INCORPORATED
 225 S. 15 ST.
 GEO. B. DRAKE
 NAVAL ARCHITECT
 17 BATTERY PLACE NEW YORK

London City