


GENERAL TIME BULKHEAD
CONVERSION 18-7

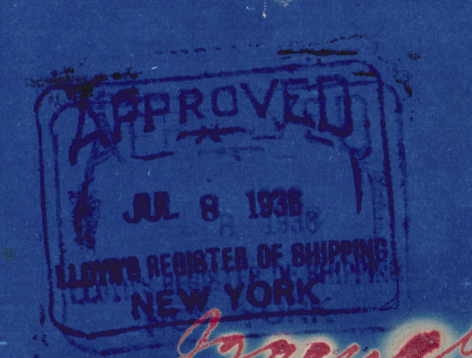

CONVERSION INTO A BULK CARRIER
S.S. DANIEL WEBSTER
JULY 29 1938
WELDING ENGINEERS INCORPORATED
225 S. 1ST ST. PHILADELPHIA, PA.
GEORGE B. DRAKE, NAVAL ARCHITECT
17 BATTERY PLACE, NEW YORK