



W314-0342

27/12/22

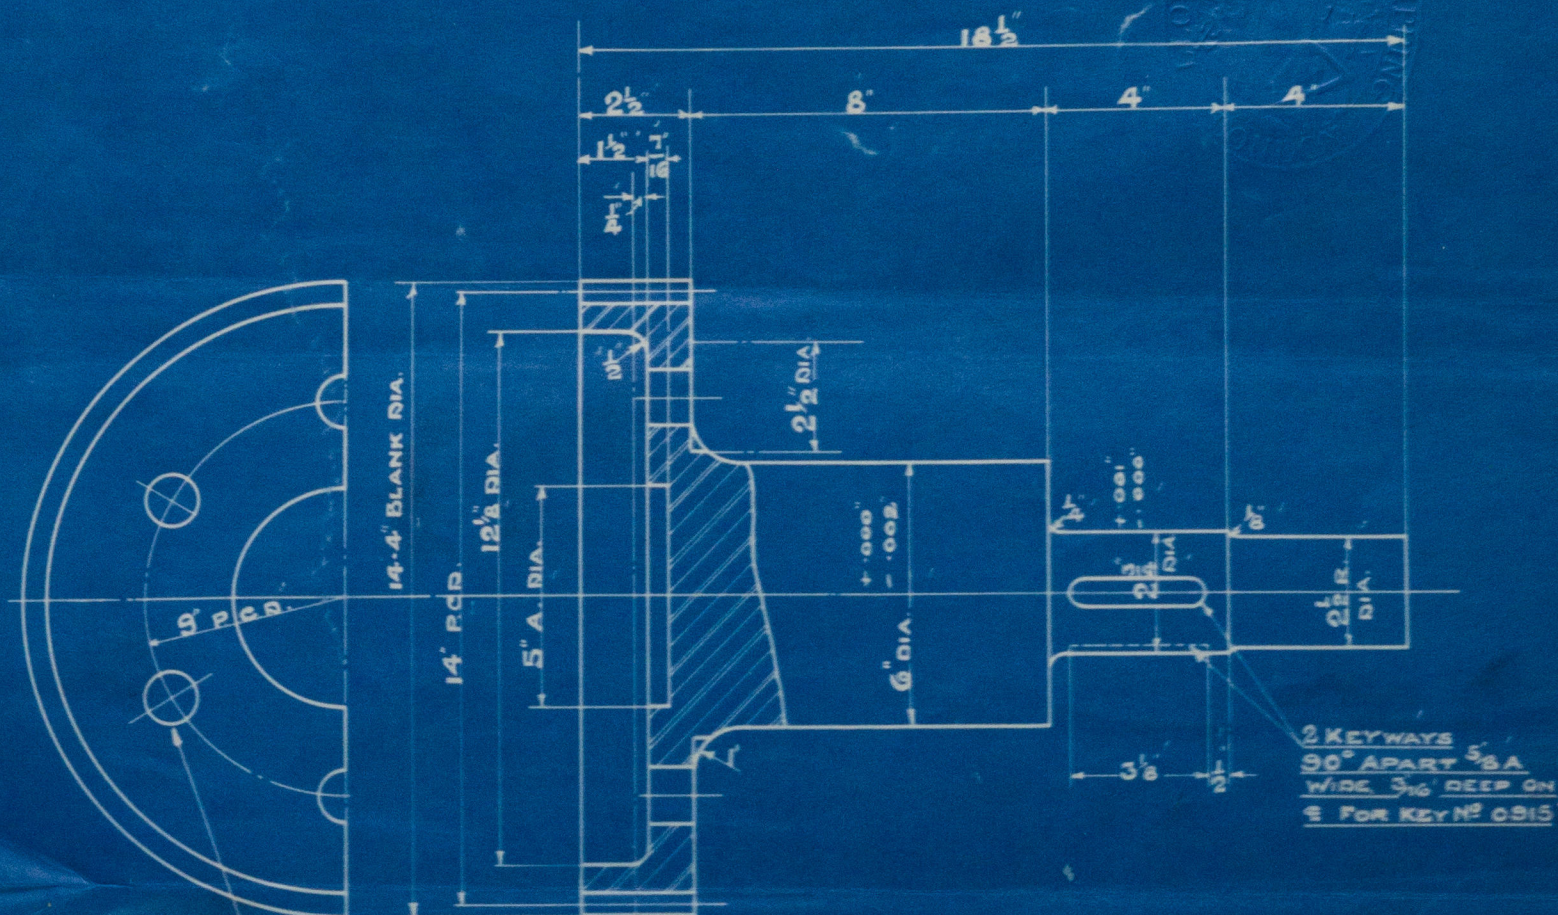

6. 1 1/2" DIA.  
REAMERED HOLES  
CUTTERED 2 1/2" DIA.

SPIRAL GEAR  
35 TEETH  
NORMAL DIAMETRAL PITCH 5  
DEPTH OF TOOTH .4314  
ANGLE OF TOOTH TO AXIS 60° RH

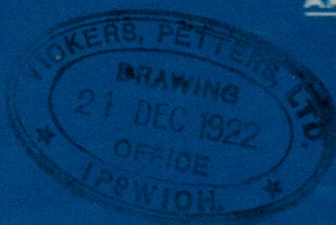

*J.L.*  
27-12-22

NOTE!

MATERIAL TO BE TO LLOYD'S REQUIREMENTS.

MACHINED ALL OVER

# CRANKSHAFT EXTENSION

DRAWN BY	JE	14.12.22	ISSUE NO	DATE OF ISSUE	ALTERATIONS	ALT BY
TRACED BY	LB	20.12.22				
CHECKED BY	<i>LB</i>	<i>20.12.22</i>				
APPROVED BY	<i>J.M.</i>					
PATTERN N <sup>2</sup>	MATERIAL					
	S.M.A.S.					

SCALE 3" = 1 FOOT

PART N<sup>2</sup>

220124

Vickers-Petler

Eng 550-551

Grant R Shap-Extension

London Apr 86804

"Karen"

Ref No  
Rpt 574

W314-0342



© 2019

Lloyd's Register  
Foundation