


22 223

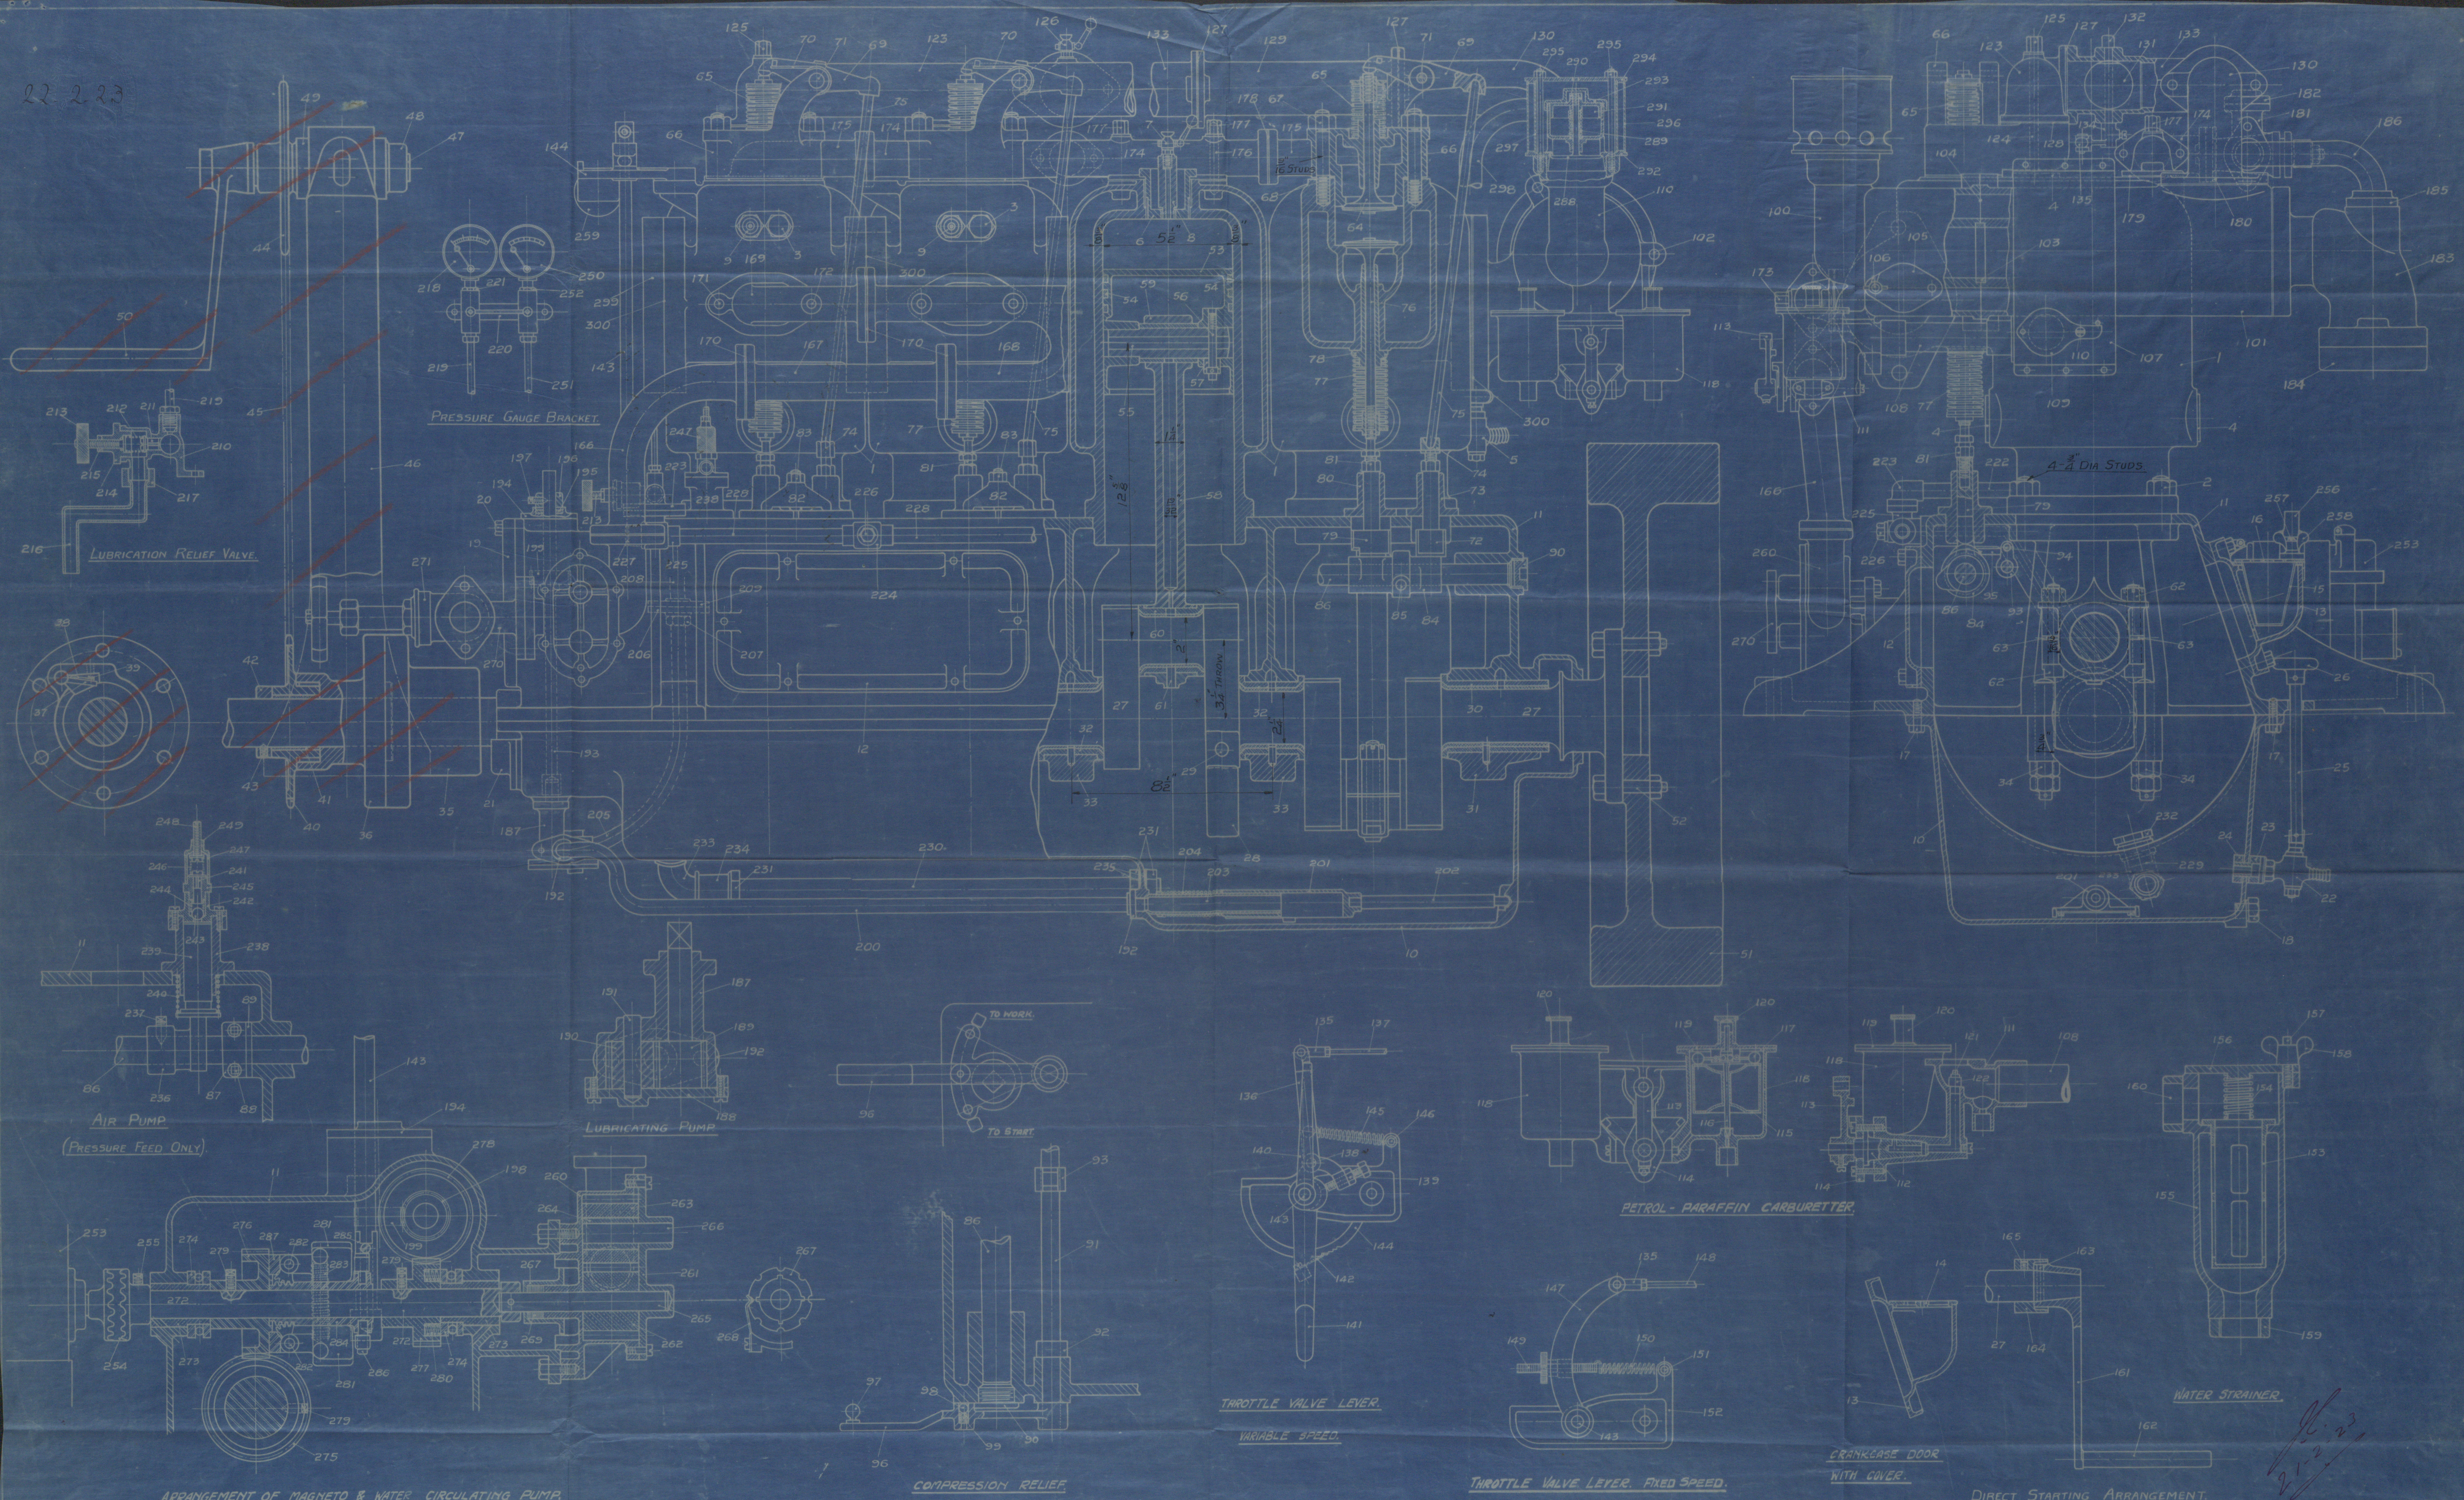

DWG. NO.		TYPE 100CR OIL ENGINES.		THE SAME DETAILS APPLY TO 2-3 & 4 CYLDR. ENGINES.		For Key SEE DWG. NO. 4232W.	
DESCRIPTION		DETAIL ORDERING PLAN.		SCALE $\frac{3}{8}$ FULL SIZE.			
L. GARDNER & SONS, LTD.		PATRICROFT.		SCALE			
MATERIAL		MACHINED		SUPERSEDES		SUPERSEDED BY	
DATE Feb 10 1928		JIG No.		DRAWN BY W.Y.		CHECKED BY M.H.	
				DWG. No.		DWG. No.	

Handwritten signature and date: 2/2/28

W3450344

MANCHESTER.

7- L. Gardner Sun. L.

AUX. GEN⁹ SET.

for

7- Camper & Richelson

Yacht 314

GENERAL PLAN

ENGINE NO. 25563.

"Karen"

Rpt No 115764

W314-0364



(5) 14/2/23

(a) 22/2/23 (E)

as shown

Lloyd's Register
Foundation