
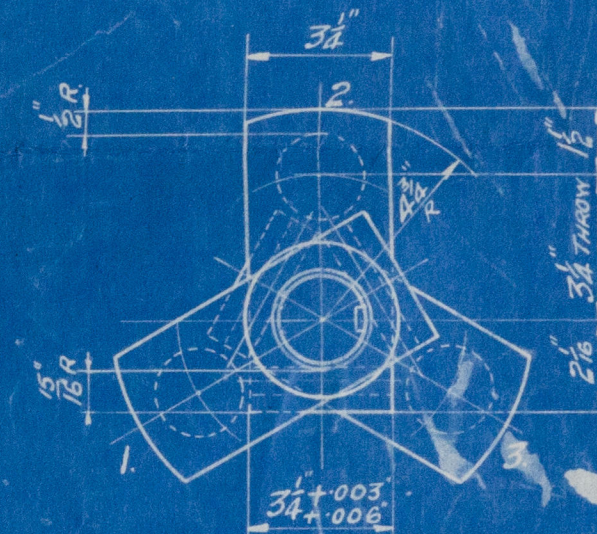


22223

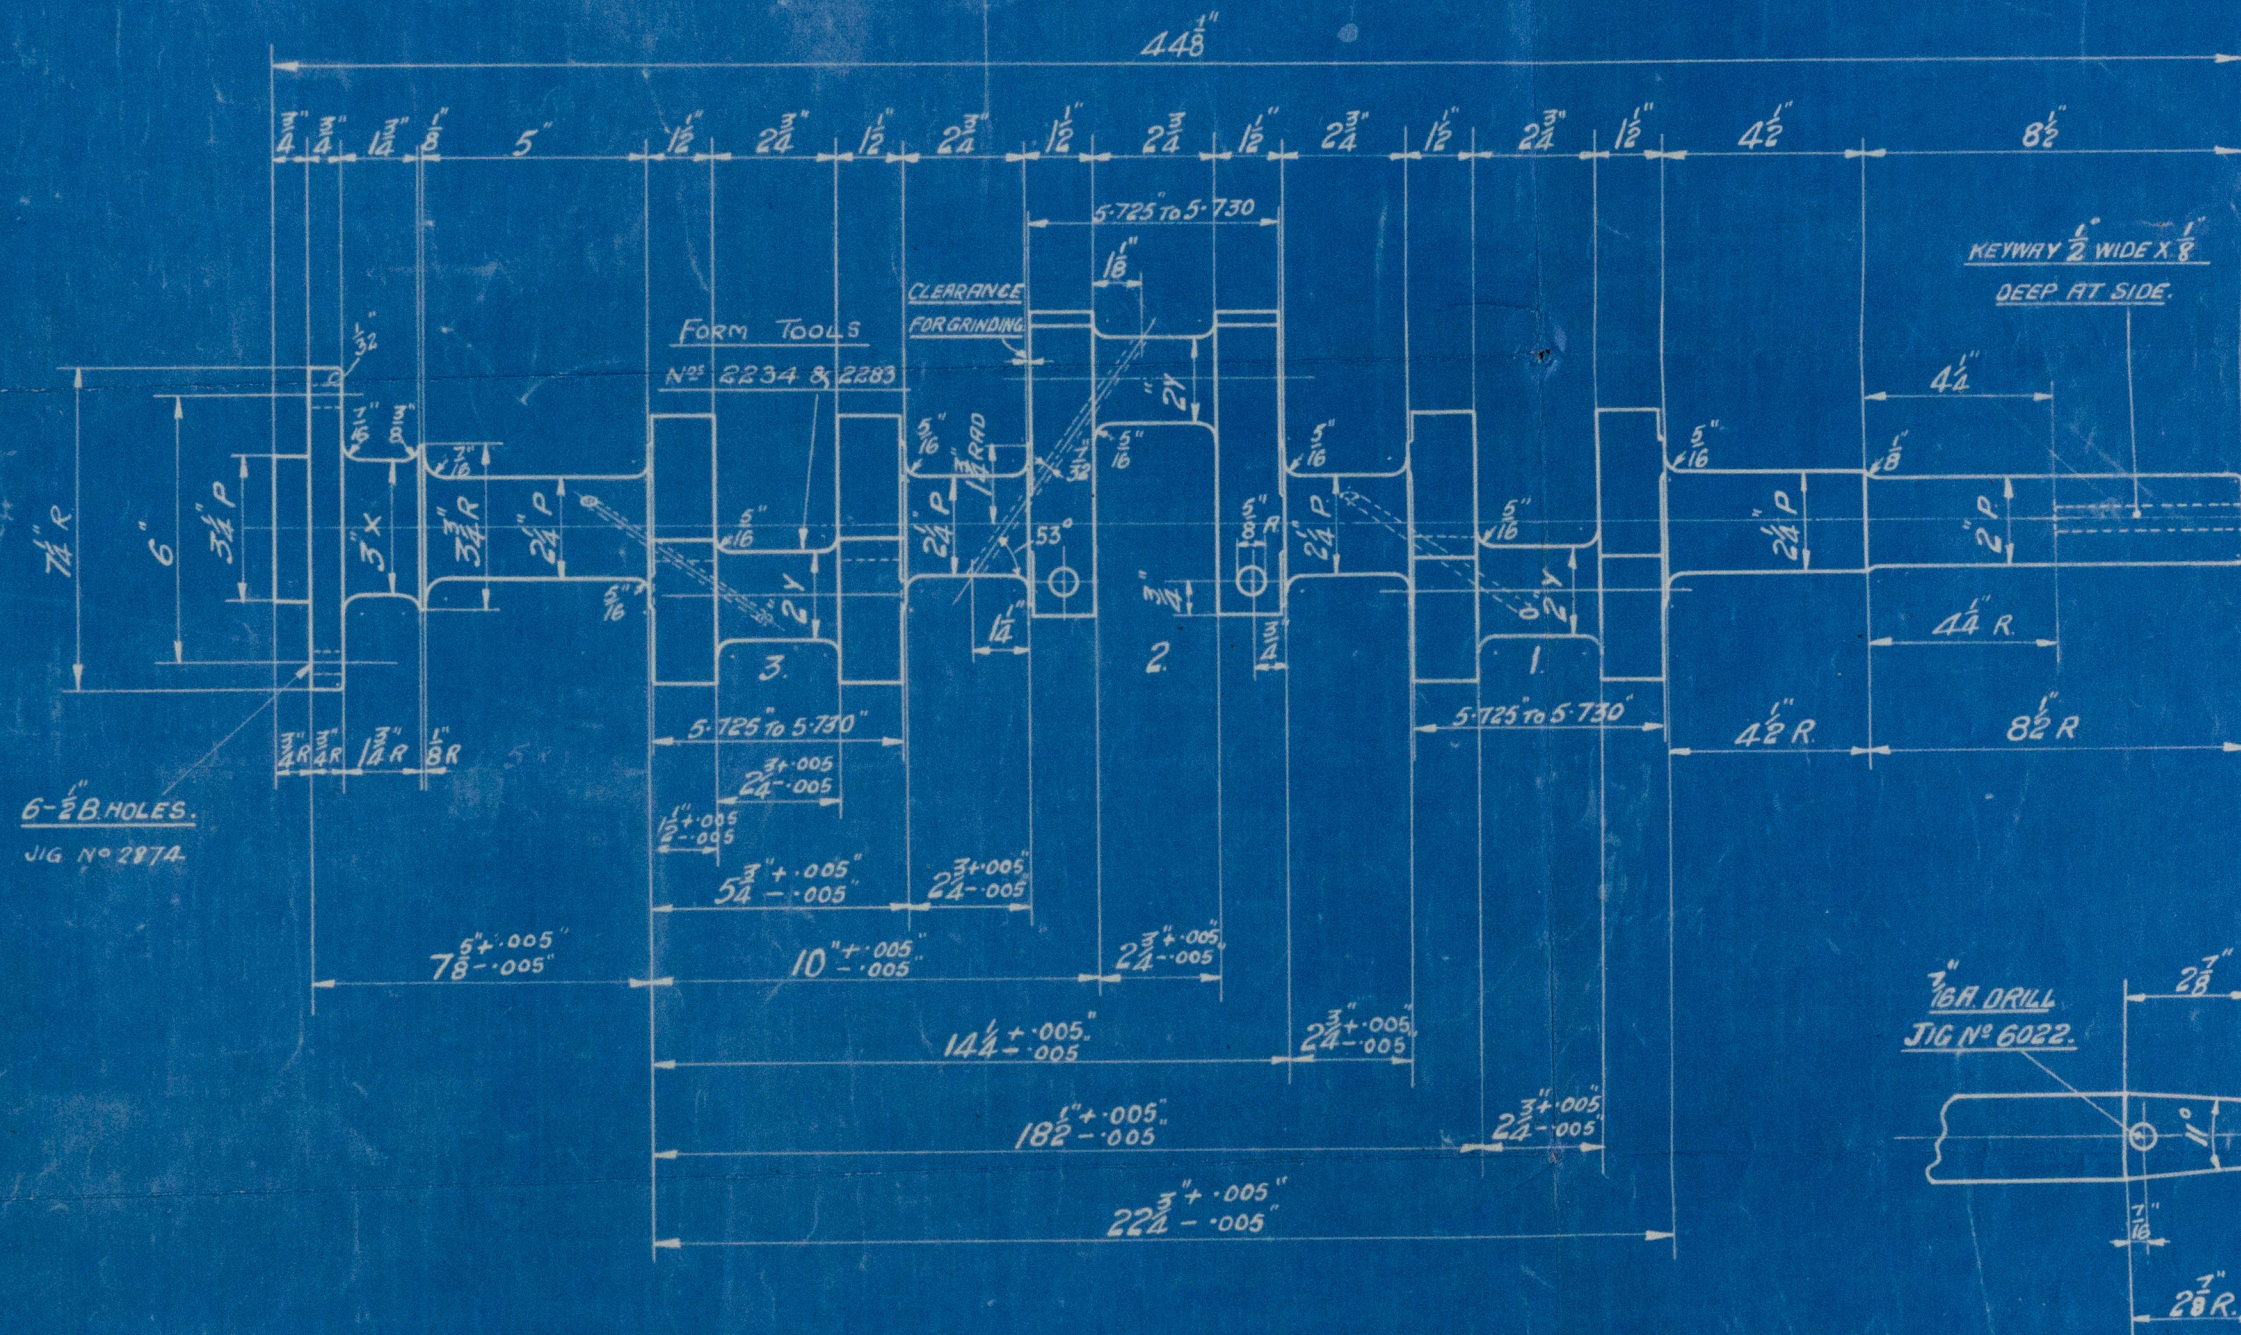

BALANCE WEIGHTS ON ALL WEBS.

SHAFT TAPERED AS SHOWN
FOR STATIONARY TYPE ENGINES.

L. GARDNER & SONS LTD.
PATRICROFT.

TYPE 3DCR ENGINE ENGINE
DESCRIPTION CRANKSHAFT.
SCALE 1/4 FULL SIZE.

MATERIAL

MACHINED
ALL OVER

SUPERSEDES

SUPERSEDED BY

DRAWN BY

TRACED BY

CHECKED BY

DATE Nov 30/21.

DWG. No 3940X

21-2-23



61314-0345

MANCHESTER.

M. L. Gardner Sun. L.

AUX. GEN^E SET.

for
M. - Camp & Dickinson
Yacht 314

CRANK SHAFT

(FORGING No 645.

LLOYDS. AL. 5. 4. 23)

Forged No 645.

ENGINE No 25563.

Shop No 7 Engine 25563

"Karen"

Rpr No
11574




W314-0345

© 2019

(5) 14/2/23

(4) 22/2/23 (E)
as shown

Lloyd's Register
Foundation