



15.5.06

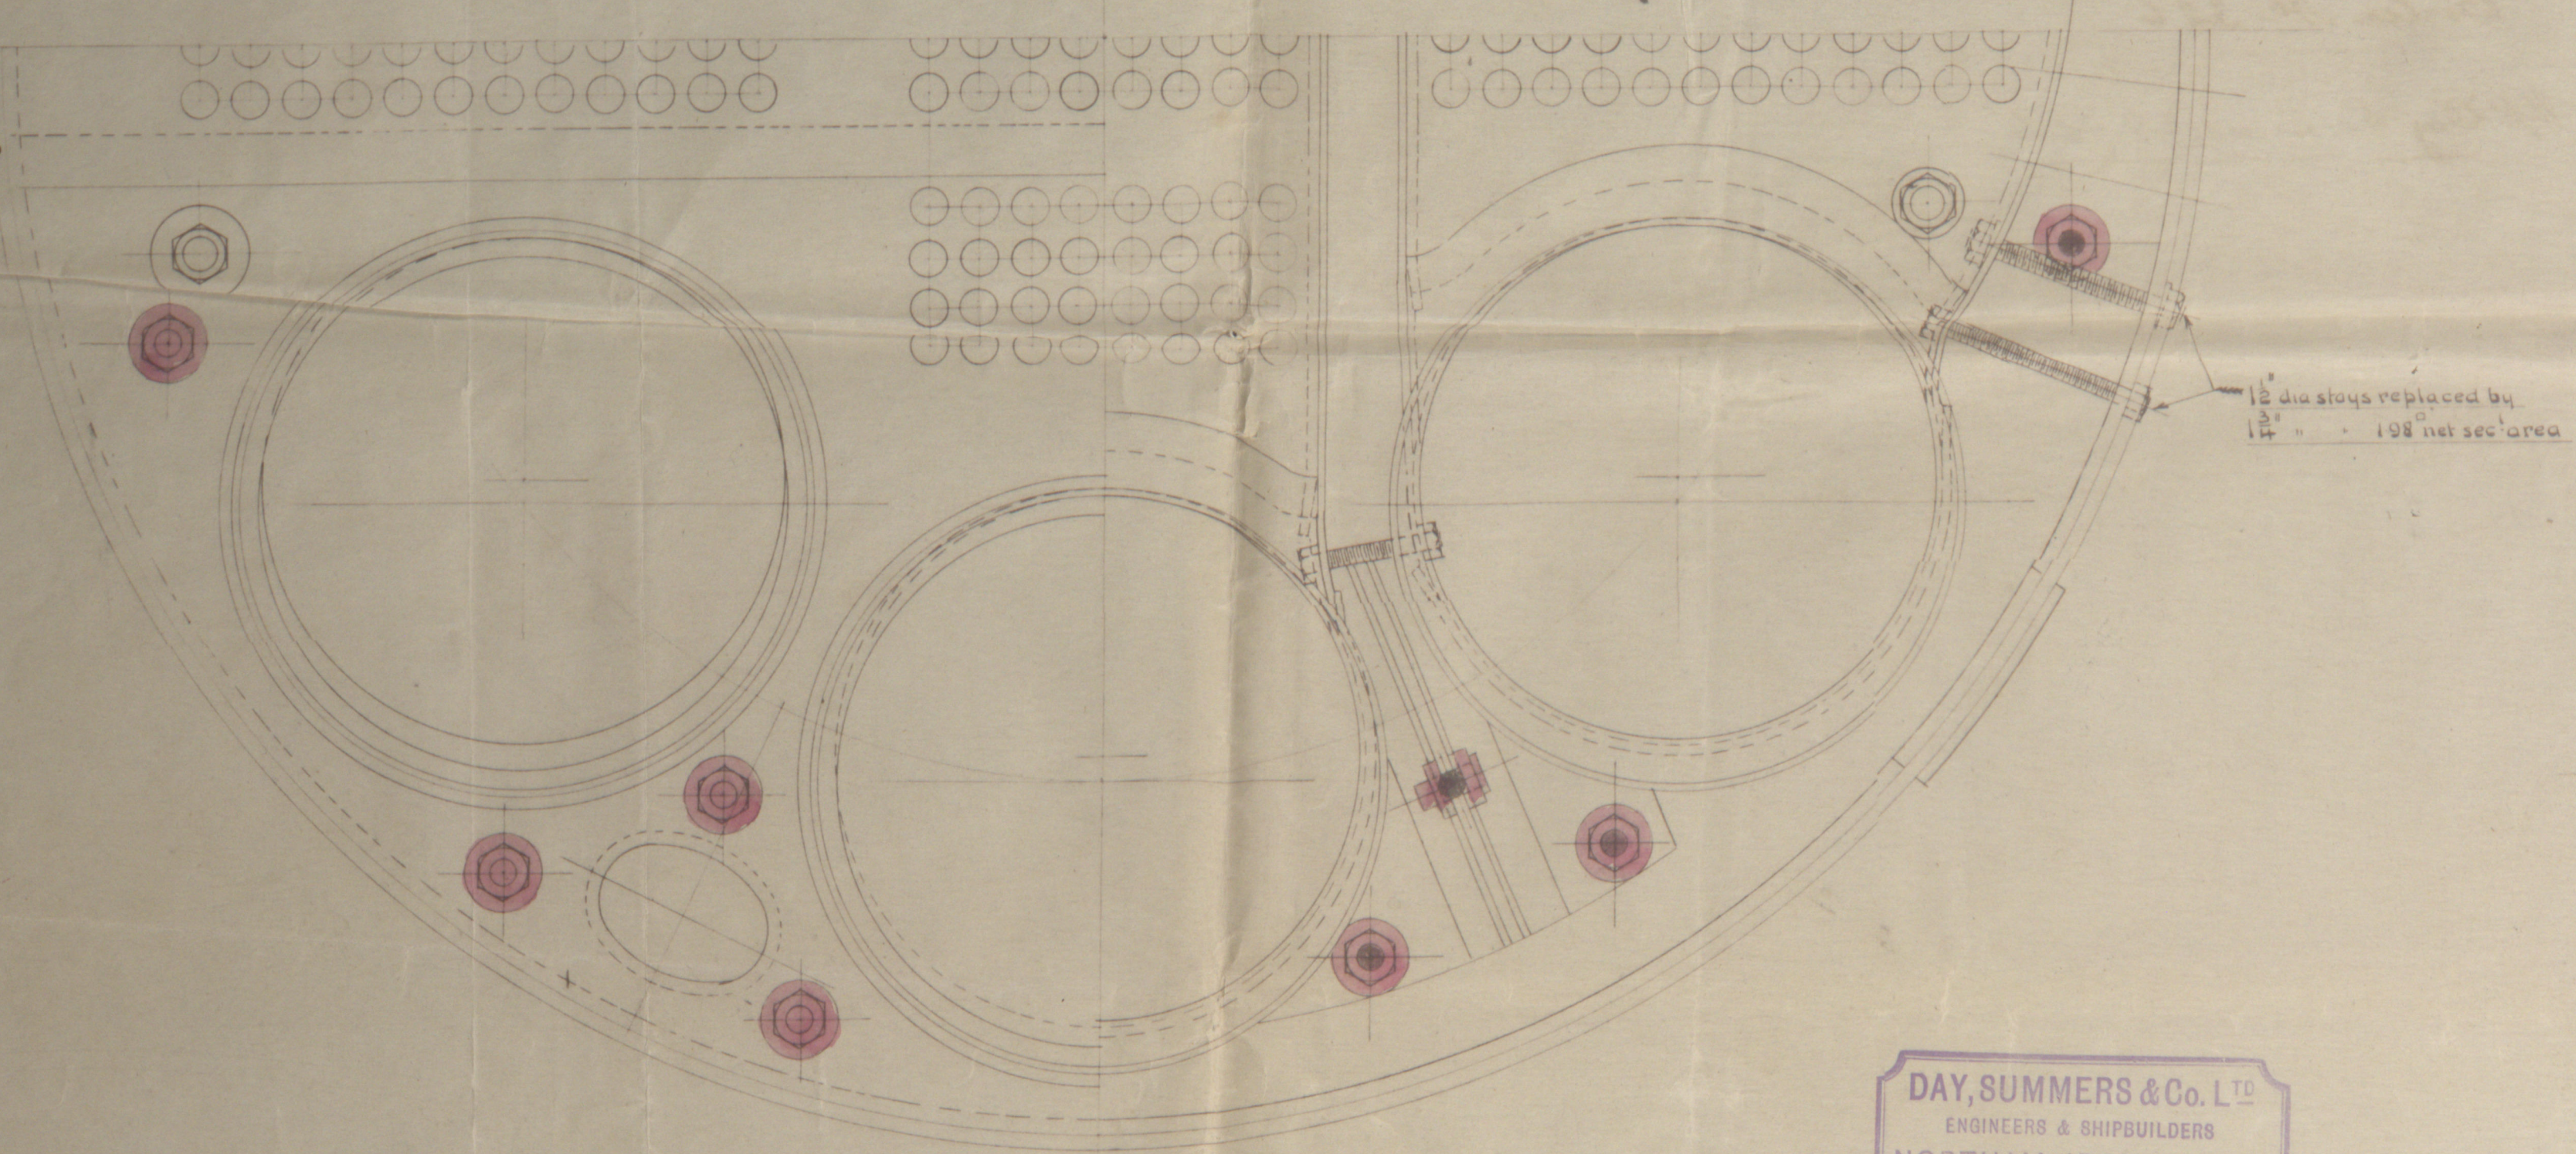


DAY, SUMMERS & Co. LTD  
ENGINEERS & SHIPBUILDERS  
NORTHAM IRON WORKS  
SOUTHAMPTON.  
E. DEPT Tracing No. 1910.....  
Date 11.5.06.....

*[Signature]*  
11.5.06

Fly Attachment to Drawing No 1746

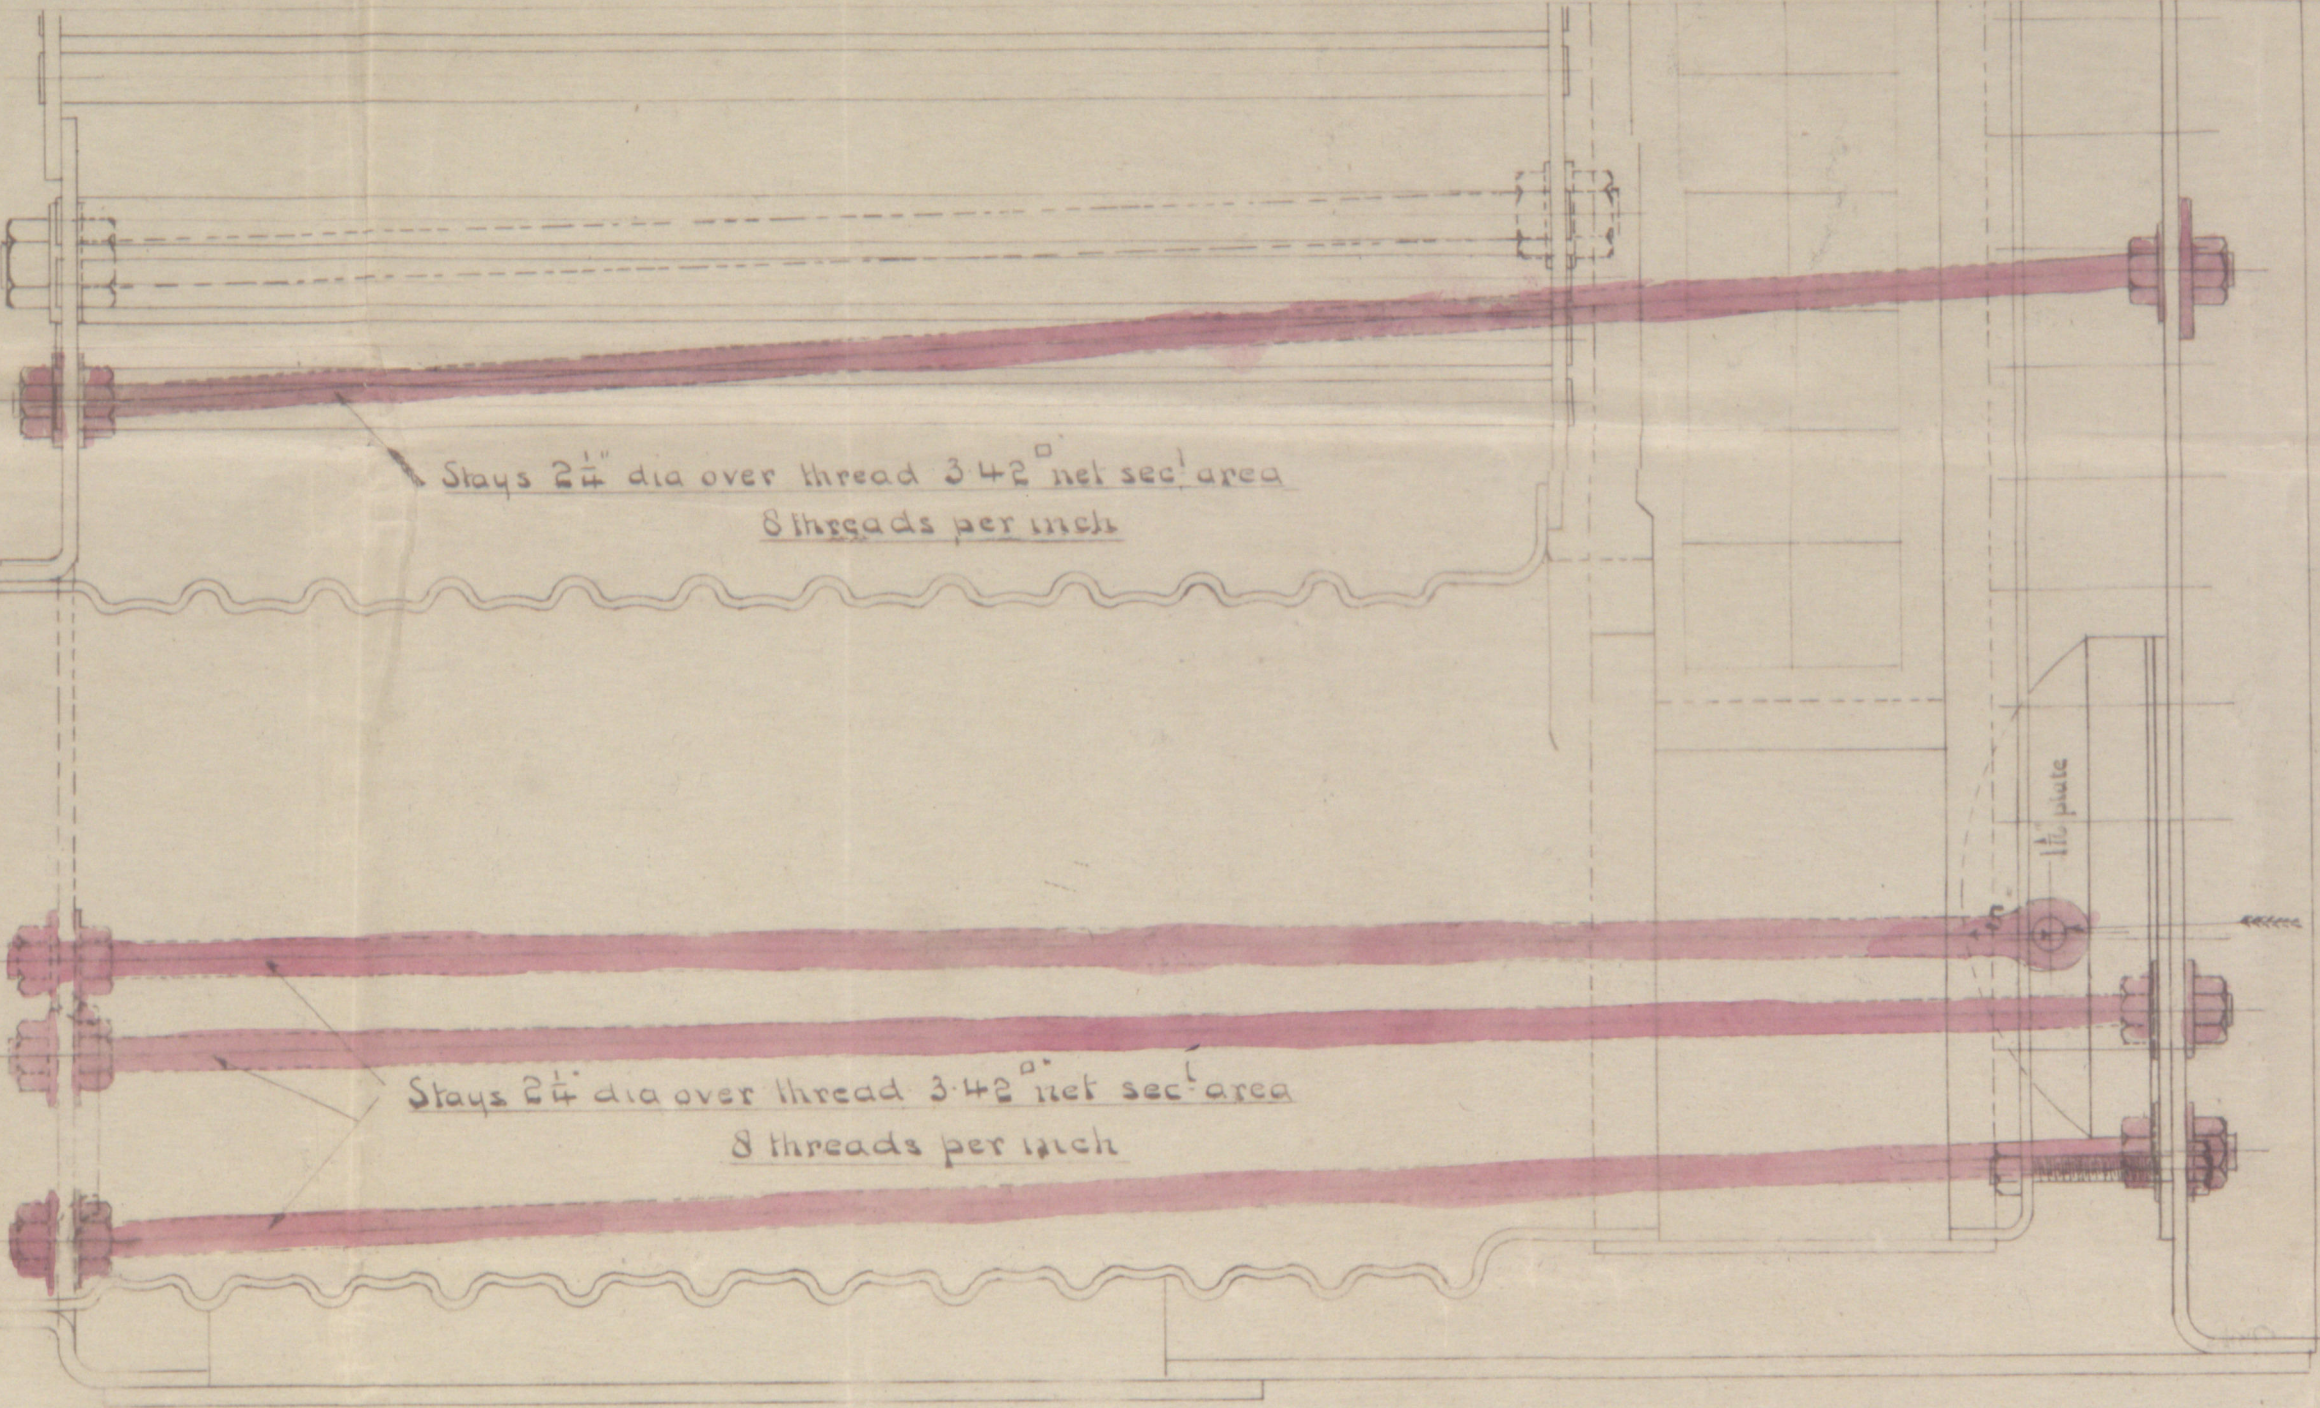

Note Additional stays are shown tinted red

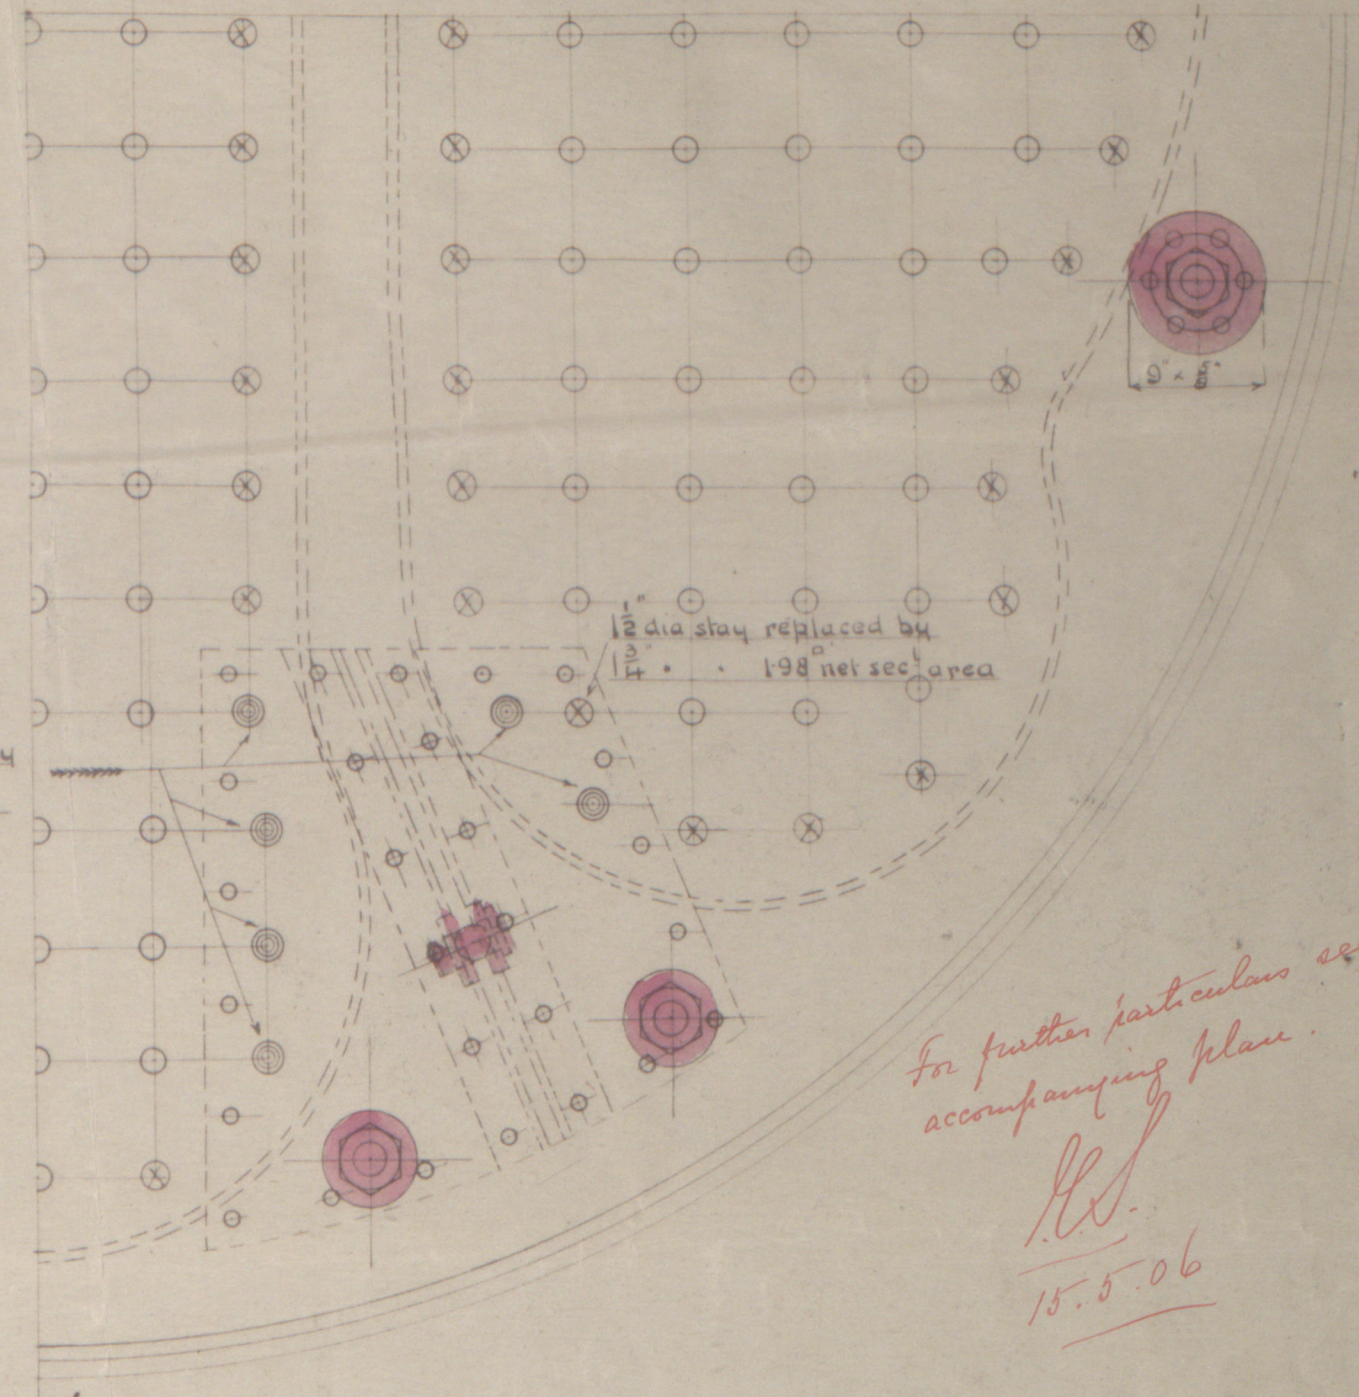

For further particulars see accompanying plans.  
*[Signature]*  
15.5.06

S/S No 136

Boiler No 326 Working Pressure 200 lbs per sq in

Alteration to Staying  
Scale 1 inch = 1 Foot



W315-0018

Amended Staging  
S/3 136

Briller No. 326.

Wm. D. Summers & Co. L.



© 2019

Lloyd's Register  
Foundation