


20-10-05
1.1.06
3-8-06

 

S.Y. No 136.
STEEL ARRANGEMENT.
SCALE: 1/4" = ONE FOOT.


DAY, SUMMERS & Co. LTD
ENGINEERS & SHIPBUILDERS
NORTHAM IRON WORKS
SOUTHAMPTON
S. D.P. Trading No. 462.0.11
Date 16.11.05

1000



© 2019

Lloyd's Register
Foundation

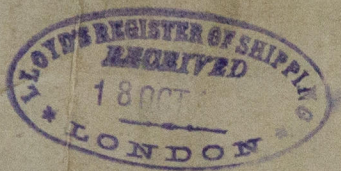

136



136

Ch. at Am. lines 15
M. 17



© 2019

Lloyd's Register
Foundation

Profile

S.V. Medusa

Lon 6308.

Day, Summers No 136

St. 7867

183 x 26 x 16⁶

78 79

84



© 2019

Lloyd's Register
Foundation

W351-0021