

NUMERALS	TO FORM ^D DEPTH	TO AFT DEPTH
1/2 BEAM	10-25	10-25
DEPTH	11-01	11-51
1/2 GIRTH	21-04	18-54
2 DILGE DIAG ¹	29-40	25-55
1 st N ^o	74-70	65-85
LENGTH	121-37	121-37
L	9066	7992
100+3	1166	1355
2 nd N ^o	10871	10829

STEEL TWIN SCREW MOTOR YACHT N^o 511.

To CLASS 100A.I. LLOYDS YACHT RULES

SCALE 1/2" = 1 FOOT

DIMENSIONS 119'3 3/8" B.P. x 20'6" M.L.D. x 13'7" M.L.D. TOP OF KEEL.

PROPORTIONS

DEPTHS 121.37 ÷ 114.01 = 8.66

EQUIPMENT N^o 9066

9066 23.5 x 7.33 23.5 x 7.33 DIRECTIONS

9474 AS PER LETTER Q NEW WOOD YACHT RULES (AS APPROVED BY LLOYDS)

EQUIPMENT (APPROVED BY OWNERS PER LETTER 23/11/25)

POWER ANCHOR 1 @ 3 3/4 CWTs EX STOCK

STREAM 1 @ 13/8 "

NO KEDGE ANCHOR

CHAIN CABLES 120 FT 1 1/2" STUD LINK 3 1/4 9/16 CWTs

STREAM CHAIN 15 " 6 HEMP OR 2" STEEL WIRE

TOWLINE 75 " 4 "


ALEXANDER STEPHEN & SONS
SHIPBUILDERS & ENGINEERS

GLASGOW

PLAN N^o 5 DATE 20-10-25

SHIPYARD DEPARTMENT

FORM^D DECKHOUSE SIMILAR
TO AFTER DECKHOUSE

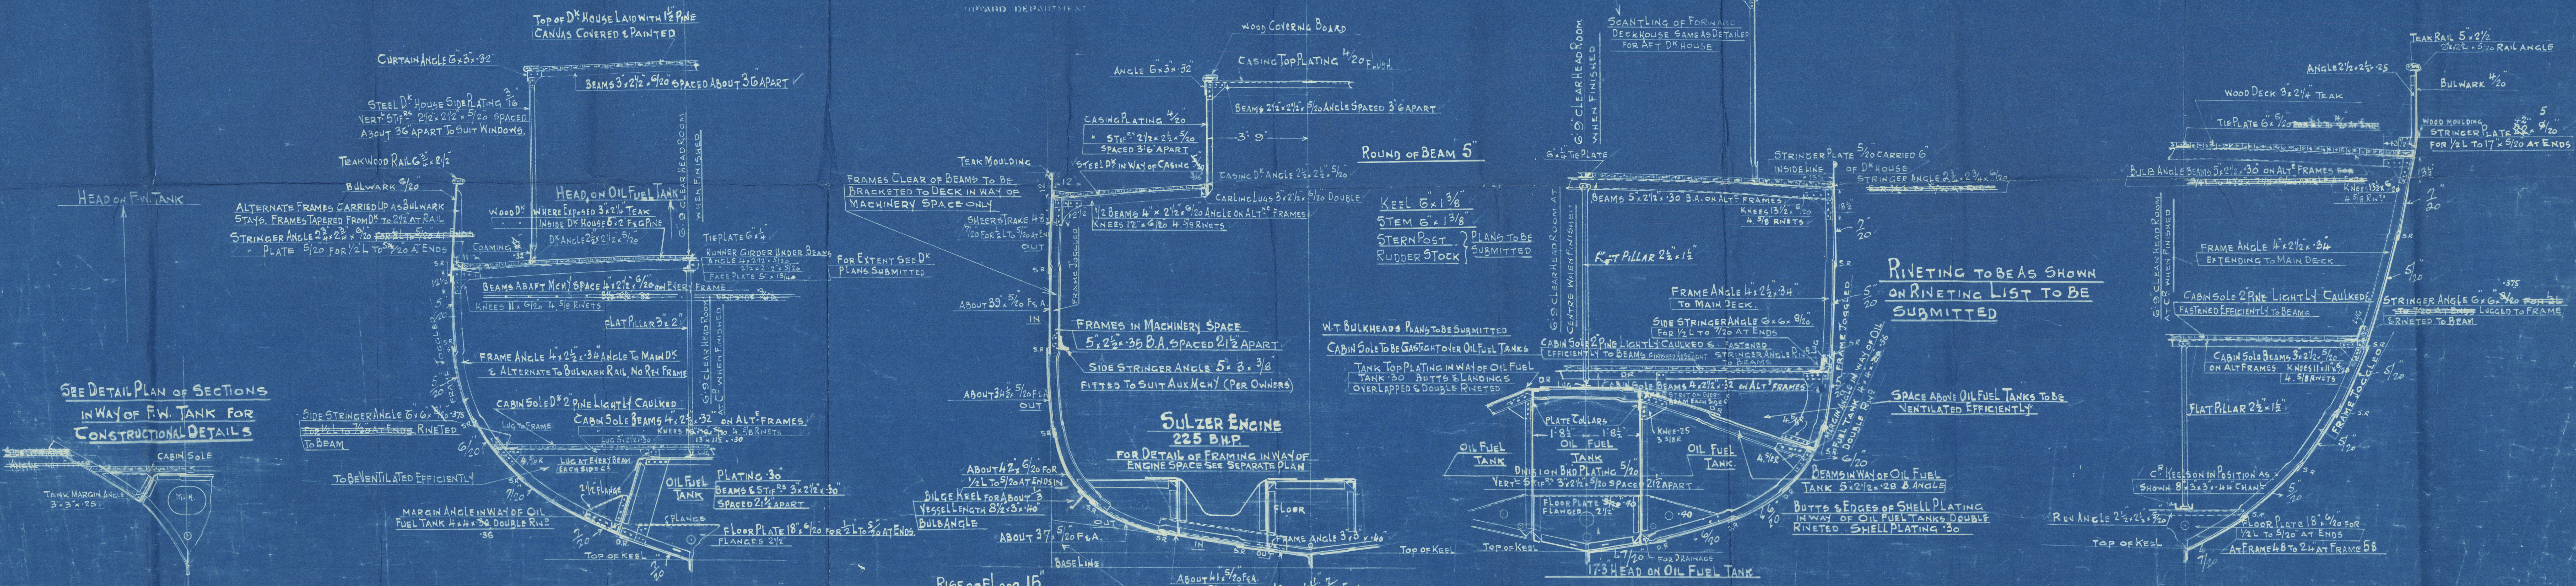

SECTION IN WAY OF AFT TANK
FRAMES N^{os} 8 to 13.

SECTION AT FRAME N^o 17.

SECTION AT 6'-6" AFT OF MIDSHIP
FRAME IN WAY OF MACHINERY
FRAME N^o 30.

SECTION AT FRAME N^o 39.

SECTION AT FRAME N^o 52

W315 0062



T.S.Y. MINGARY

Stephens 511

Midship Section as
Built

Atlantis Rpt. No
4771

Ex

Mingary

GLASGOW REPORT No. 45771



© 2019

Lloyd's Register

W315-0062 Foundation