

13/11/25

NUMERALS	TO FORM ^D DRAFT	TO AFT DRAFT
1/2 BEAM	10.0	10.0
DEPTH	14.0	11.5
1/2 GIRTH	21.0	13.5
2 BILGE DIA ⁴	30.16	26.0
LENGTH	75.16	66.0
L	110.2	118.5
L	8959.0	7820
TOD 13	1.15	1.33
2 ND NO	10302	10400

STEEL TWIN SCREW MOTOR YACHT NO 511

TO CLASS 100A.1 LLOYDS YACHT RULES

SCALE 1/2" = 1 FOOT

DIMENSIONS 119' 3" 30' 6" 116' 6" B.P. x 20' 0" MLD x 13' 7" MLD. (see letter from Builder) 10.11.25

PROPORTIONS

DEPTHS 110.2 ÷ 14.0 = 8.53

EQUIPMENT NO 9300

8960 23.0 x 7.5
340 23.75 x 7.25

8300

EQUIPMENT AS SPEC^N


BOWER ANCHOR 1 @ 5 1/8 CWTs
STREAM " 1 @ 4 3/4 "
KEDGE " 1 @ 1 3/4 "
CHAIN CABLES 15 OF 1 1/2" STUD LINK = 58 CWT 24 85
STREAM CHAIN 4 " 3/16 CHAIN OR 2" STEEL WIRE
TOW LINE " 5/8" MANILLA
WARP " 4 "

may be as for letter of 1000 Work Yacht Rules
4 5/8 inch stainless
3 3/4 "
3/4" on stock
no kedge anchor
120 fathoms 12/16 twisted line 34 9/16 cwt.
70 fathoms 6 " 2" steel wire
15 " 4 "

ALEXANDER STEPHEN & SONS
SHIPBUILDERS & ENGINEERS

GLASGOW

PLAN NO 5 DATE 29.10.25
SHIPYARD DEPARTMENT 24.10.25

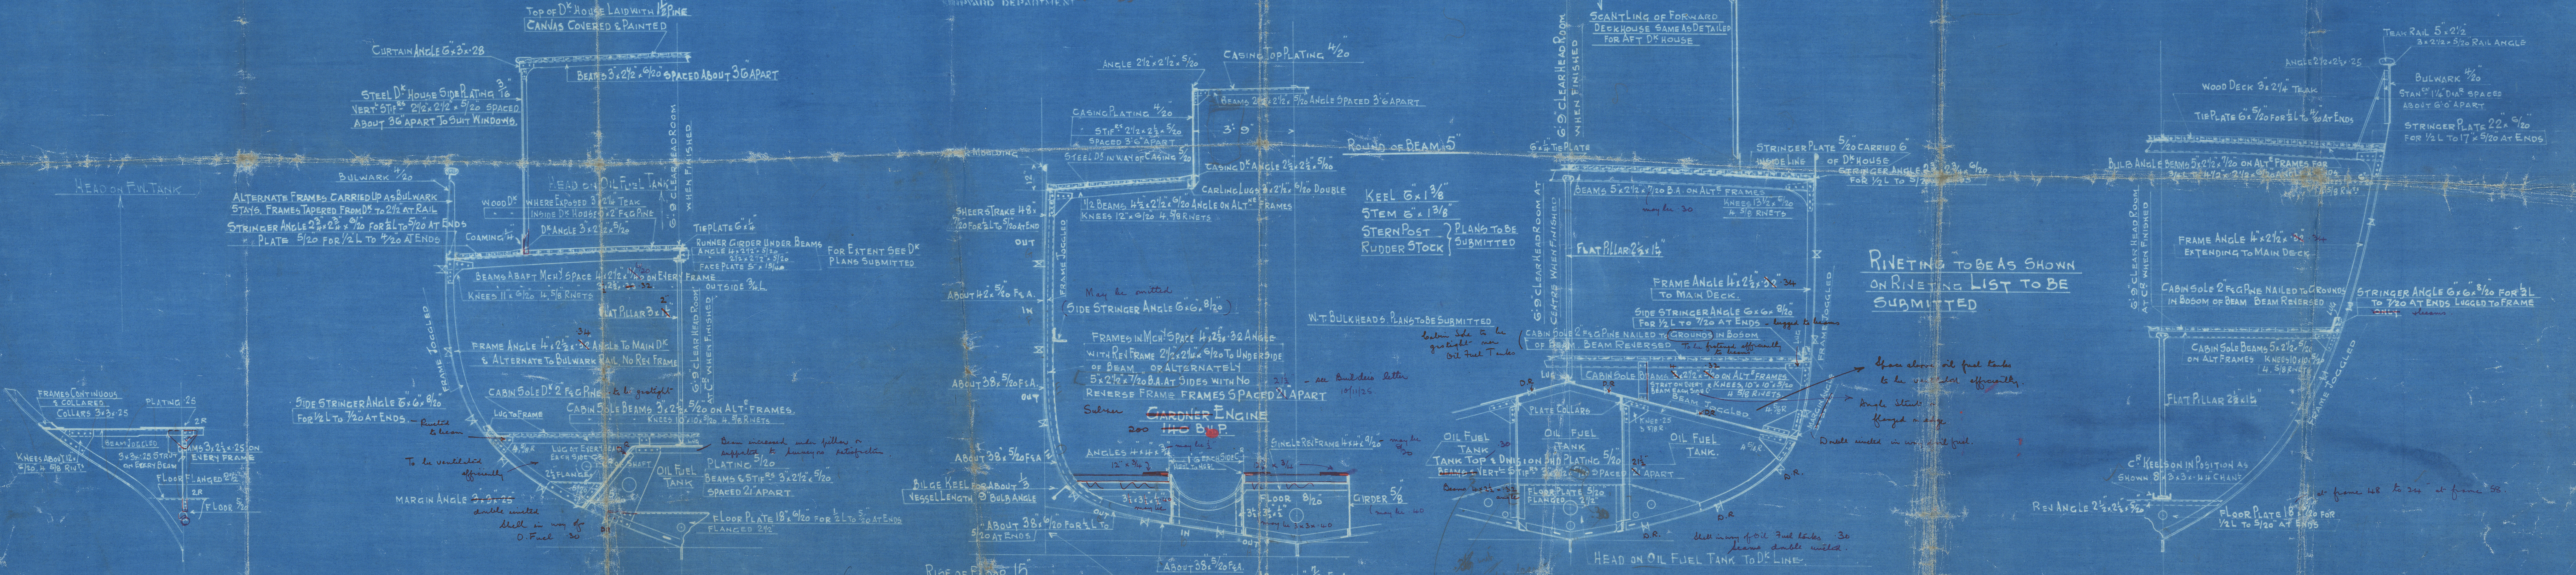

SECTION IN WAY OF AFT TANK
FRAMES NO 7 TO 13.

SECTION AT FRAME NO 17.

SECTION AT 6' 6" AFT OF MIDSHIP
FRAME IN WAY OF MACHINERY

SECTION AT FRAME NO 39.

SECTION AT FRAME NO 52

O'Stephens 511ms


511

Midship Section
and Section

ATLANTIS.
EX

Mingary
GLASGOW REPORT No. 45771

Mid Dec

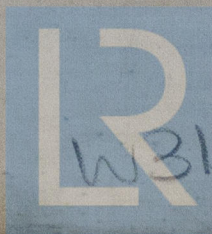

© 2019

W315 Lloyd's Register
Foundation