

L. Gardner + Sons

Adv. Propelling
Engine for

M. V. Maid Marion

Thrust Shaft.
(Amended)

W315-0089




© 2019

Lloyd's Register
Foundation

12/6/29

W315-0089

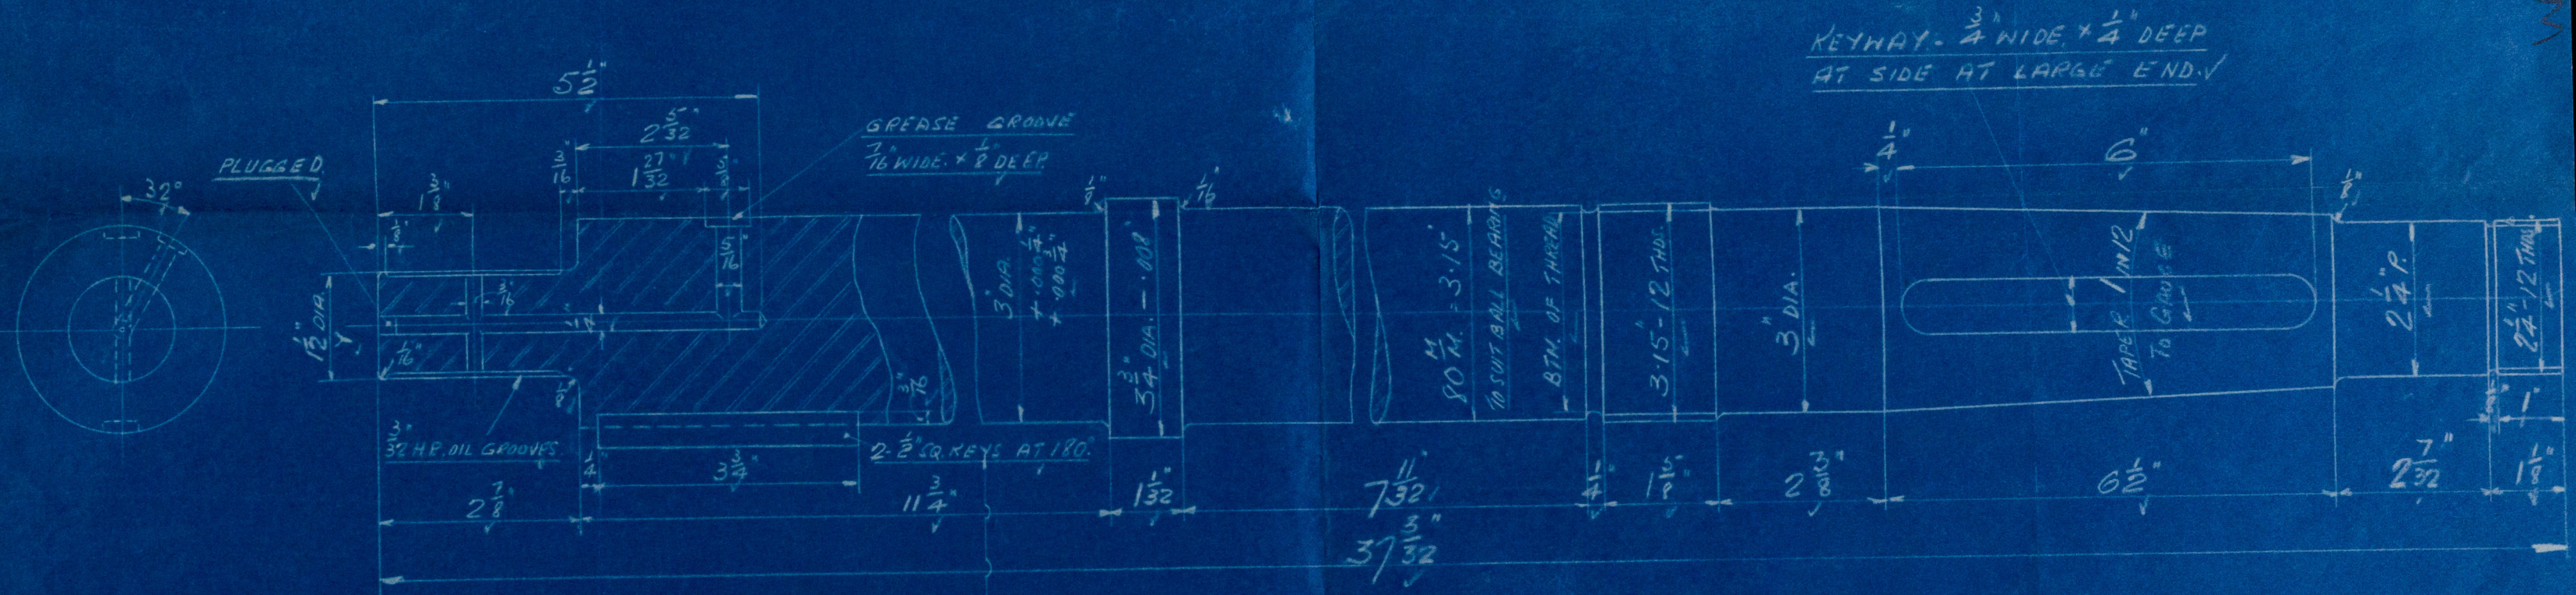

E.1189.

L. BARNER & SONS LTD.
DRAWING
- 5 JUN 1929
- 90-PRICE
PATRICROFT

G.H.M.
12/6/29

ASSEMBLY - 7777

3.5. ENGINE, & N° 5 CLUTCH. 9. R4600
CLUTCH SHAFT. SPECIAL.

HALF SIZE.

MATERIAL -
28/32 TONS. H. M.S.
ALL OVER

4.6.29.



© 2019
DNG N° 313.F
FOR 10540