

L. Gardner & Son

OVC Engine  
for

M.V. Maid Marion


the Compressing  
by Glendee



© 2019

Lloyd's Register  
W315-0091  
Foundation



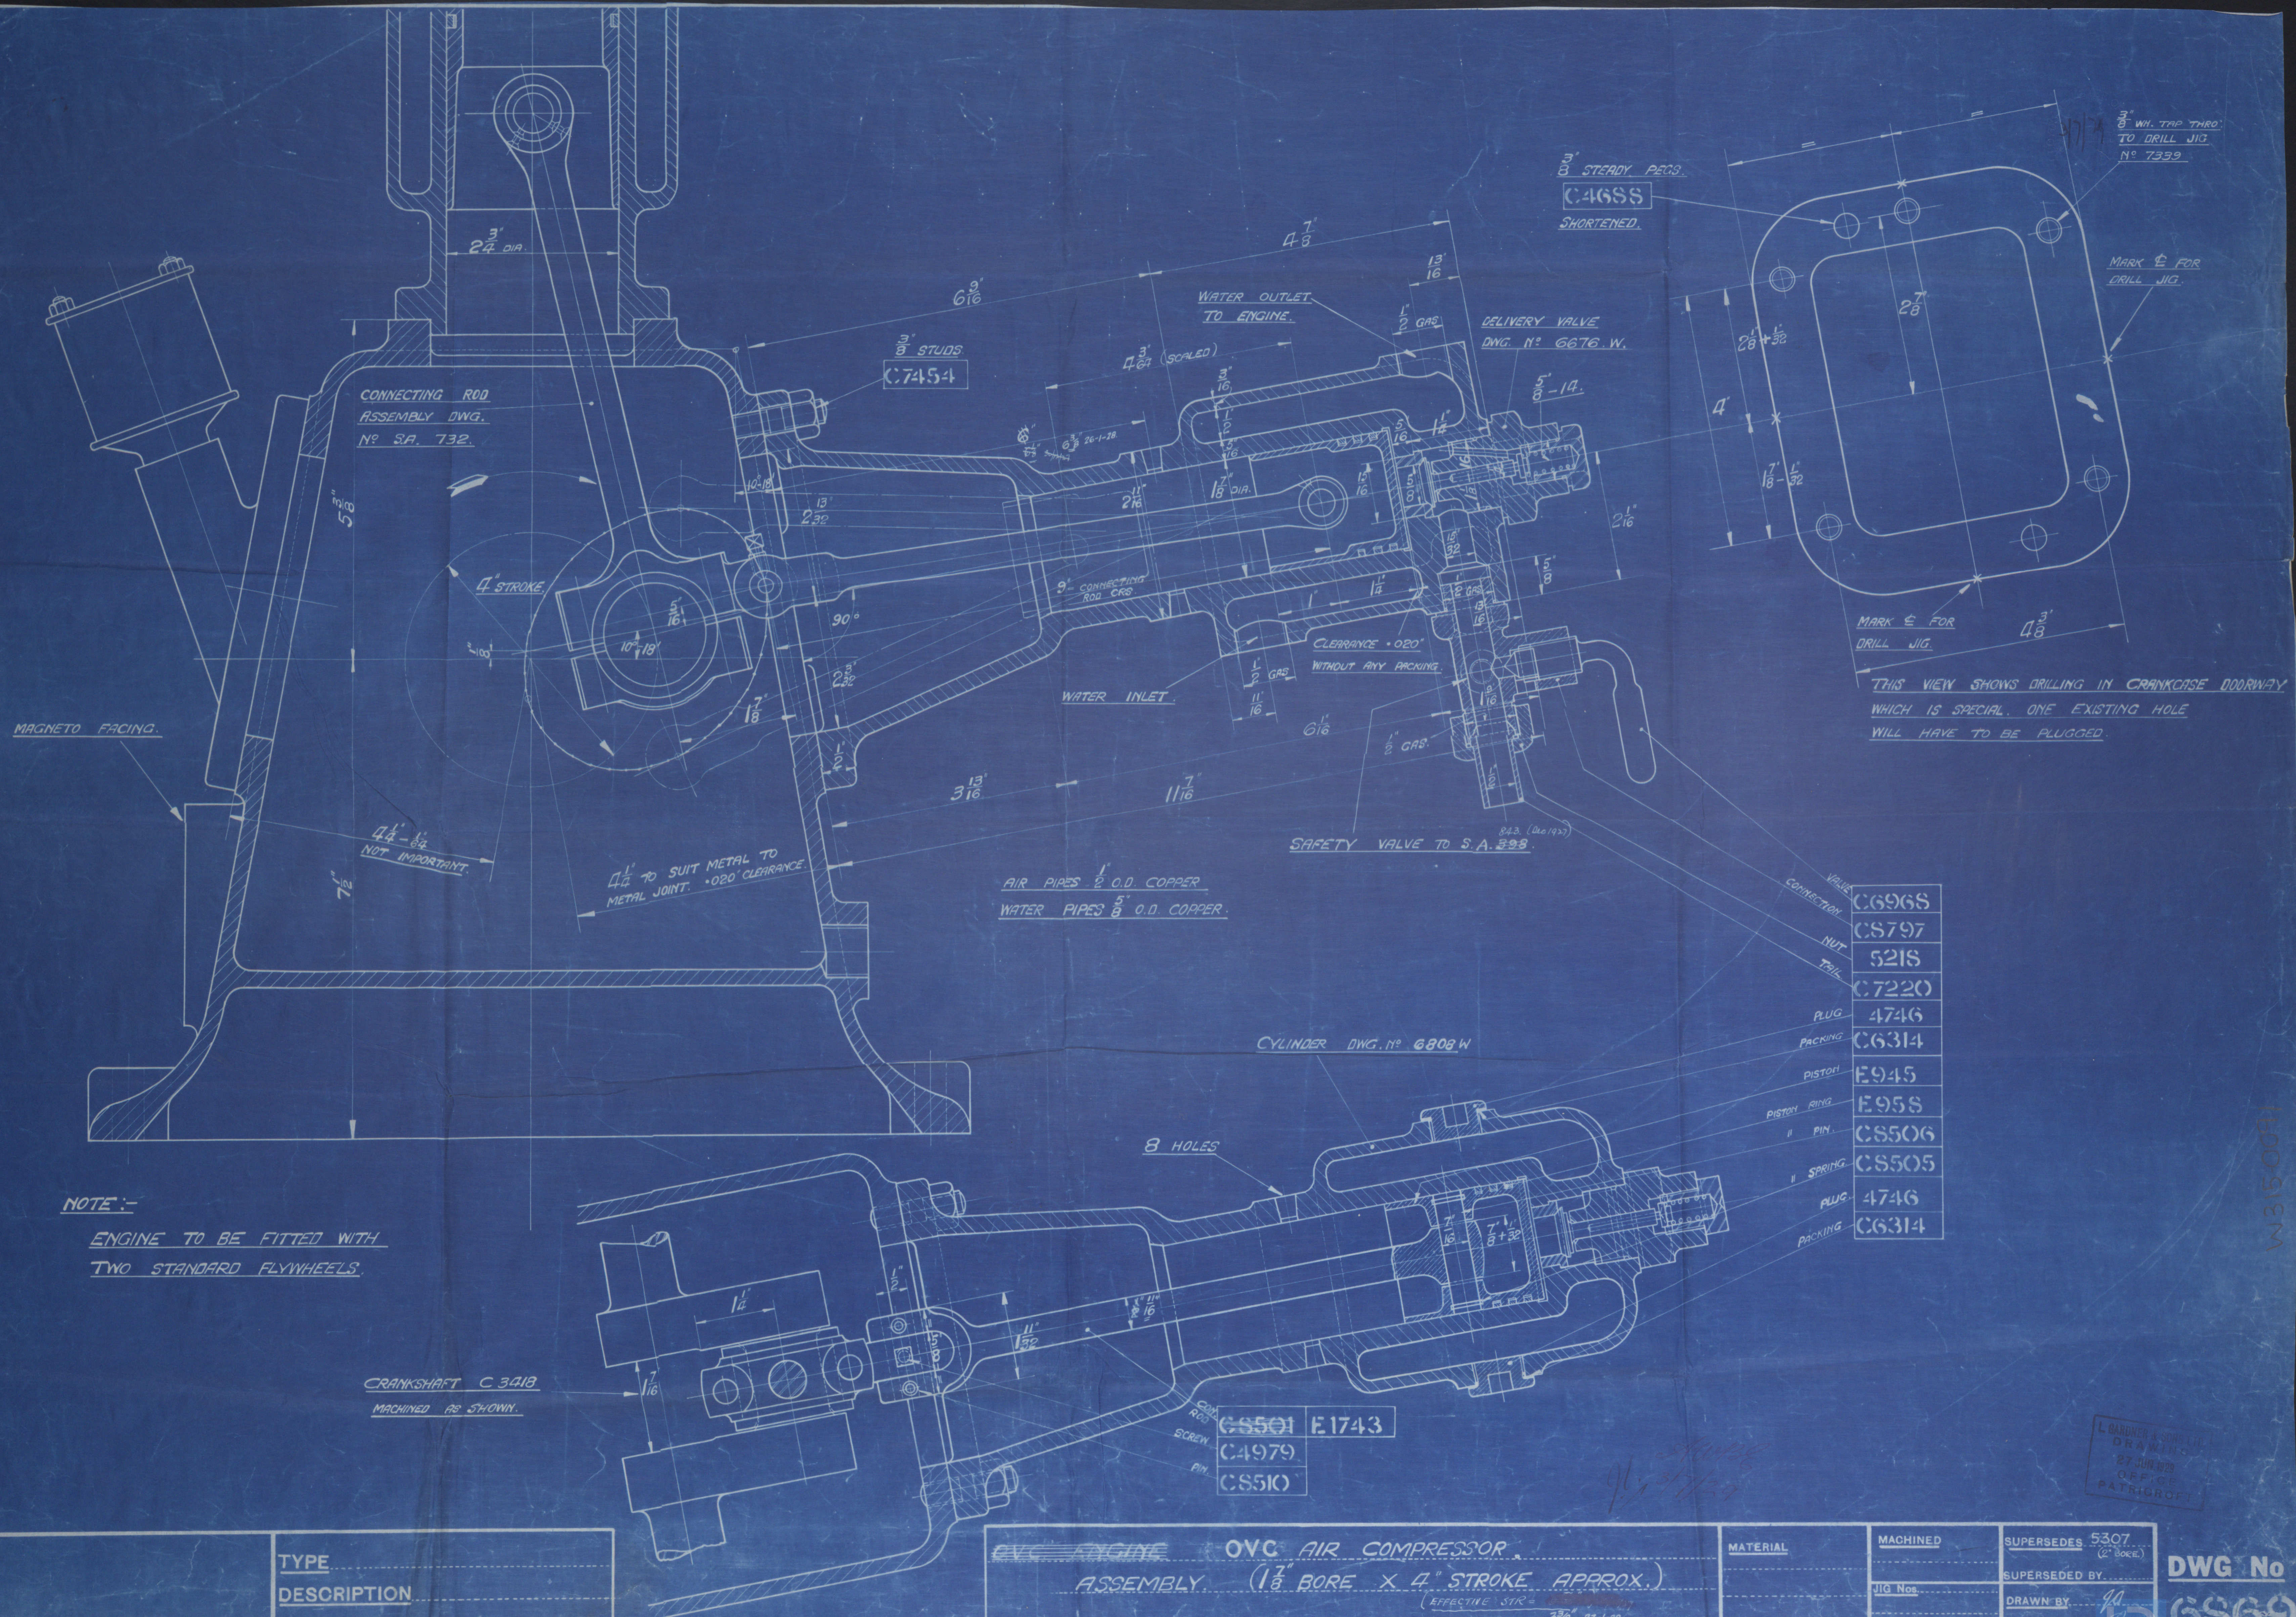

NOTE:-  
ENGINE TO BE FITTED WITH  
TWO STANDARD FLYWHEELS.

CRANKSHAFT C 3418  
MACHINED AS SHOWN.

C8501 E1743  
C4979  
C8510

VALVE	C6968
CONNECTION	C8797
NUT	5218
TAIL	C7220
PLUG	4746
PACKING	C6314
PISTON	E945
PISTON RING	E958
II PIN	C8506
I SPRING	C8505
PLUG	4746
PACKING	C6314

DWG No <b>6869</b>	L. GARDNER & SONS, LTD. PATRICROFT.	TYPE	OVC AIR COMPRESSOR		MATERIAL	MACHINED	SUPERSEDES 5307 (2" BORE.)	DWG No <b>6869</b>
		DESCRIPTION	ASSEMBLY. (1 7/8" BORE X 4" STROKE APPROX.) (EFFECTIVE STR = 3 3/8" 27-1-28)		DATE 13.7.27.	JIG No.	SUPERSEDED BY	
SCALE		FULL SIZE		DRAWN BY 44		TRACED BY		Foundation
				CHECKED BY				