

30.5. 95.  
23. 8. 95

SCREW STEAM YACHT N° 141

194" 6 B.P. X 27-6 X 17" 3 M<sup>20</sup>


SCALE  $\frac{1}{2}$ " = 1 FOOT

TO CLASS 100 A.I. LLOYDS STEEL YACHT

## RULES

TONNAGE 708.00 (OLD RULE

"Solitaire"

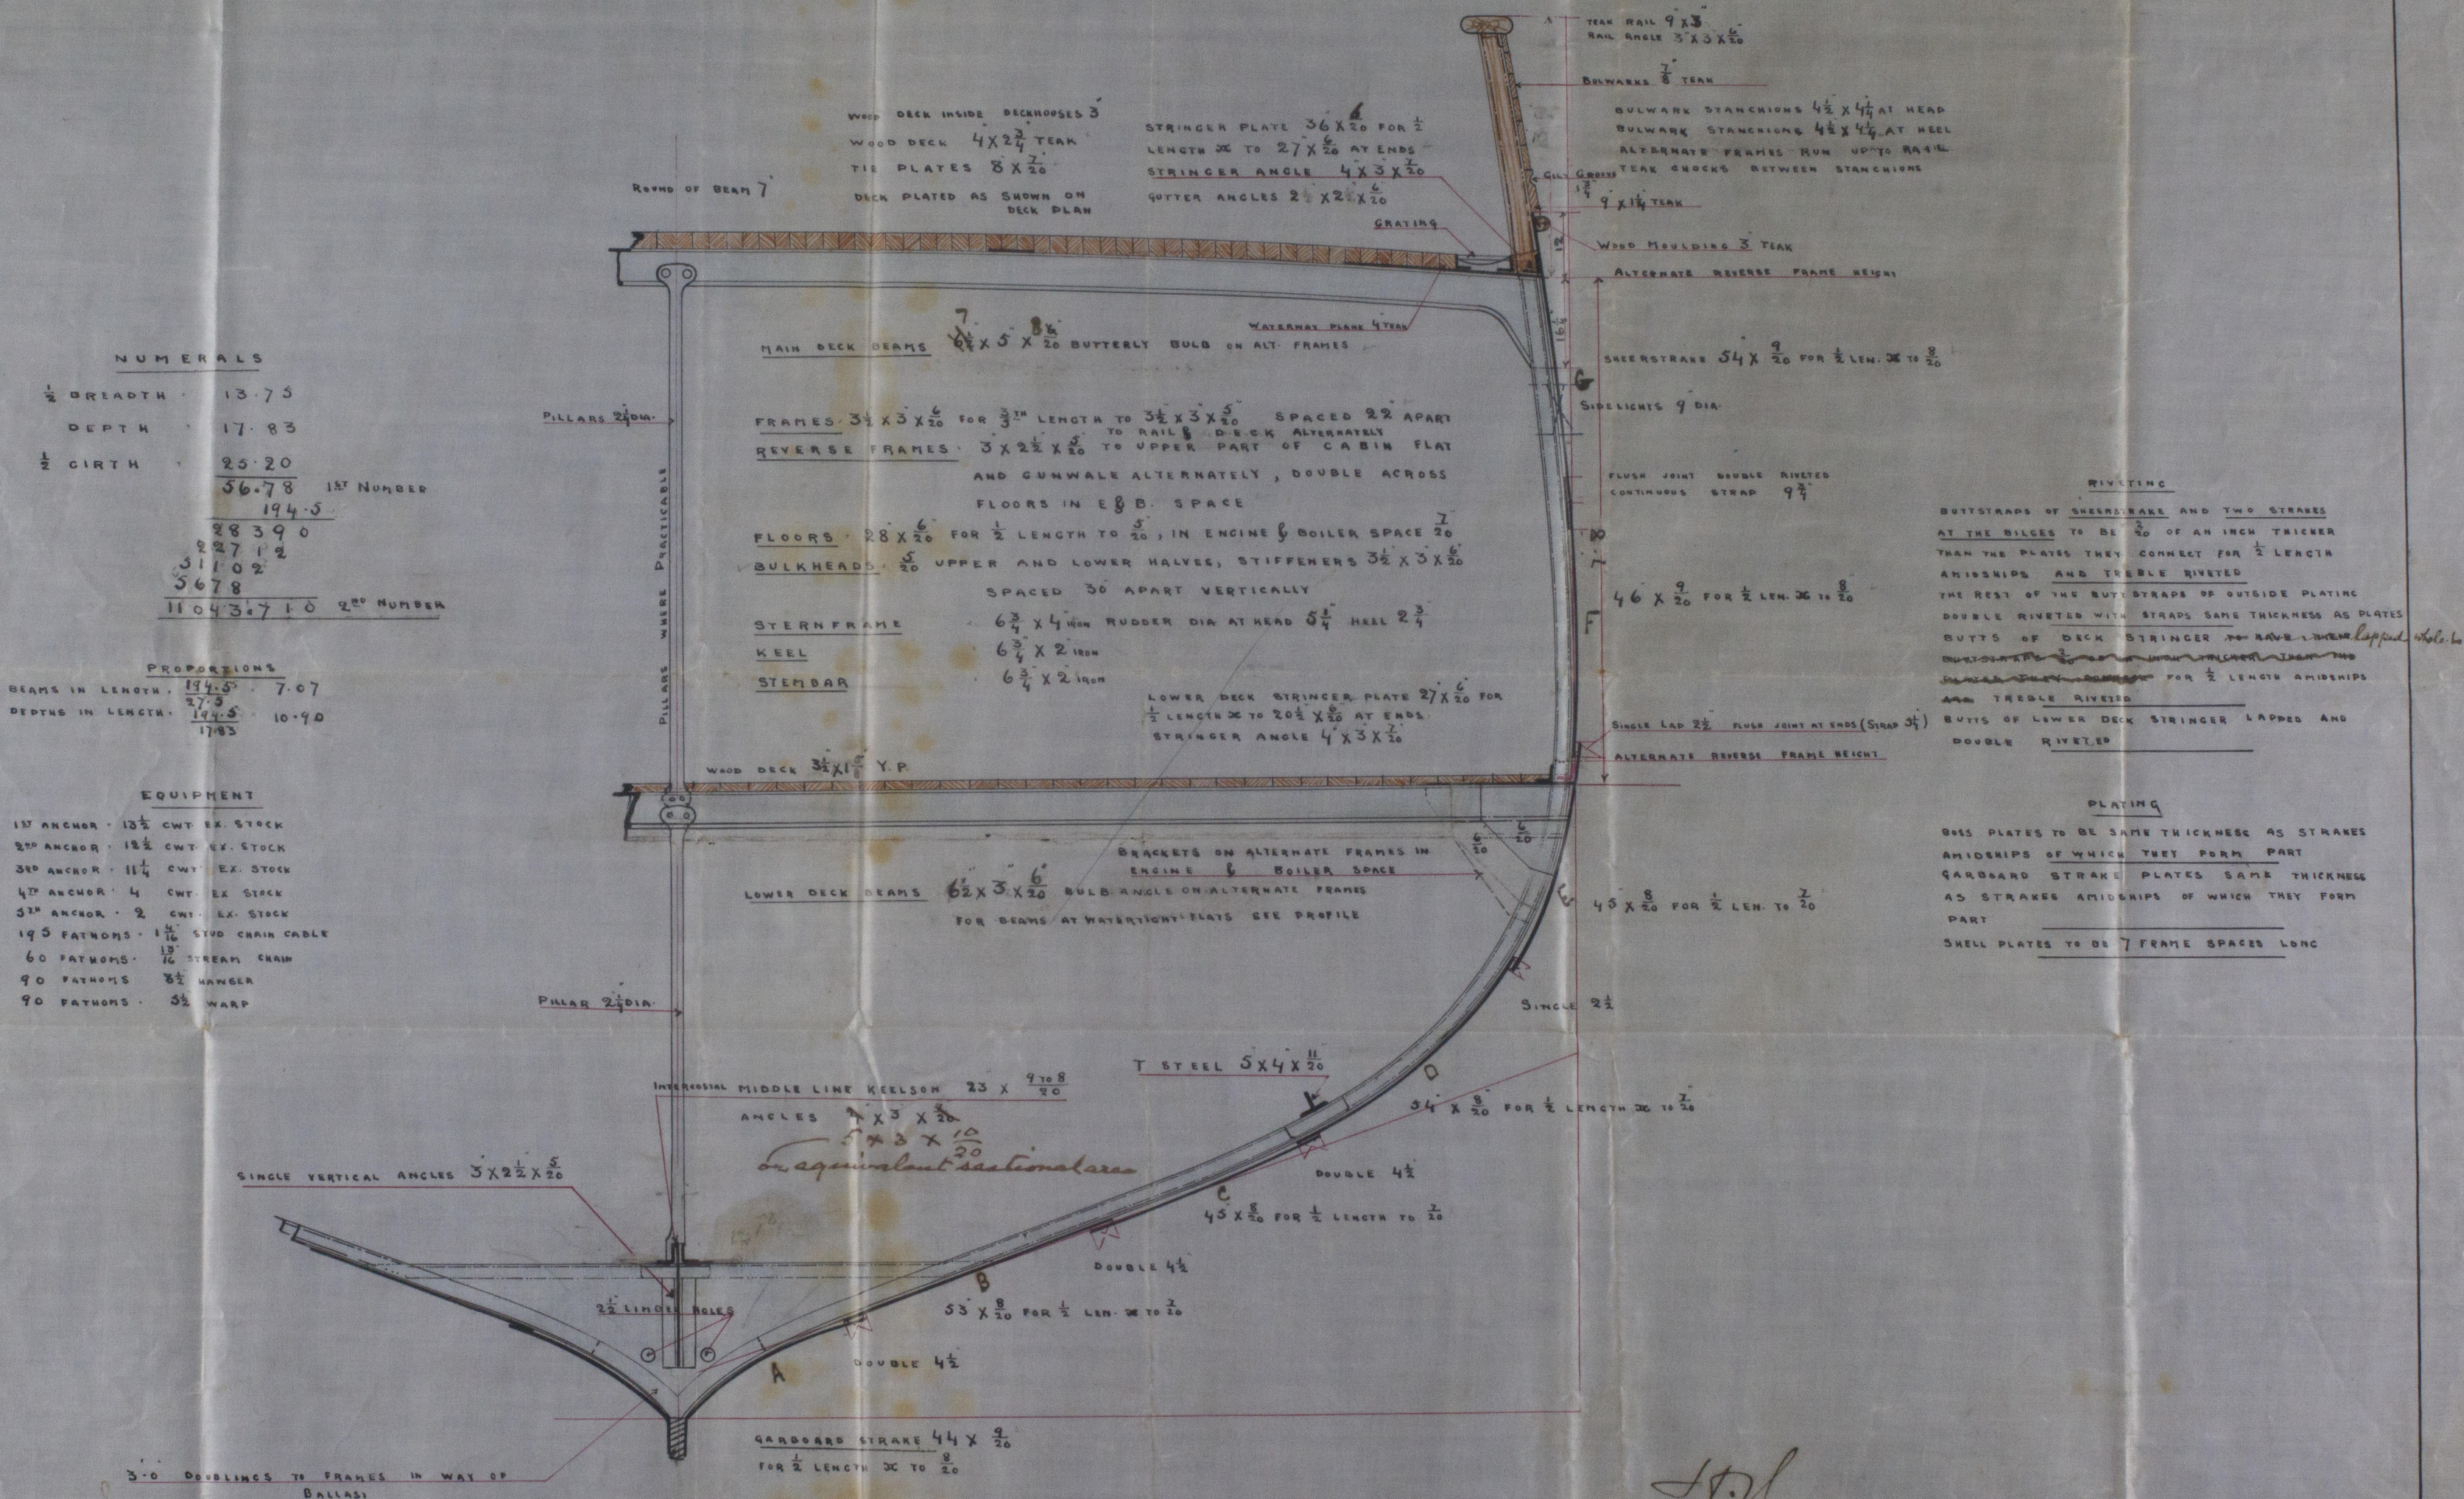


St. J.  
3075/95

27<sup>th</sup> May '95  
H. G.



S. S. yacht "Marion  
Solace"  
Lth. Rept. N: 8093

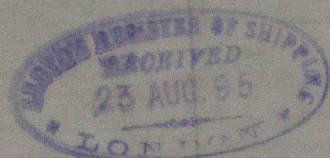

Yto 3022

3022