
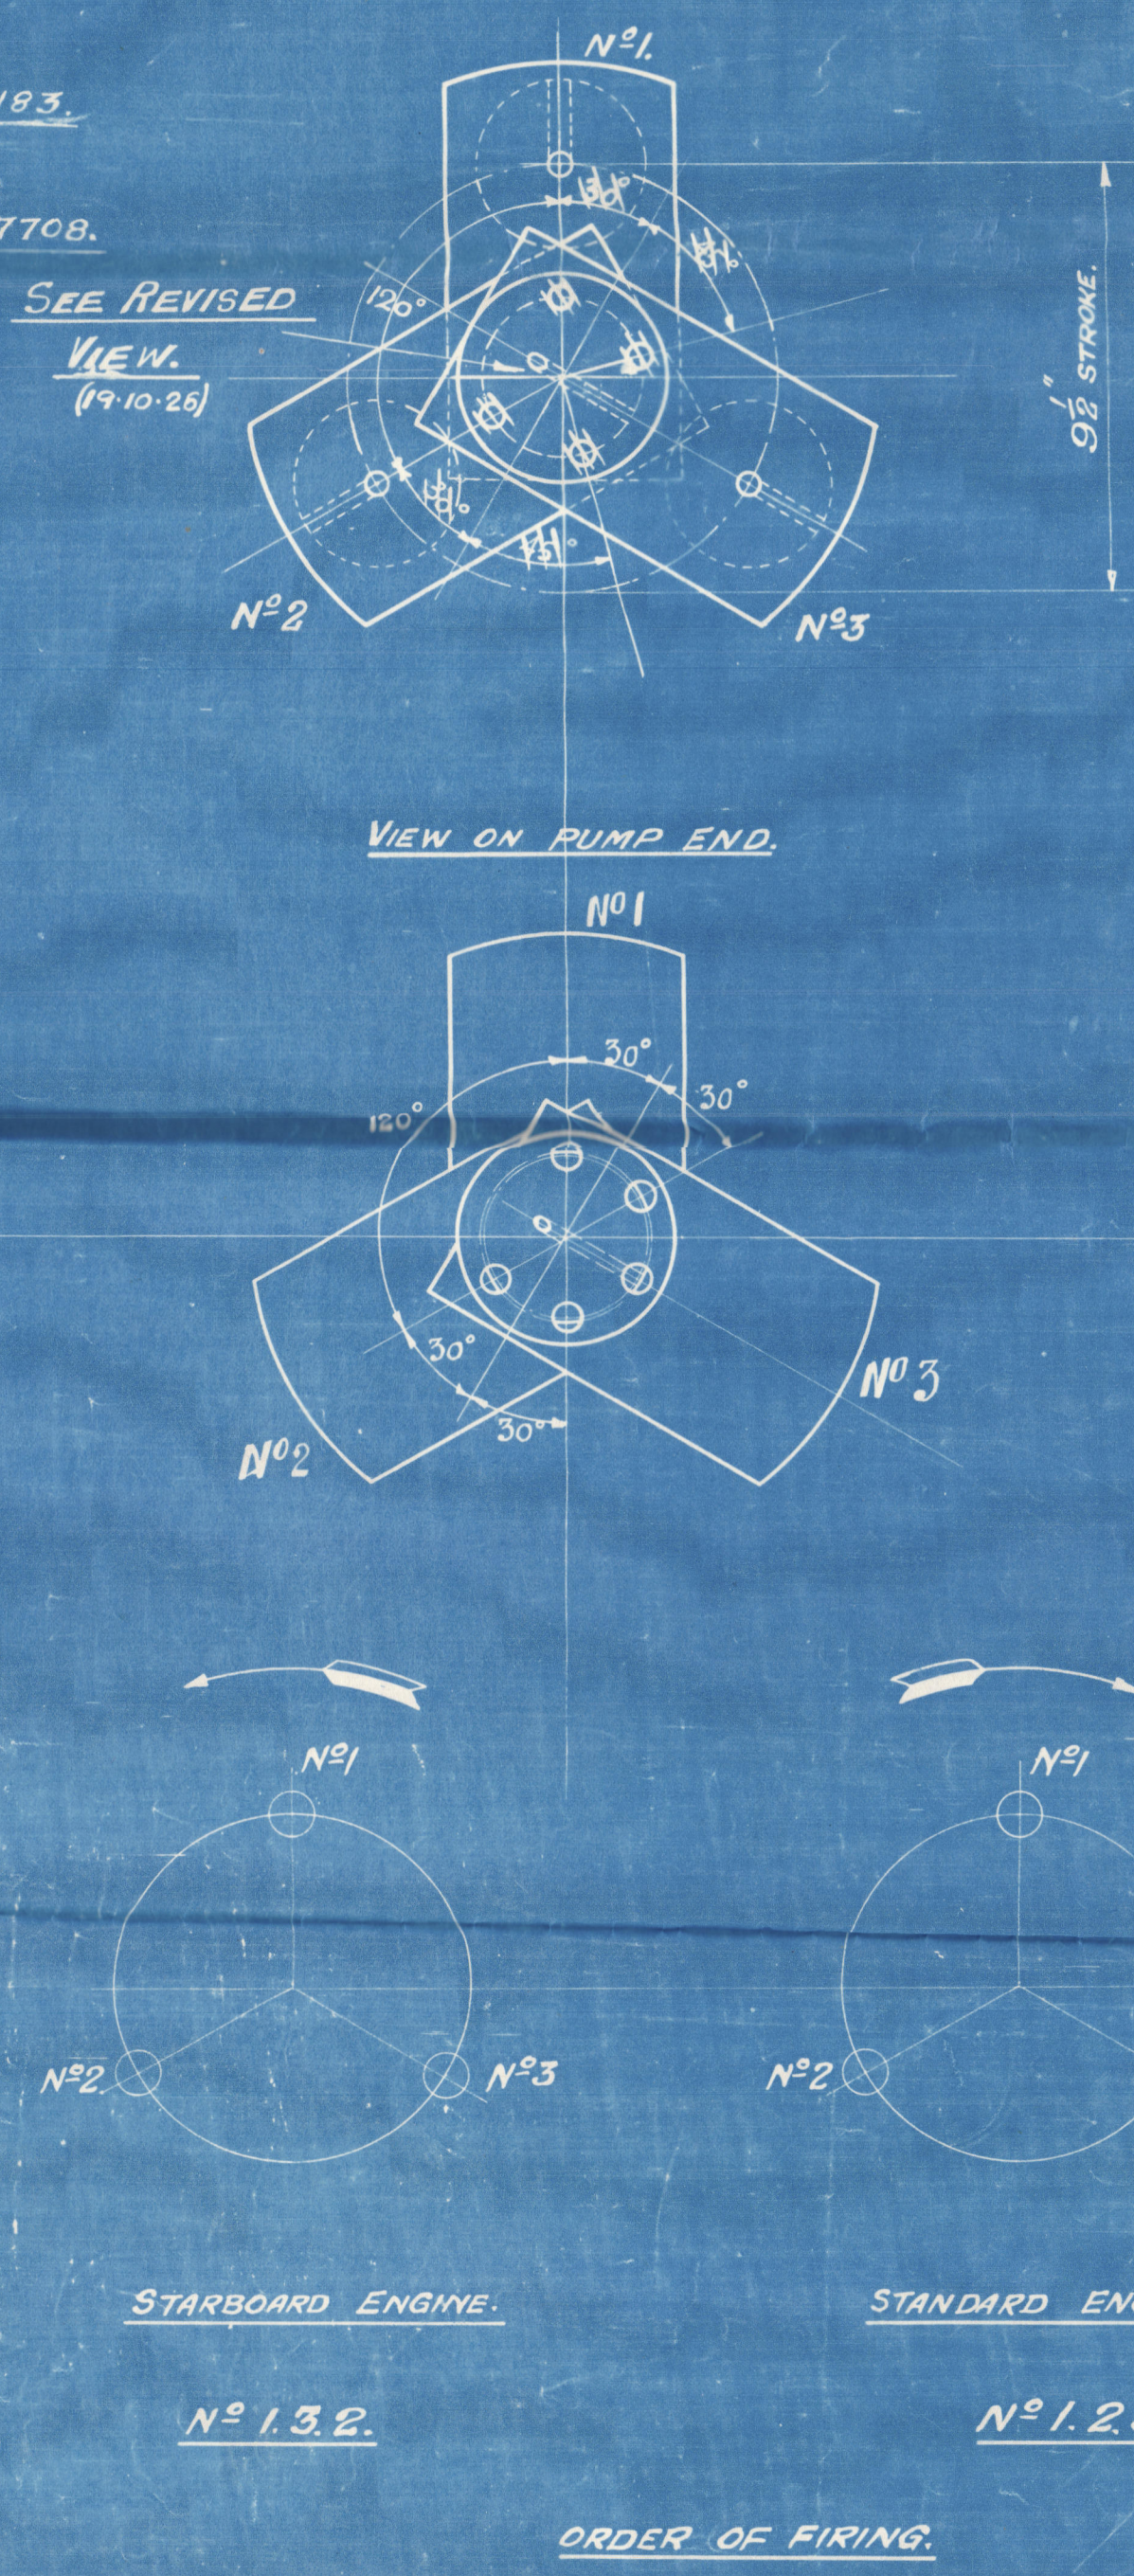


21/7/27

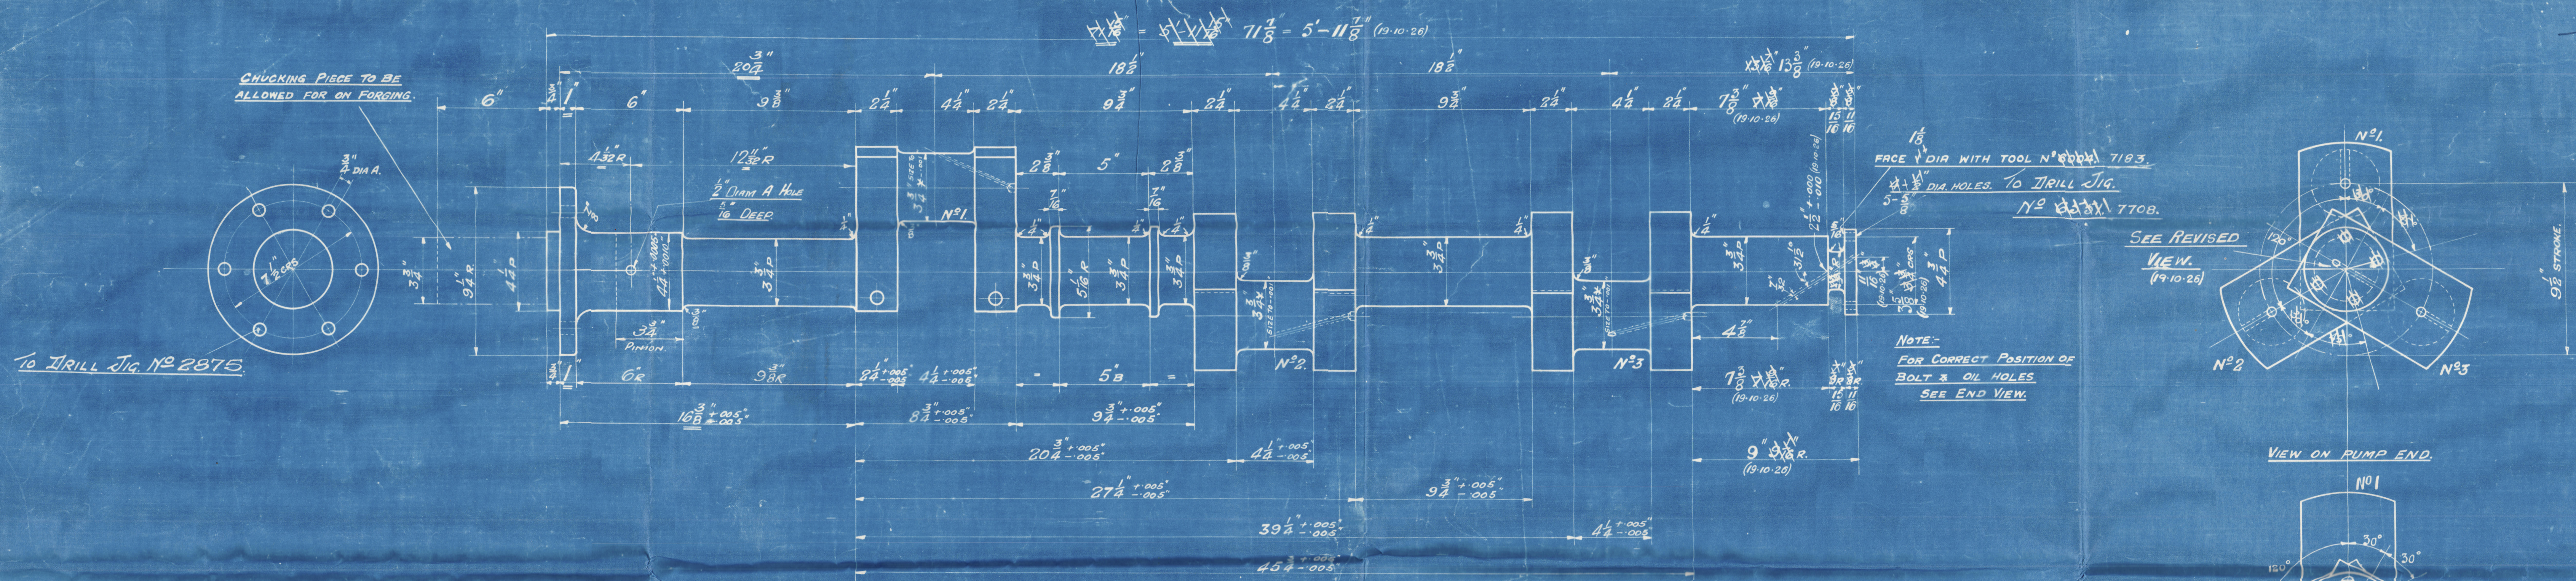

FOR CRANKSHAFT ASSEMBLY SEE DWG N° DWG N° 4059

FOR CRANKSHAFT FORGING SEE DWG N° 4373 B

TYPE 3T5 ENGINE (STANDARD OR STARBOARD)

DESCRIPTION CRANKSHAFT.

SCALE 1/2" = FULL SIZE.

PART N° C 5222	
MATERIAL M.S.	MACHINED
28-32 TONS	310 lbs
DATE APRIL 7 1927	APPROVED BY
	DRAWN BY
	TRACED BY
	CHECKED BY

GARDNER & SONS LTD.  
DRAWING  
12 JUL 1927  
OFFICE  
PATRICROFT  
Lloyd's Register  
Foundation



L. Gardner & Son

375 Engine  
for

Capt. Rumbold's

Lily Maid 11<sup>5</sup>  
Par. 29.

Cranehaft