
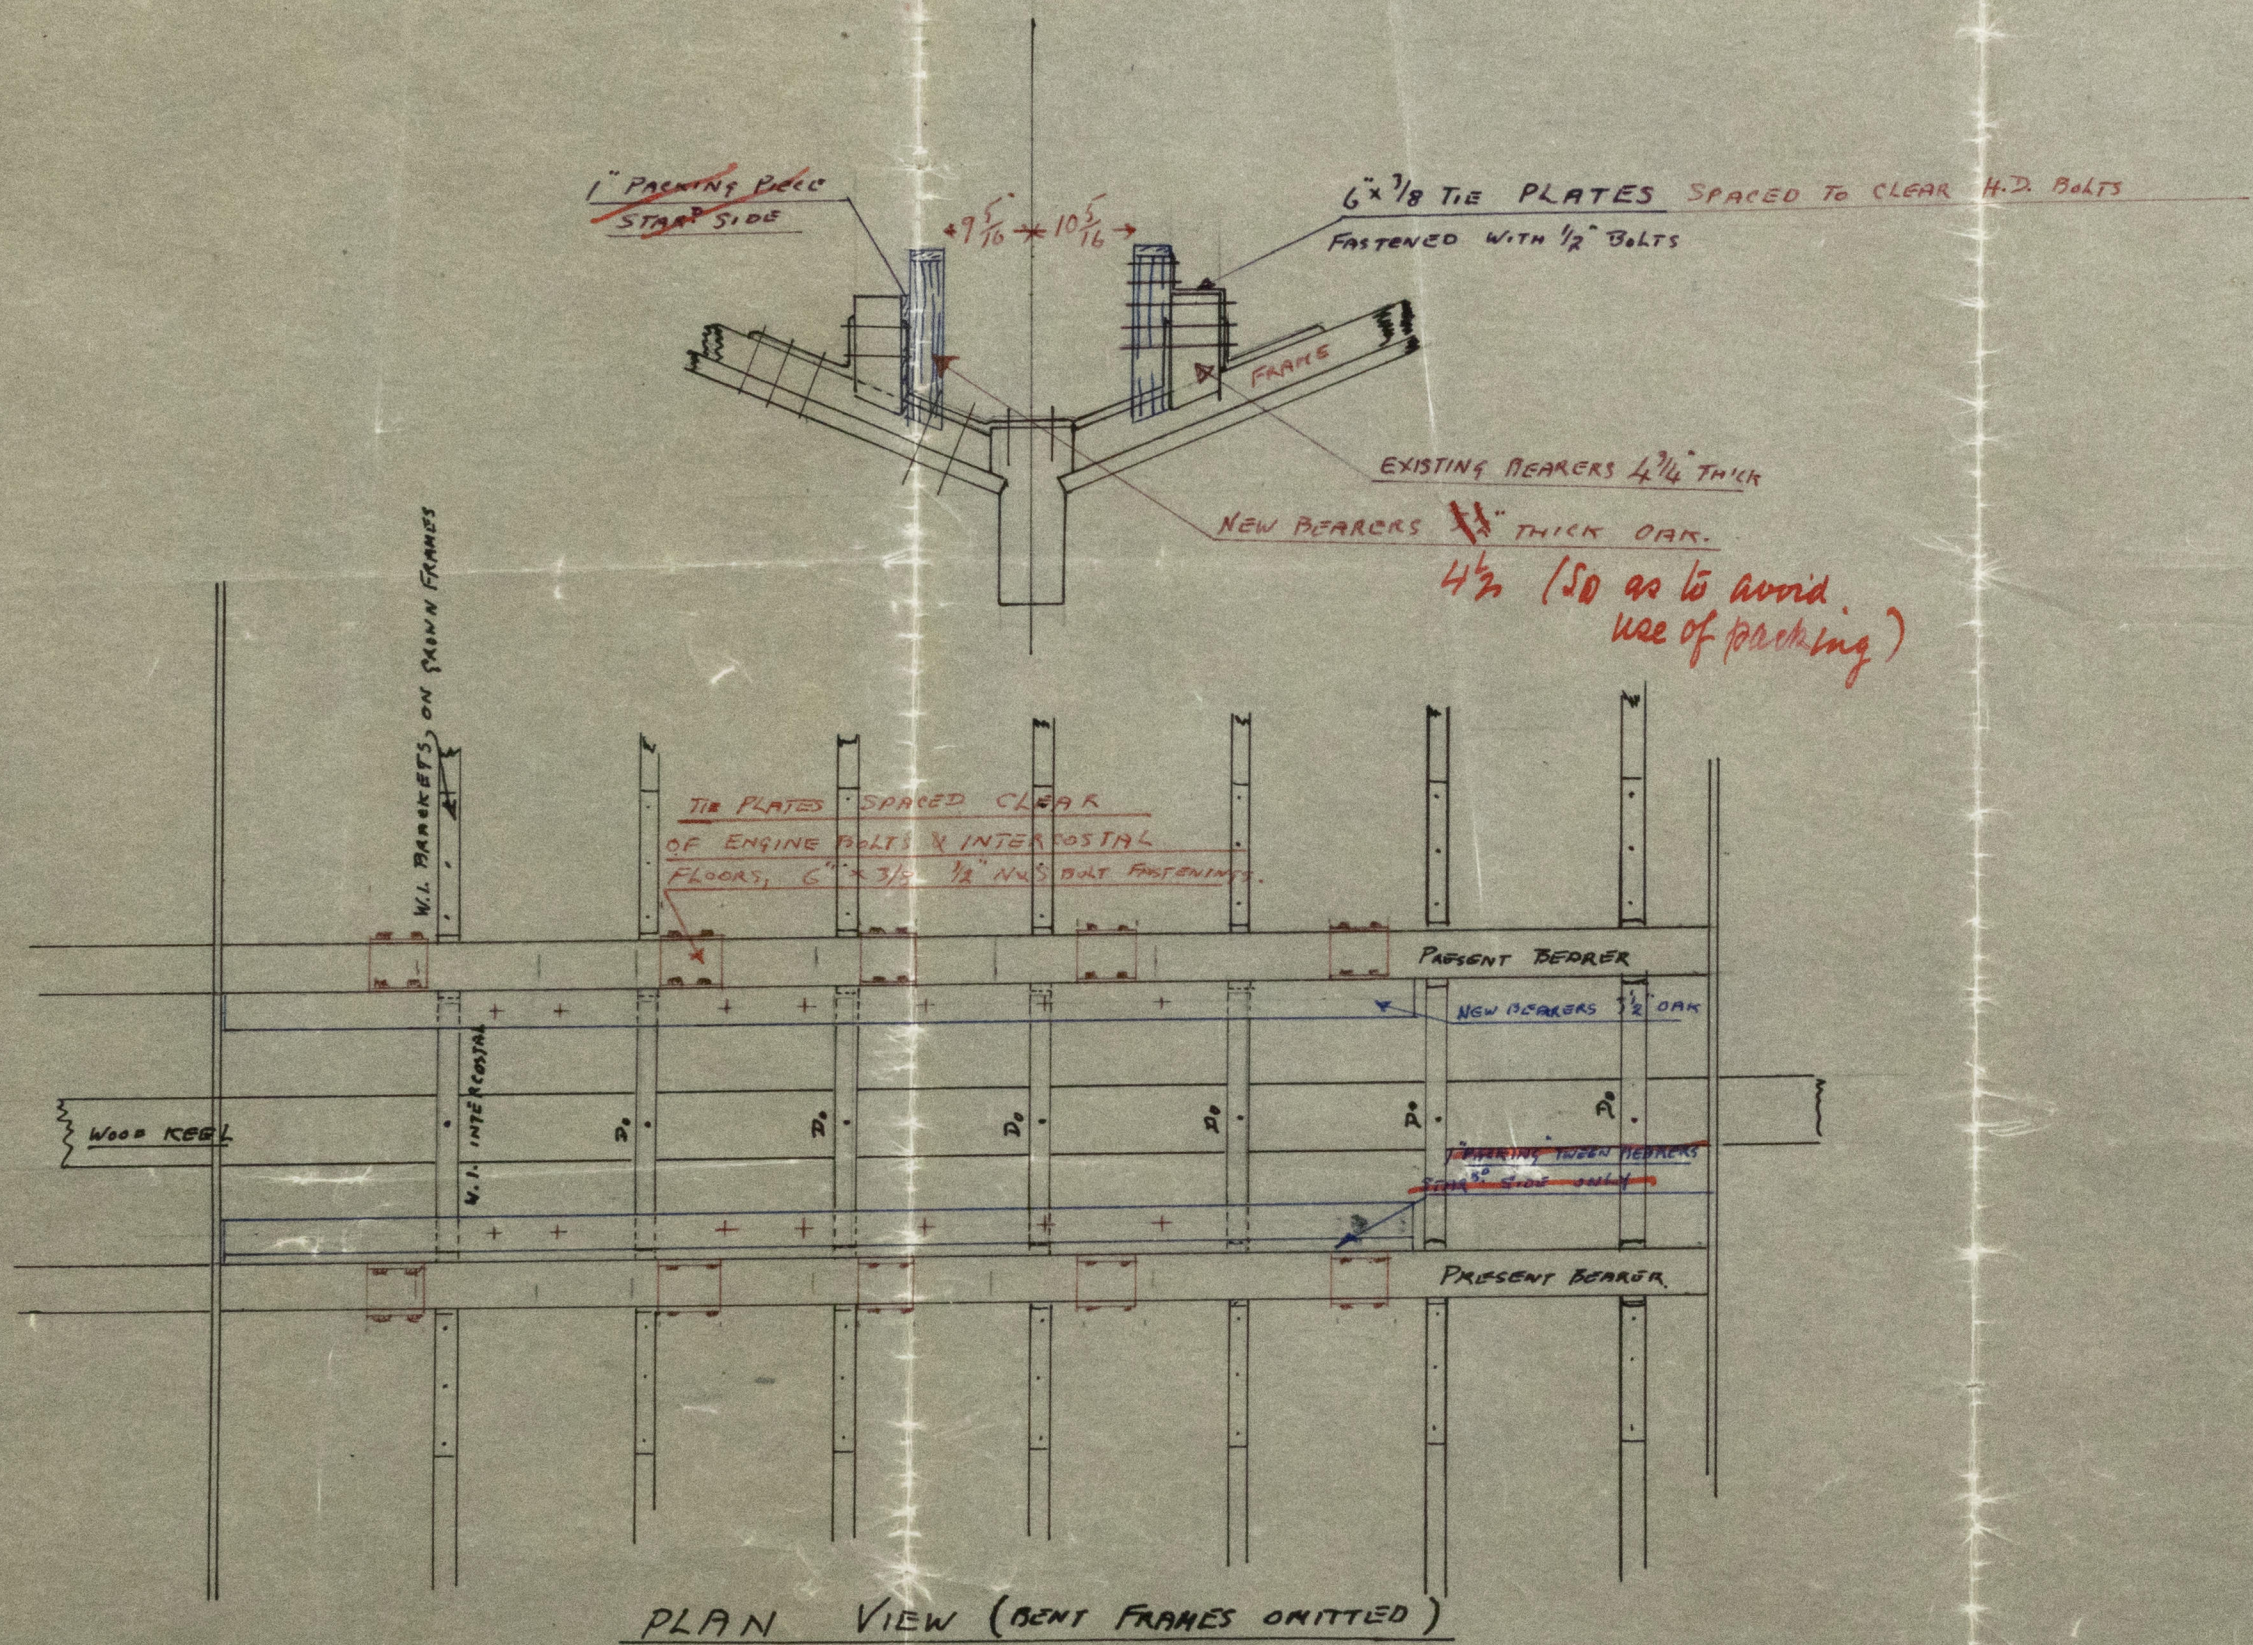


4-10-34

M.Y. LILYMAID IV  
PROPOSED SEATING FOR NEW ENGINE  
 SCALE  $\frac{1}{20}$  FULL SIZE

**LUKE BROS.**  
 YACHT, LAUNCH & BOAT  
 DESIGNERS & BUILDERS,  
 HAMBLE, Nr. SOUTHAMPTON.  
 Date 1st October 1934

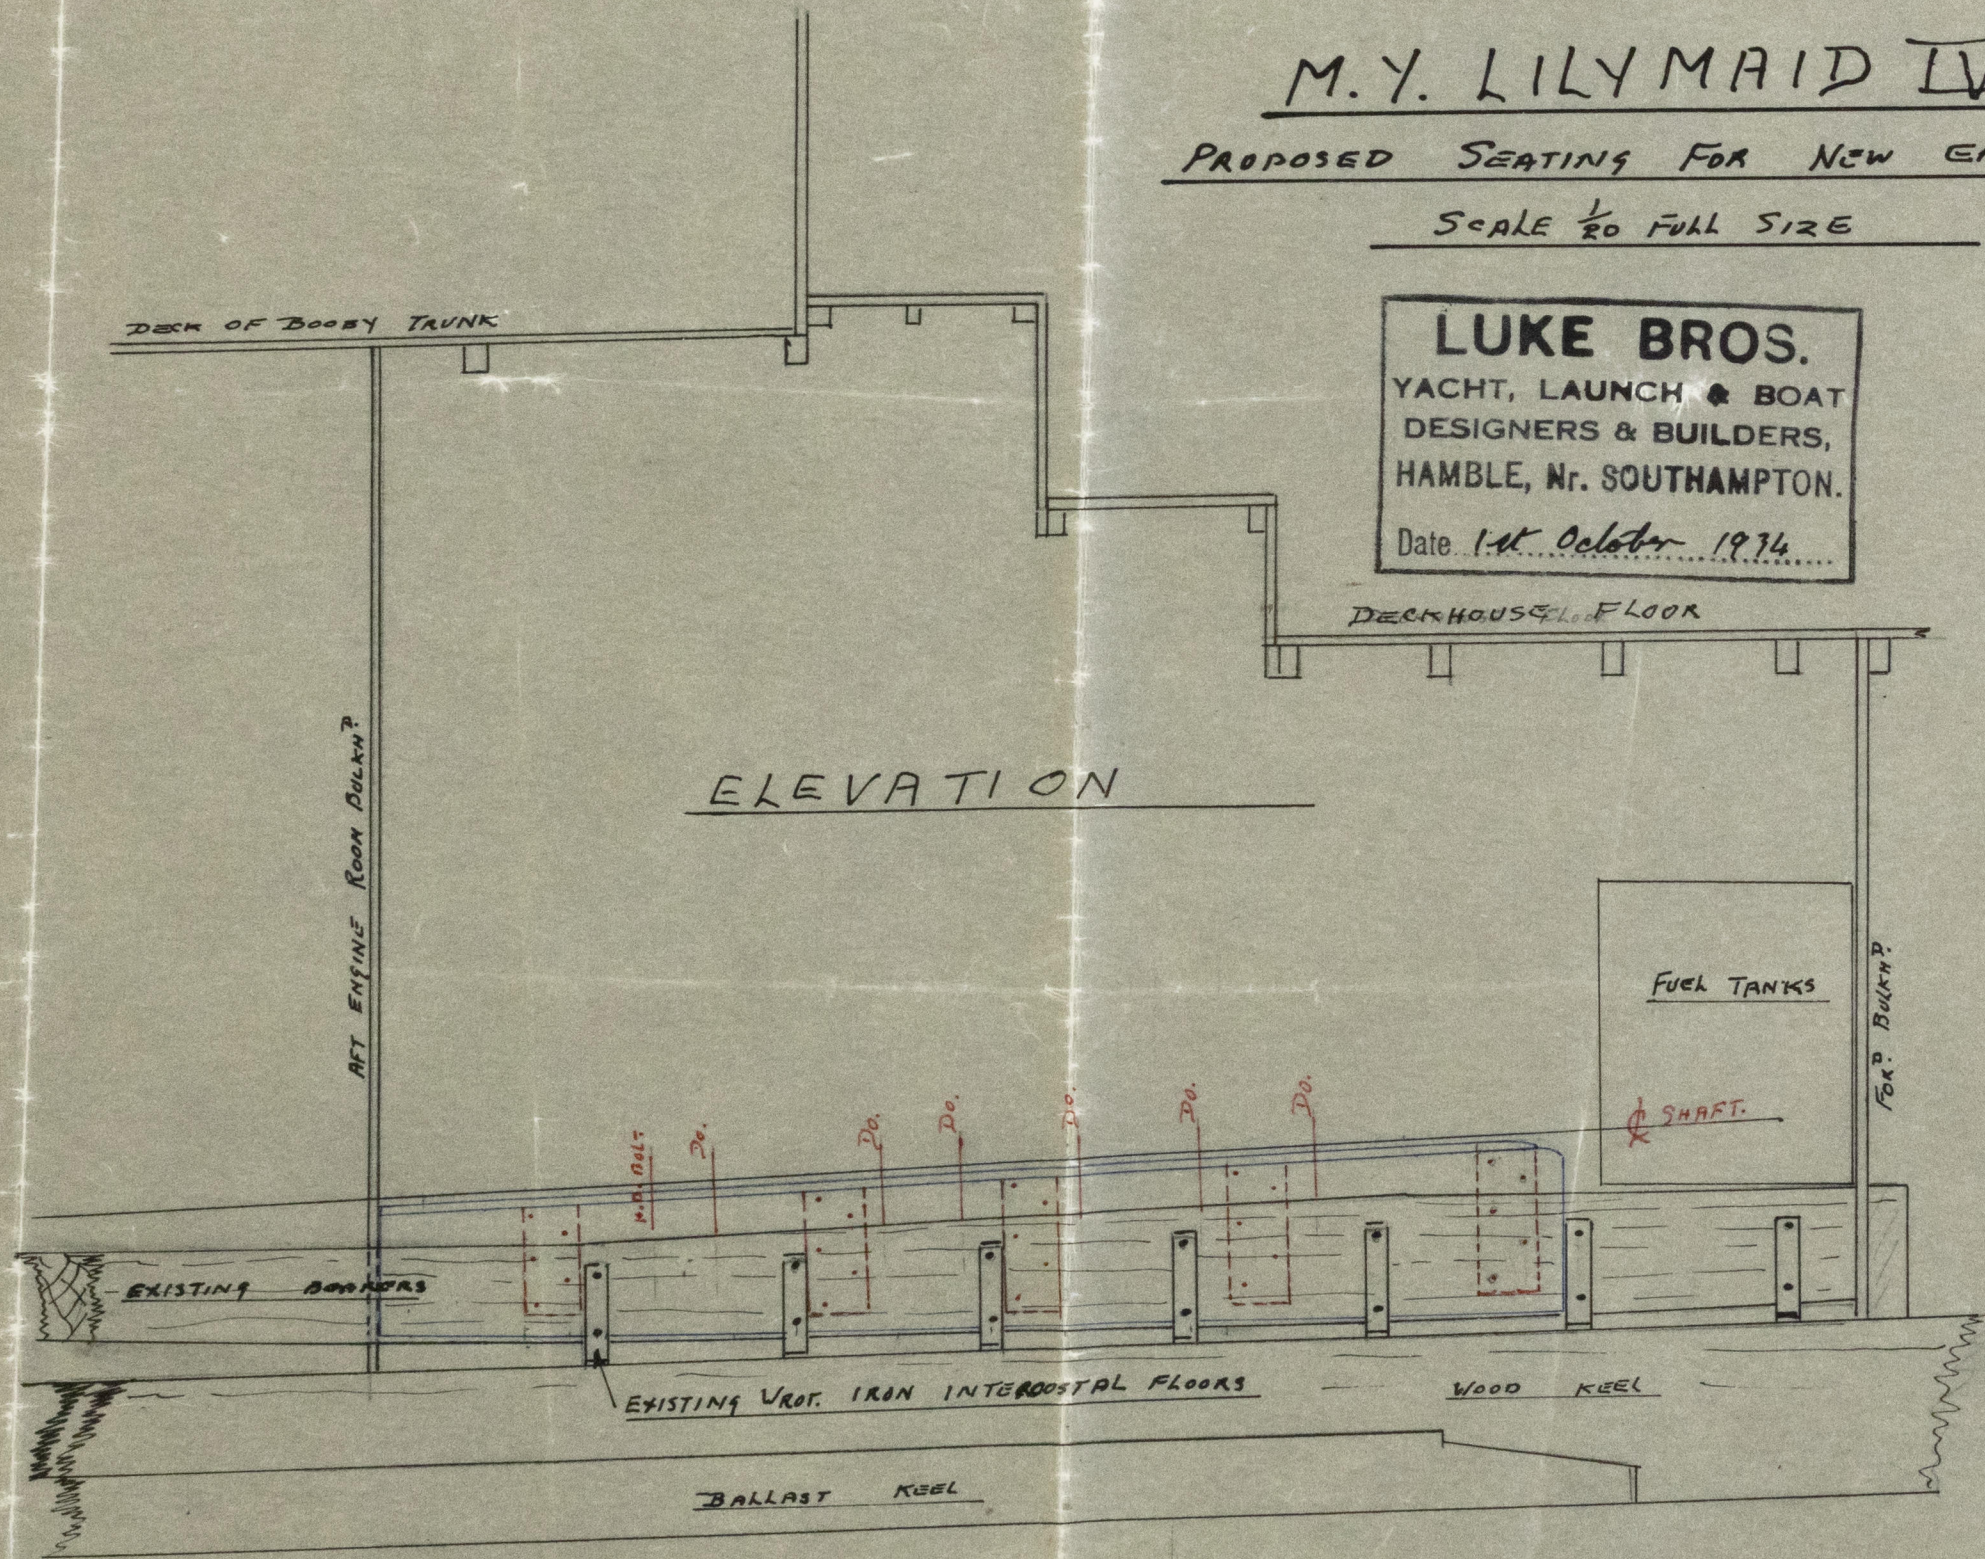

PROPOSED SEATING FOR NEW ENGINE  
 M.Y. LILYMAID IV



© 2020  
 Lloyd's Register  
 Foundation

W316-0202



Source. No. 15937.

W316-0202