

office



M.Y. LILYMAID IV

(dup copy)

PROPOSED SEATING FOR NEW ENGINE

SCALE 1/20 FULL SIZE

LUKE BROS.
YACHT, LAUNCH & BOAT
DESIGNERS & BUILDERS,
HAMBLE, NR. SOUTHAMPTON.
Date 1st October 1934

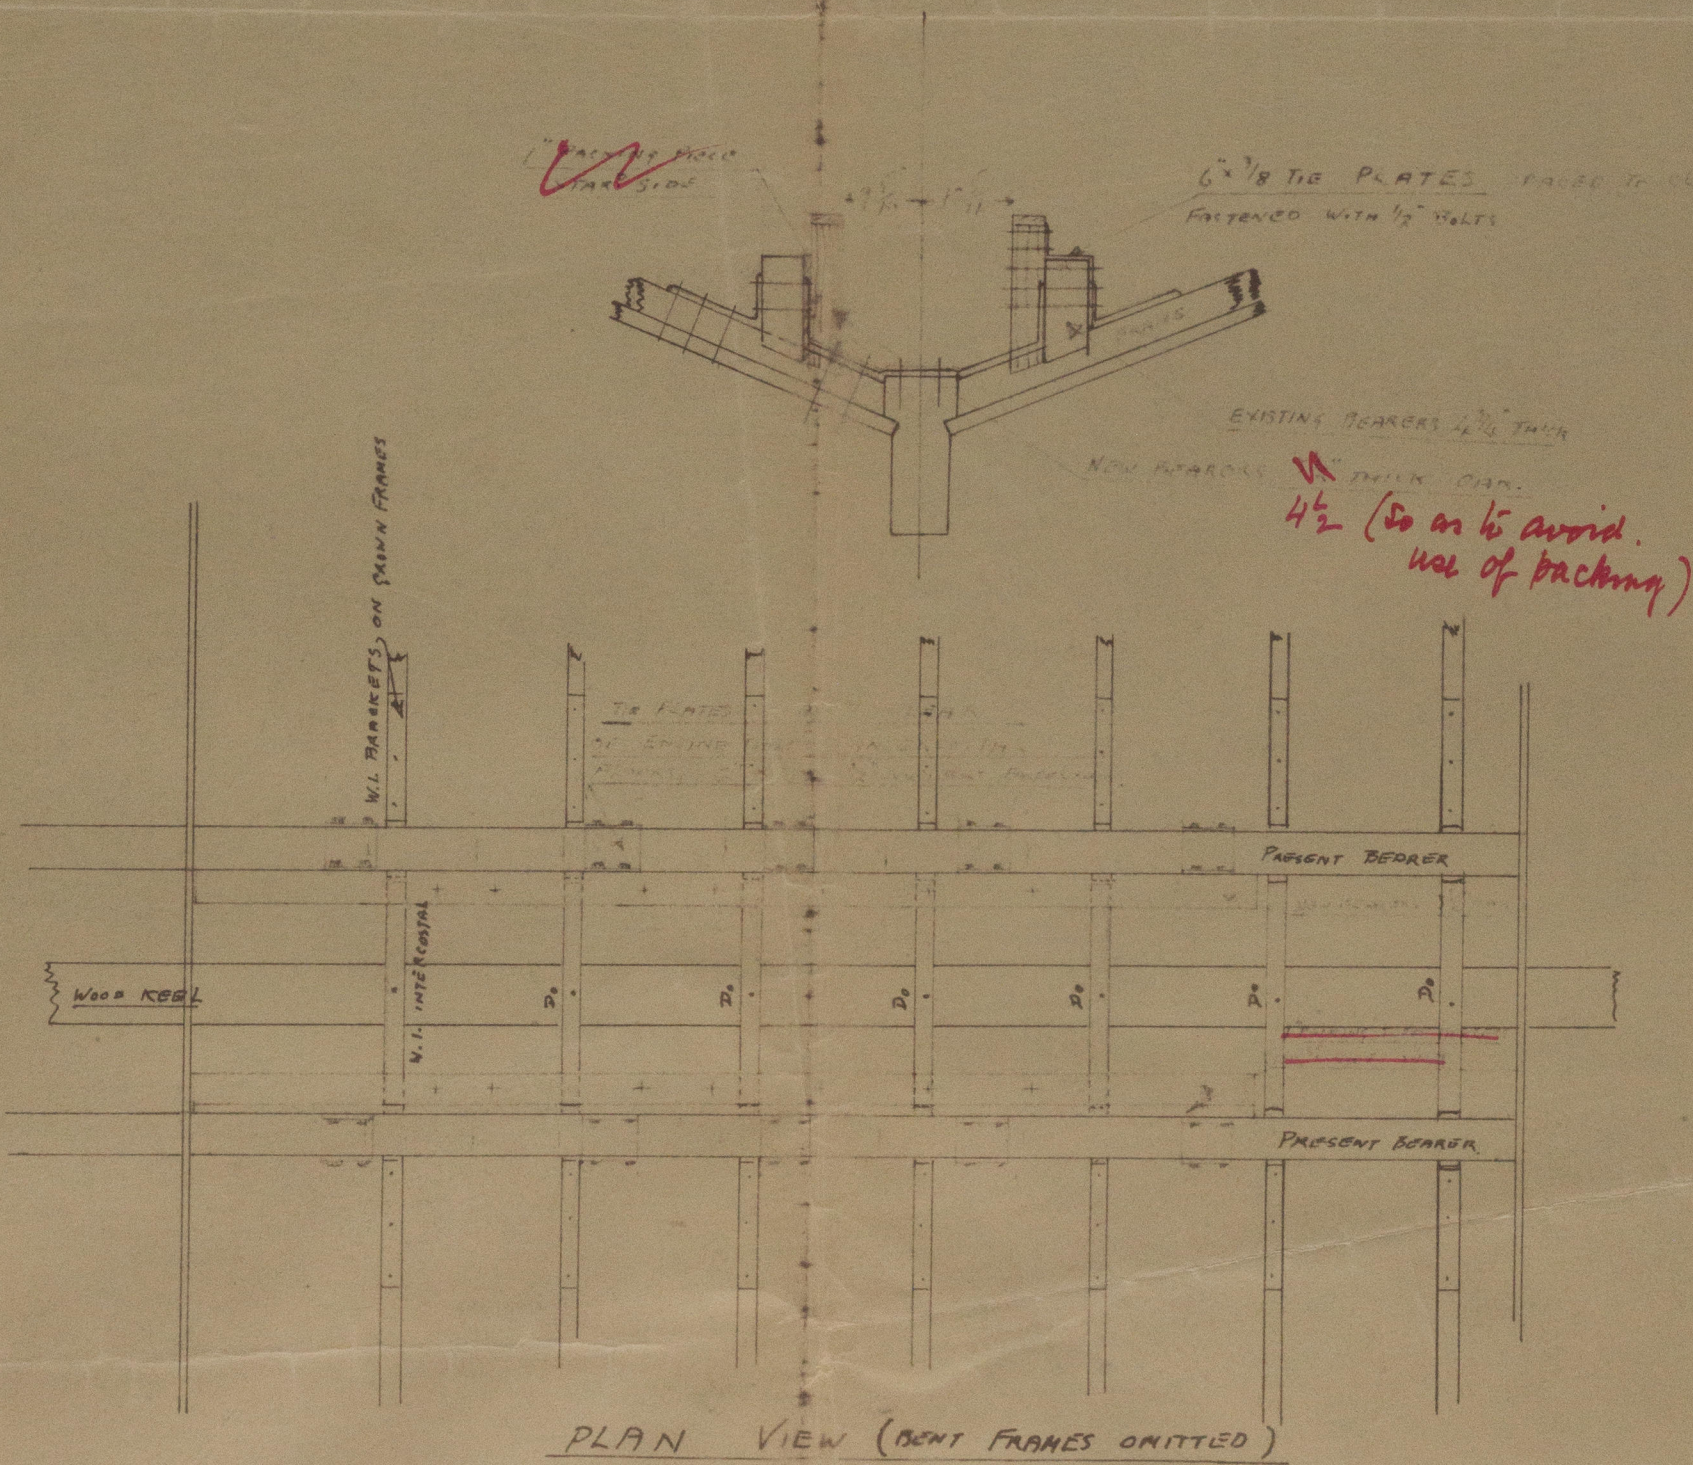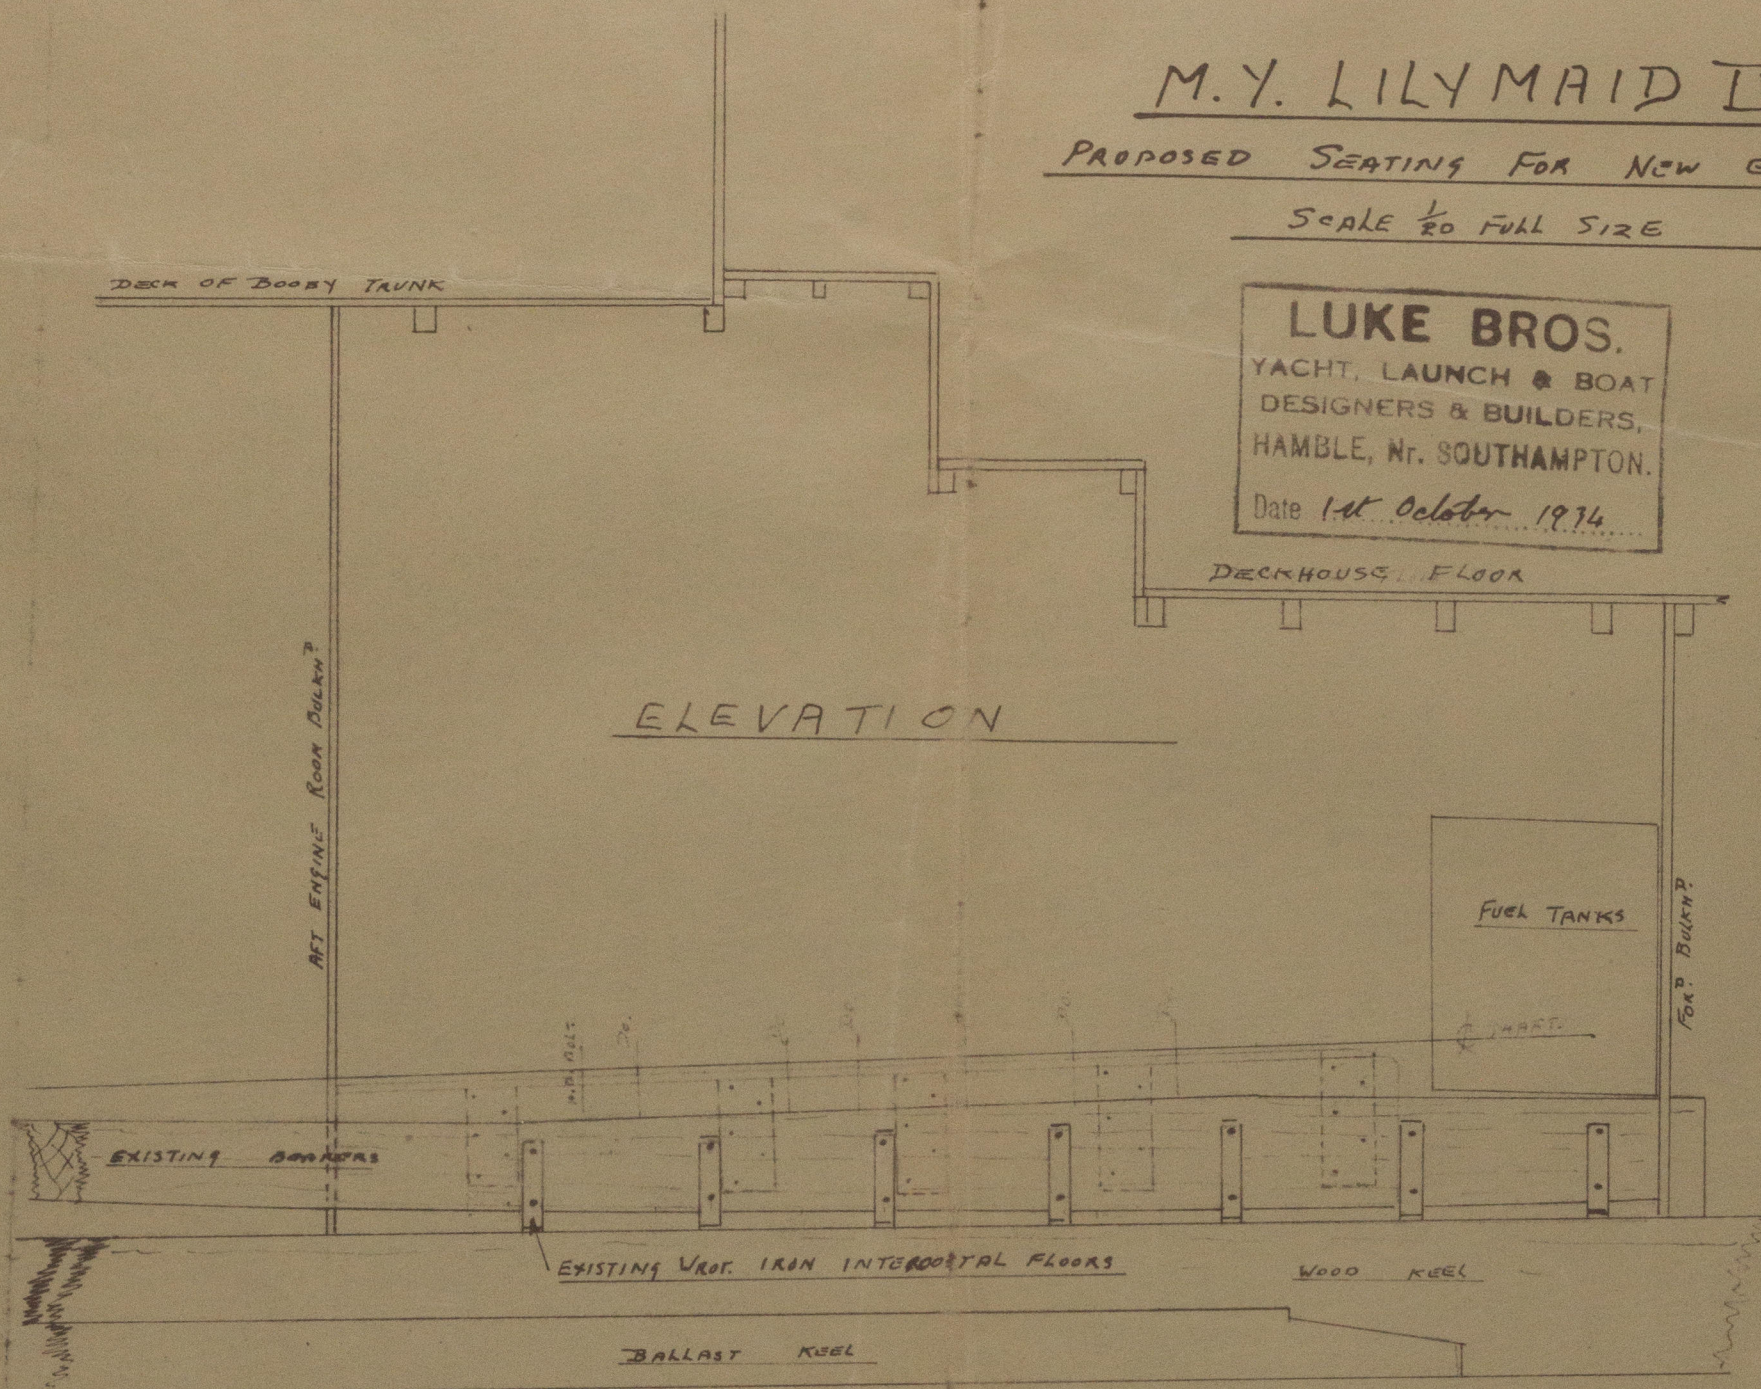

PROPOSED SEATING FOR NEW ENGINE
DRAWN IN

Yacht Lily Maid IV.

Long-upt. No. 15937

Engine Seating (dup plan)



© 2020

Lloyd's Register
Foundation

W316-0203