
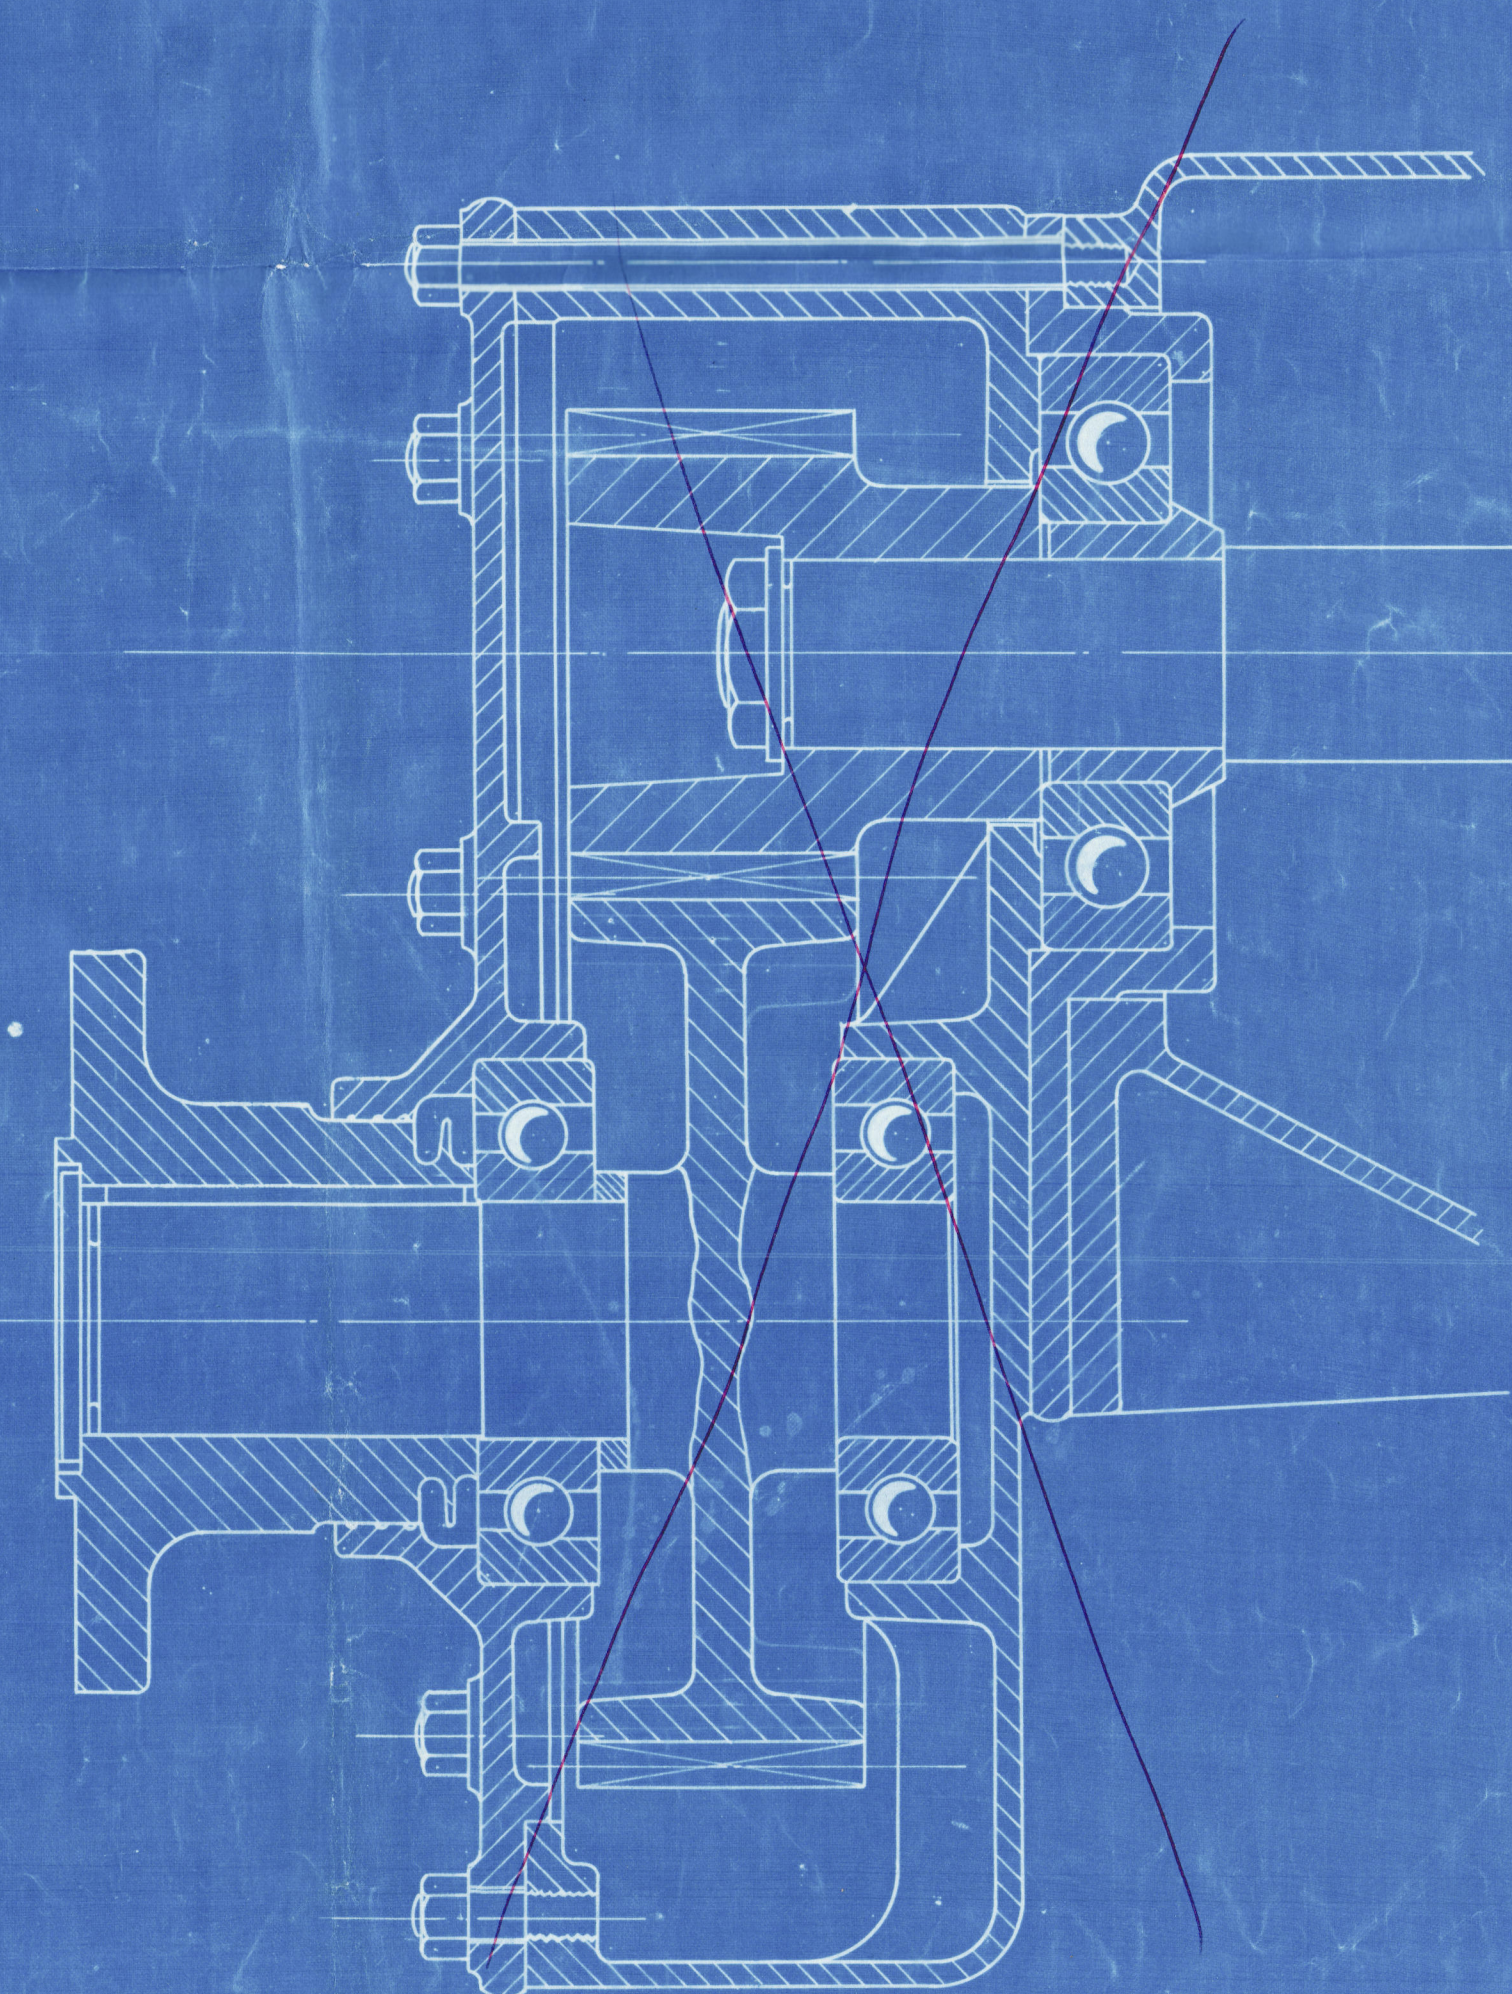


CONFIDENTIAL

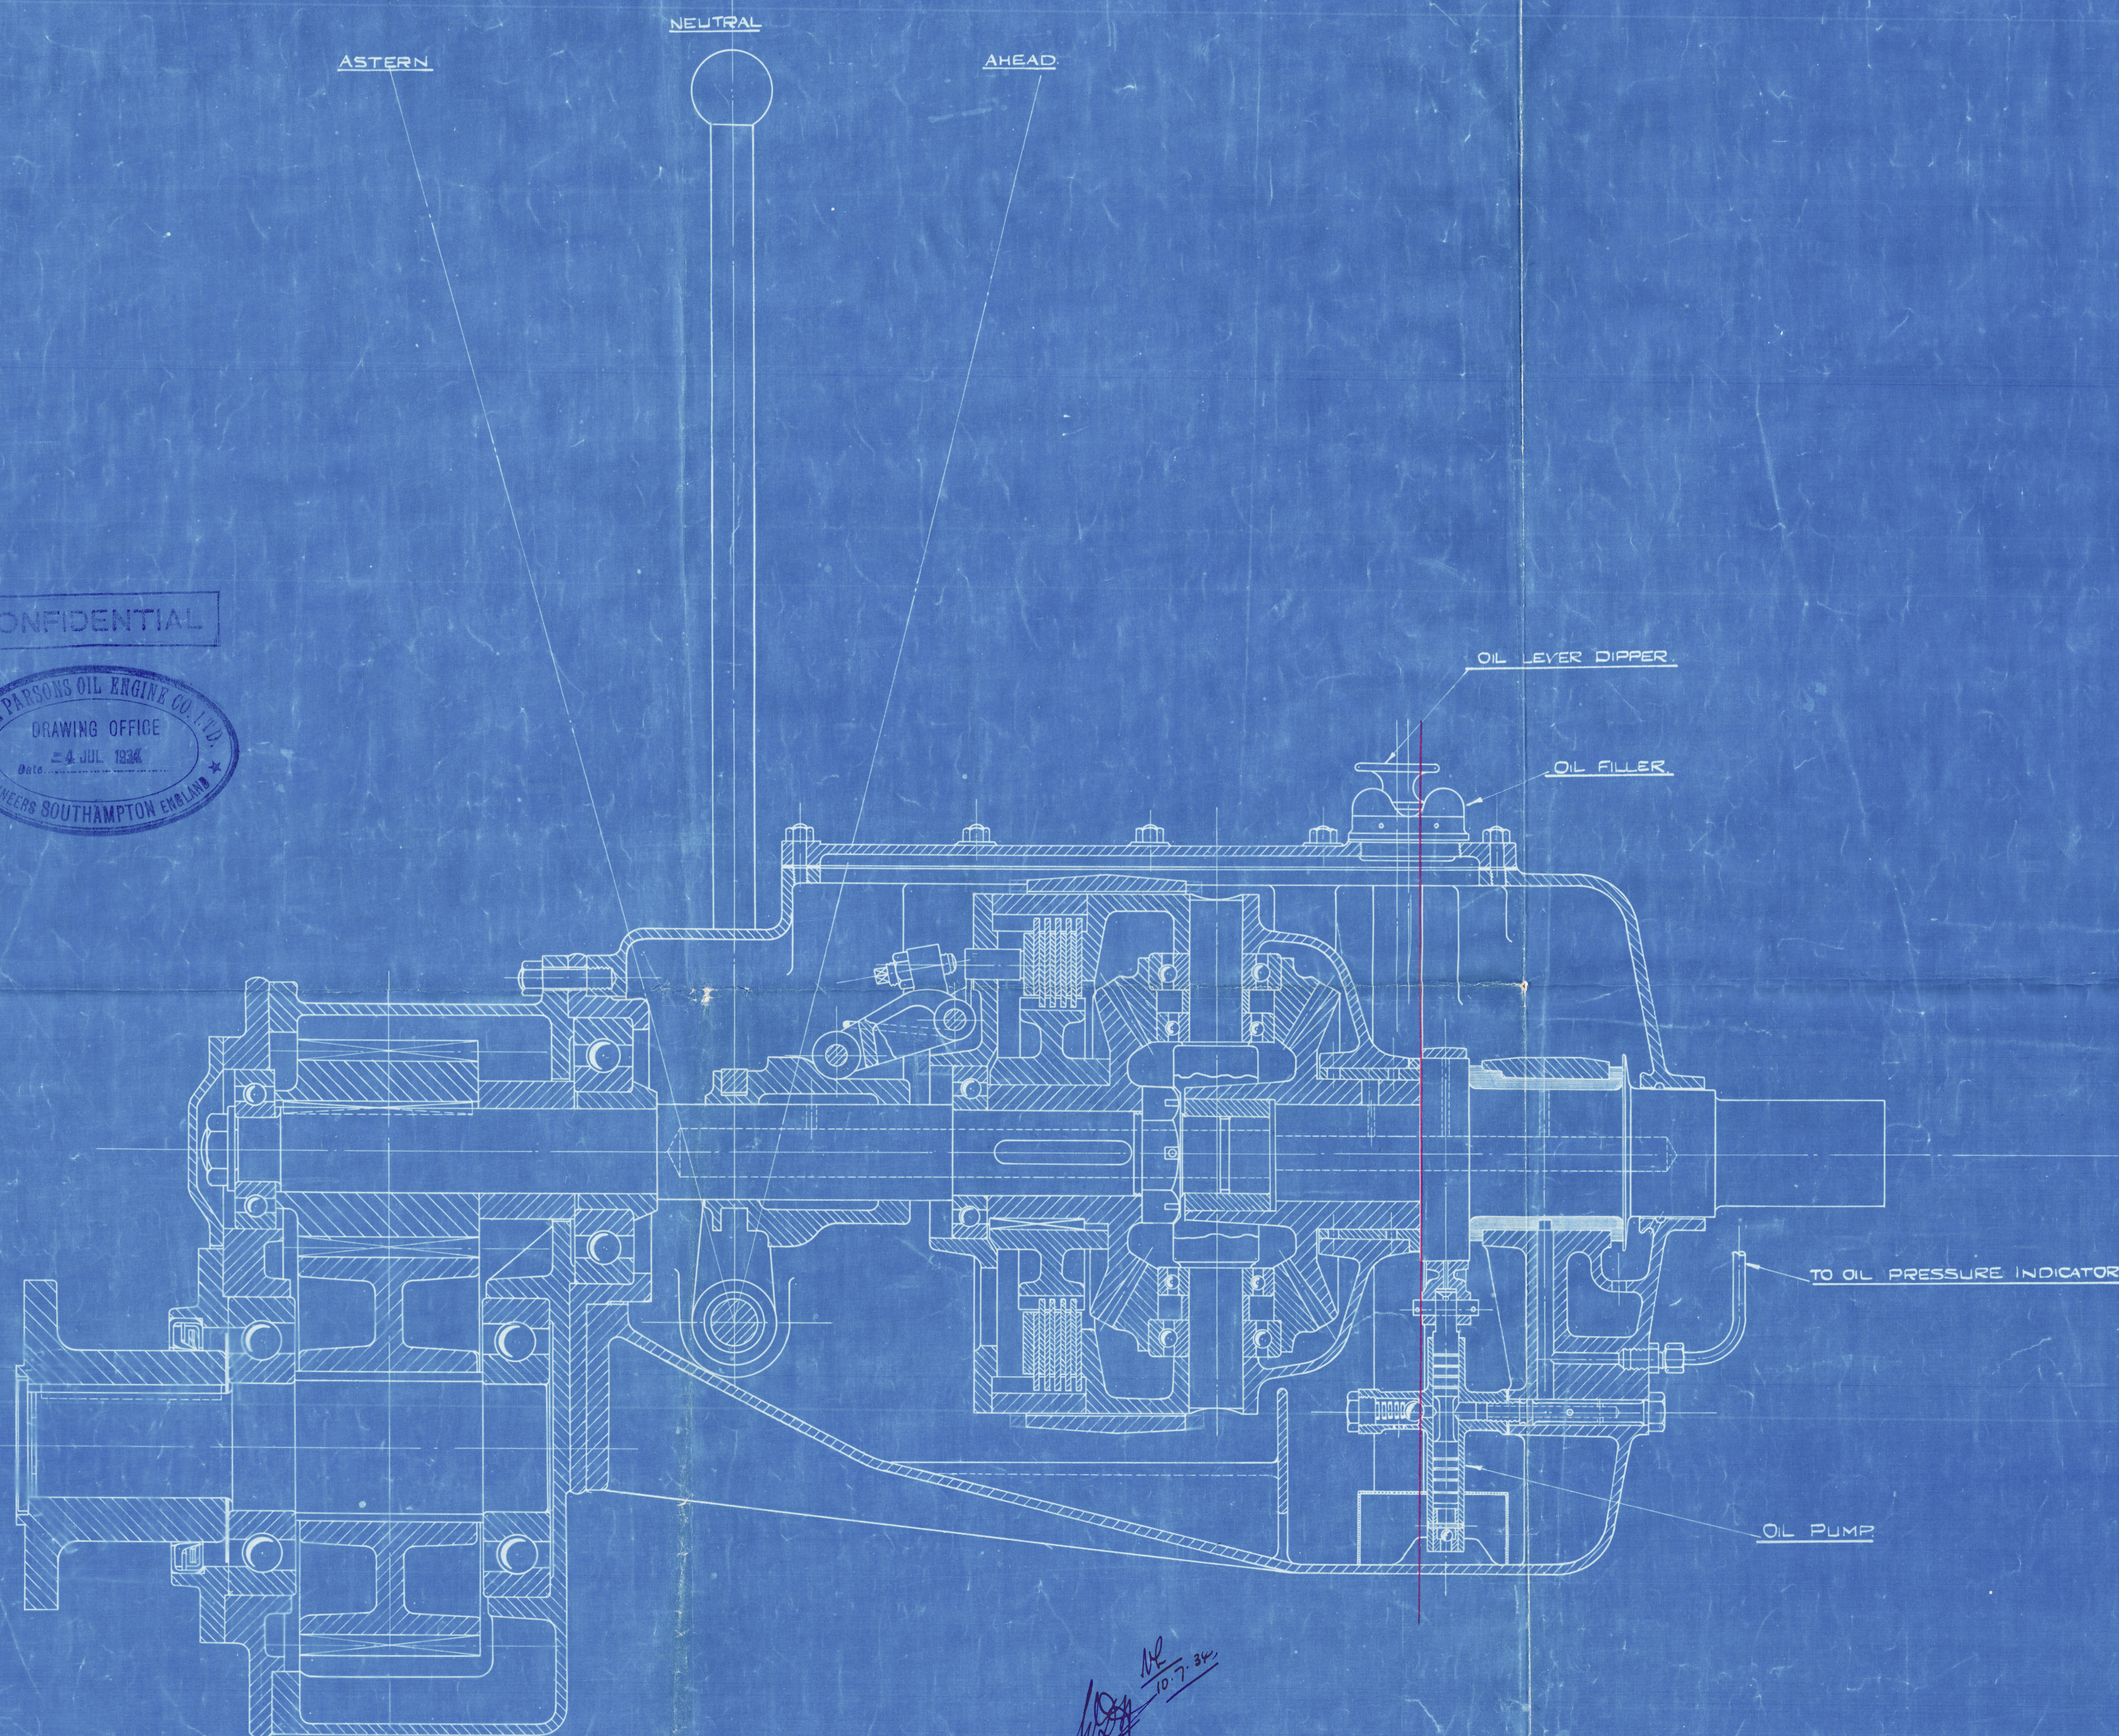

REDUCING GEAR FOR  $7\frac{1}{2}$  TO 10 BHP  
PER 100 RPM

SECTION THRO' PARSONS 'M' TYPE SELF-CONTAINED REVERSE GEAR,  
AND  
REDUCING GEARS.  
HALF SIZE

REDUCING GEAR UP TO AND INCLUDING  
 $7\frac{1}{2}$  BHP PER 100 RPM.

DRAWN BY *W.F.*  
CHECKED BY *W.F.*  
DATE 3-5-34

*W.F.*  
10-7-34

SHEET N<sup>o</sup> 1699

Lily 171012  
REVERSE GEAR  
5.7.34  
DRG. No. 6163.  
© 2020  
Lloyd's Register  
FOLIO 1699  
W316-0208 72



The Parsons Oil Engine Co. Ltd.

2/14  
For Enclosure to Messrs

Date

J. McMillen Esq

4 7/2 34


2/2



Yacht Lily Maid TV

Don. rept. No. 15937.

Section through reverse gear &  
~~transmission~~ reducing gear.

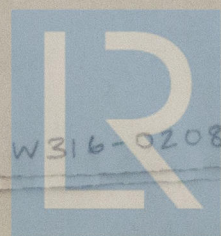

W316-0208

© 2020

Lloyd's Register  
Foundation