

25-1-04
4-5-04

NUMERALS
2 BREADTH 13.75
DEPTH 16.82
3 GIRTH 25.90
2 N 36.00
TRANSVERSE NUMERALS
218.5
46280
74048
9256
18512
20224-360
1-598
161702
182016
101120
20224
LONG NO 32,317.952 ✓

TURBINE STEAM YACHT

SCALE 1/2 INCH

DIMENSIONS 210-0 L.W.L. x 24-6 x 16-2 1/2 M³ AT 1/2 LLOYDS LENGTH

SECTION AT 1/2 LLOYDS LENGTH



TO CLASS 100 A-1 & TO BE BUILT UNDER SPECIAL SURVEY

EQUIPMENT NUMBERS

TOTAL LENGTH OF ERECTIONS 117' x 7.5' = 11.53
TRANSVERSE N° 92-56 x LENGTH 216.5 = 20.224
EQUIPMENT N° 21.979

EQUIPMENT




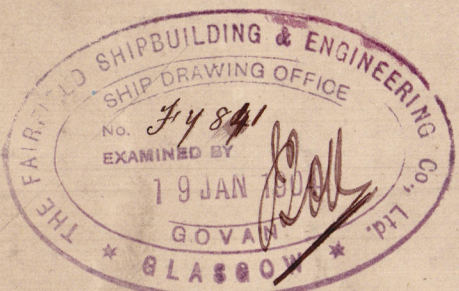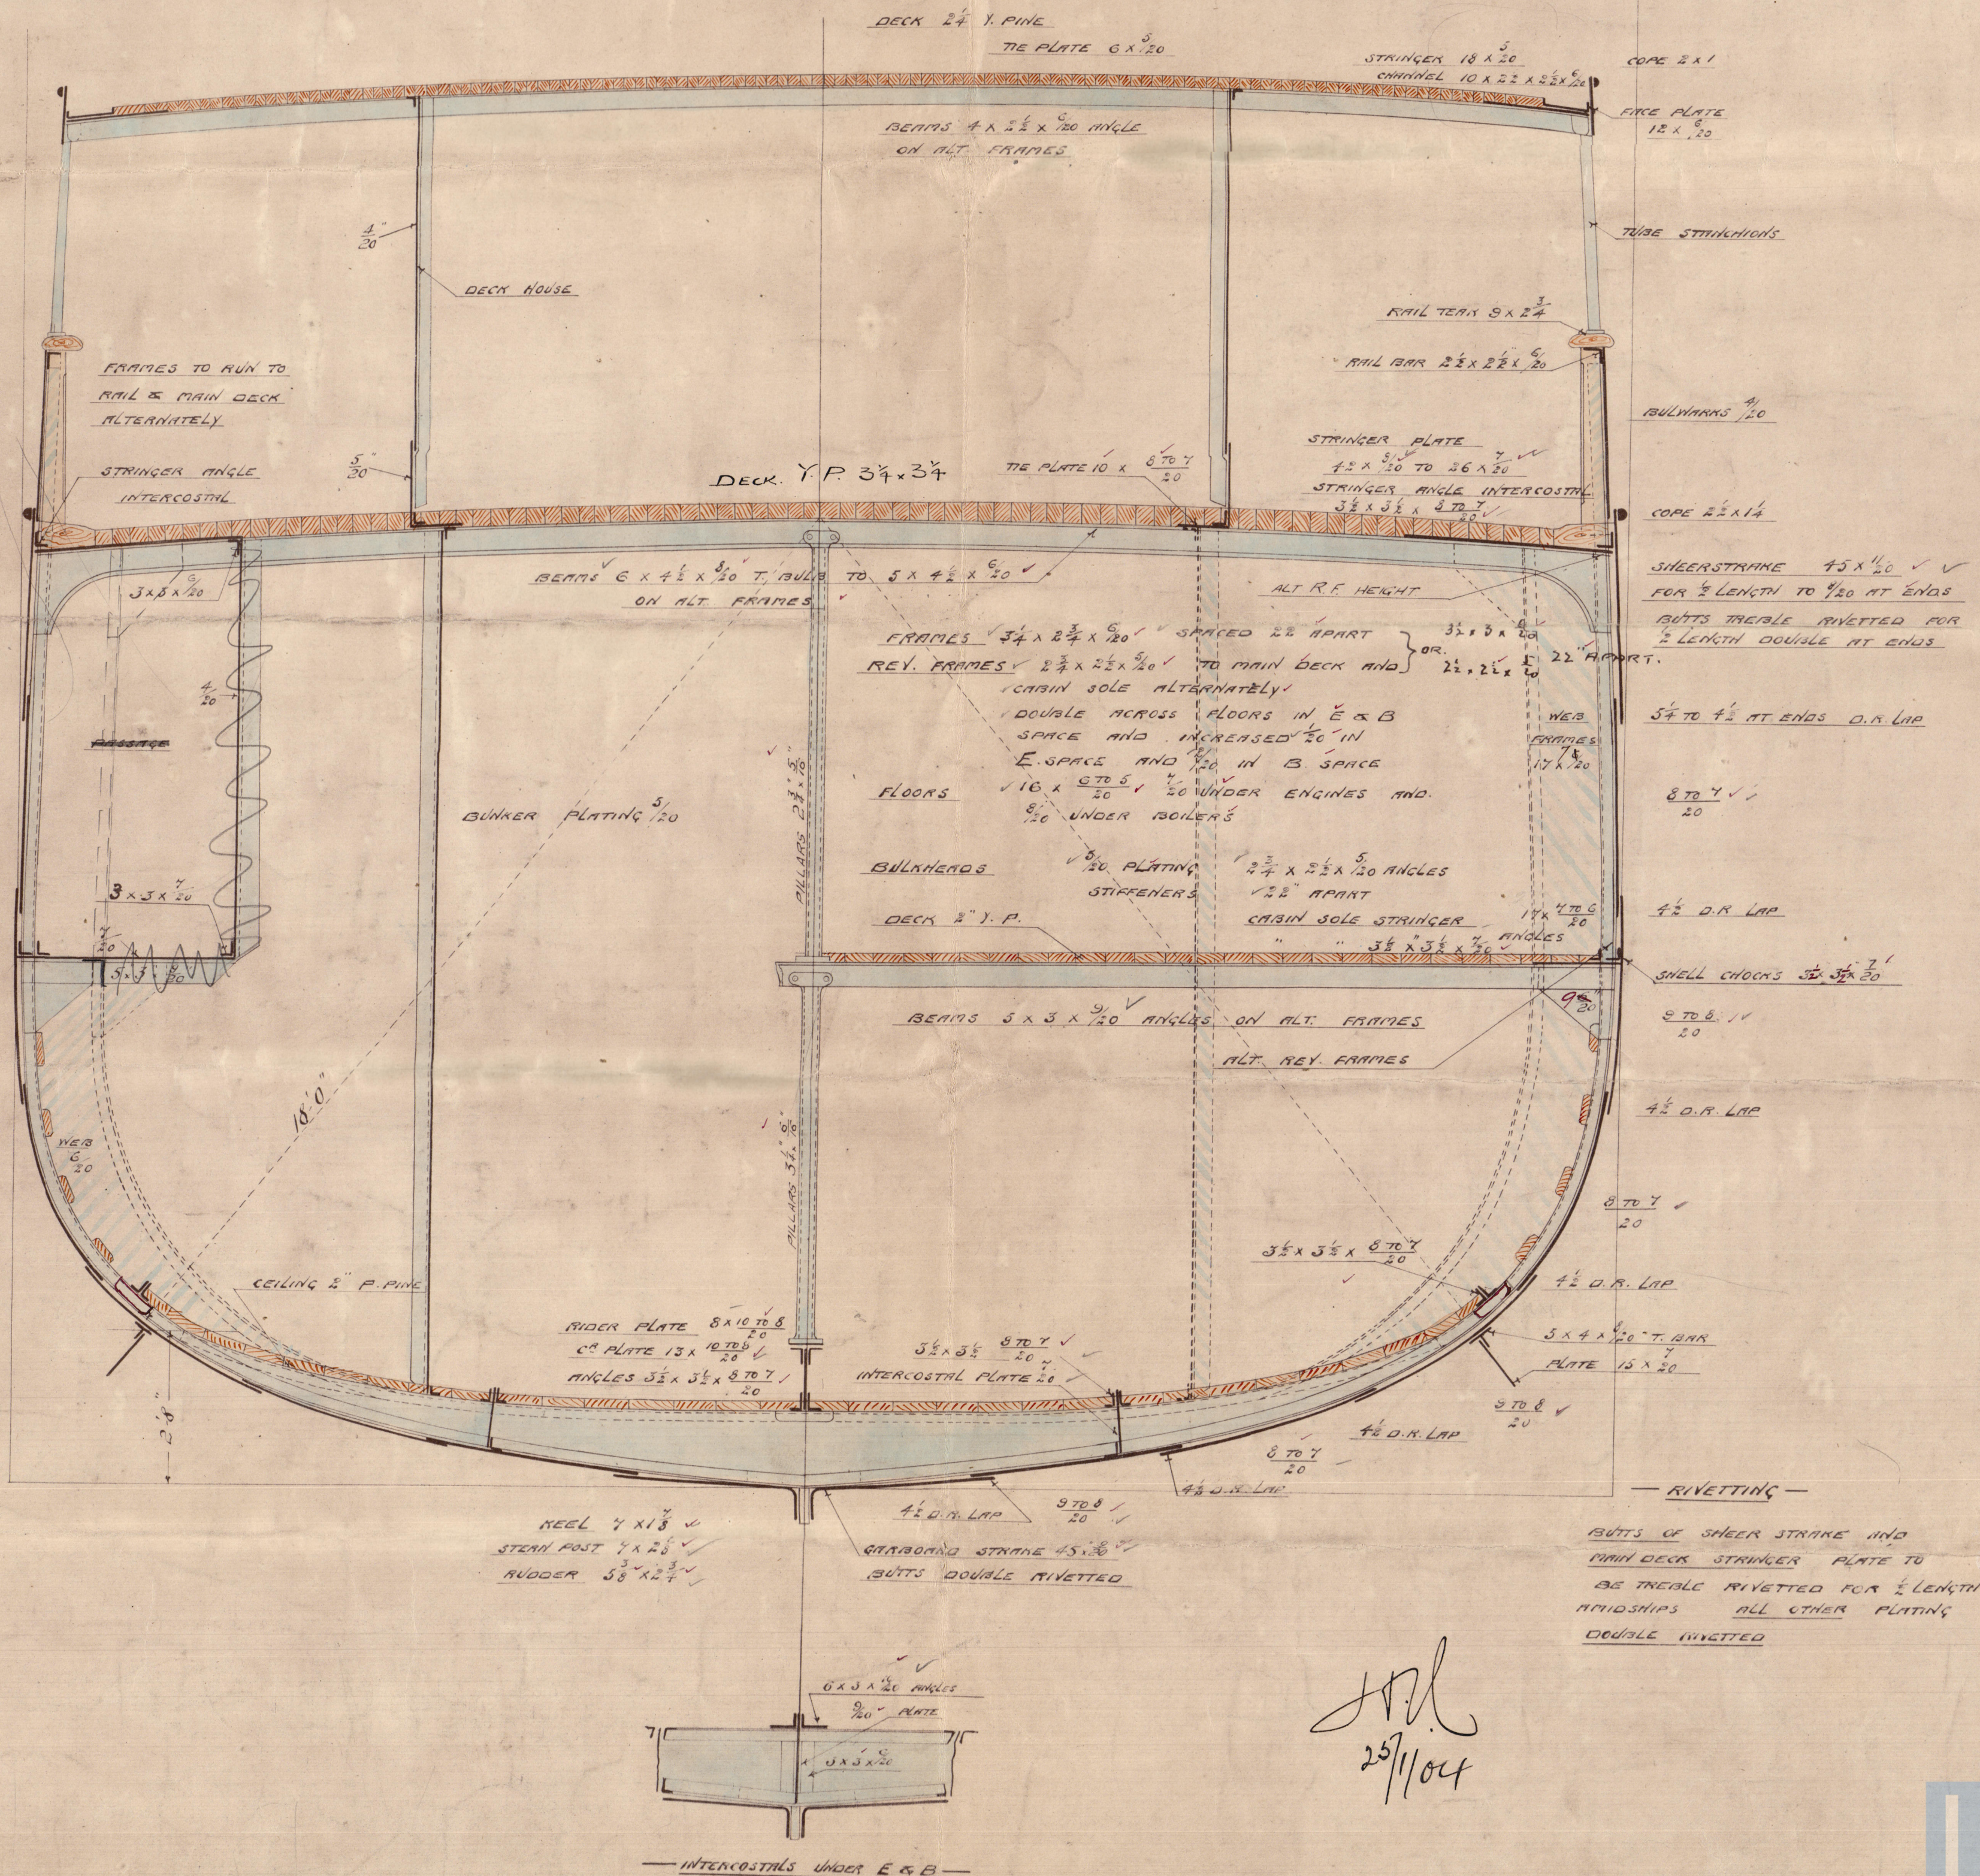

Lloyds

23/1/04


Fairfield S.B. & Co
St Turbine Yacht
No 437
Midship Section
(amended)

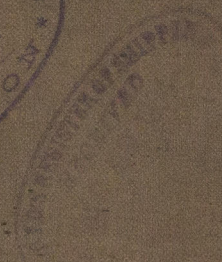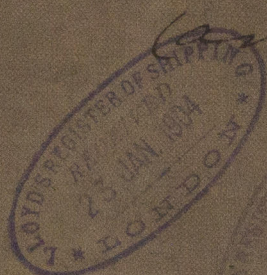

Grive Gb 22597.
"ex
"Narcissus"

~~Glasgow r/h No. 22597~~

St. 7027.

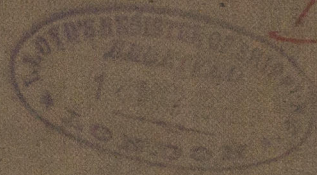

© 2020

Lloyd's Register
Foundation

W 316 - 0263